

39° 30' 00"

Latitude ✓

80° 37' 30"

Longitude

Topo Location

7.5' Loc. 0.015 15' Loc. 0.015
0.81W (calc.) 3.04W

Company Quaker State Corp.
Farm John Mills # 130
15' Quad Center Point (NC)
(sec.)
7.5' Quad Center Point
District Grant

was 172756

WELL LOCATION PLAT


County 103 Permit 1610N

INSTRUCTIONS

LATITUDE 39° 37' 30" (70'S)

LONGITUDE 80° 37' 30" (4350' W)

1) Attach a photo copy of the location of the well on a 7.5 minute Quadrangle with the corresponding Longitude and Latitude.
 2) Designate the location of the well with the symbol(+).

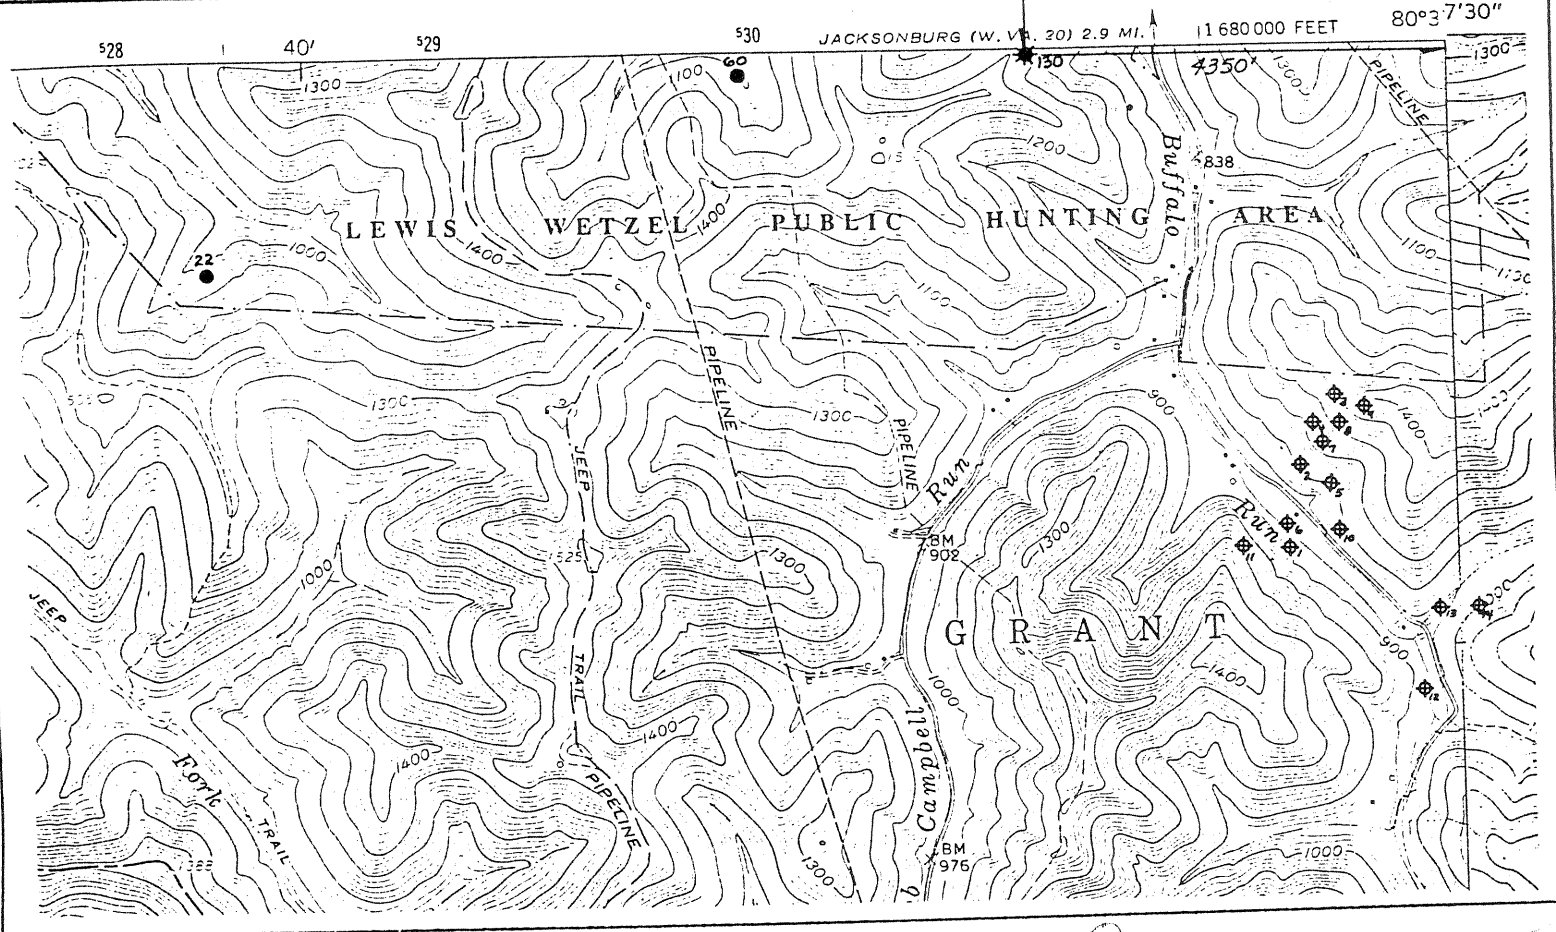


I, the undersigned, Hereby certify that this plat is correct to the best of my knowledge and belief.

SIGNED *Quaker Corp*
 TITLE District Manager

18528

DATE November 19, 1993
 OPERATORS WELL NO. Mills #130
 API WELL NO. 47-103-1609-N

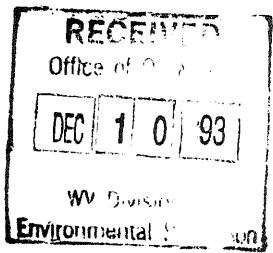

STATE OF WEST VIRGINIA
 DEPARTMENT OF ENERGY
 OIL AND GAS DIVISION

WELL TYPE: OIL GAS LIQUID INJECTION WASTE DISPOSAL
 (IF "GAS" PRODUCTION STORAGE DEEP SHALLOW
 LOCATION: ELEVATION 1097' WATER SHED Buffalo Run
 DISTRICT Grant COUNTY Wetzel
 QUADRANGLE Center Point
 SURFACE OWNER John Mills ACREAGE 5451
 OIL & GAS ROYALTY OWNER N/A LEASE ACREAGE _____
 LEASE NO. _____
 PRODUCING FORMATION Gordon Sand TOTAL DEPTH 3041'
 WELL OPERATOR Quaker State Corporation DESIGNATED AGENT Frank Rotunda
 ADDRESS 1226 Putnam Howe Drive ADDRESS P.O. Box 823
Belpre, OH 45714 Parkersburg, WV 26102

STATE OF WEST VIRGINIA
DIVISION OF ENVIRONMENTAL PROTECTION
SECTION OF OIL AND GAS

WELL REGISTER ASSIGNMENT

This API Number 47-103-01610, issued to QUAKER STATE CORPORATION is evidence of permission to operate the well that is referenced at the location described on the attached plat, subject to the provisions of Chapters 22 and 22B of the West Virginia Code of 1931, as amended, and all rules and regulations promulgated thereunder. The name and telephone number of the Oil and Gas Inspector for this well is RANDAL MICK -
304-986-3324.

Spills or emergency discharges must be reported to 1-800-654-3312.

Failure to abide by all statutory and regulatory provisions governing all duties and operations hereunder may result in suspension or revocation of your permits and in addition may result in civil and/or criminal penalties.

The enclosed WR-35 must be completed by you and returned to this office. In addition annual production reports must be submitted on this well and failure to do so may require you to plug the well.

Theodore M. Streit
Chief

By: 

Title: _____

Operator's Well No: MILLS #130

Farm Name: MILLS, JOHN

API Well Number : 47-103-01610 N

Date Issued : 03/10/94