


19,500'

LATITUDE 39° 42' 30"

LONGITUDE 80° 42' 30"

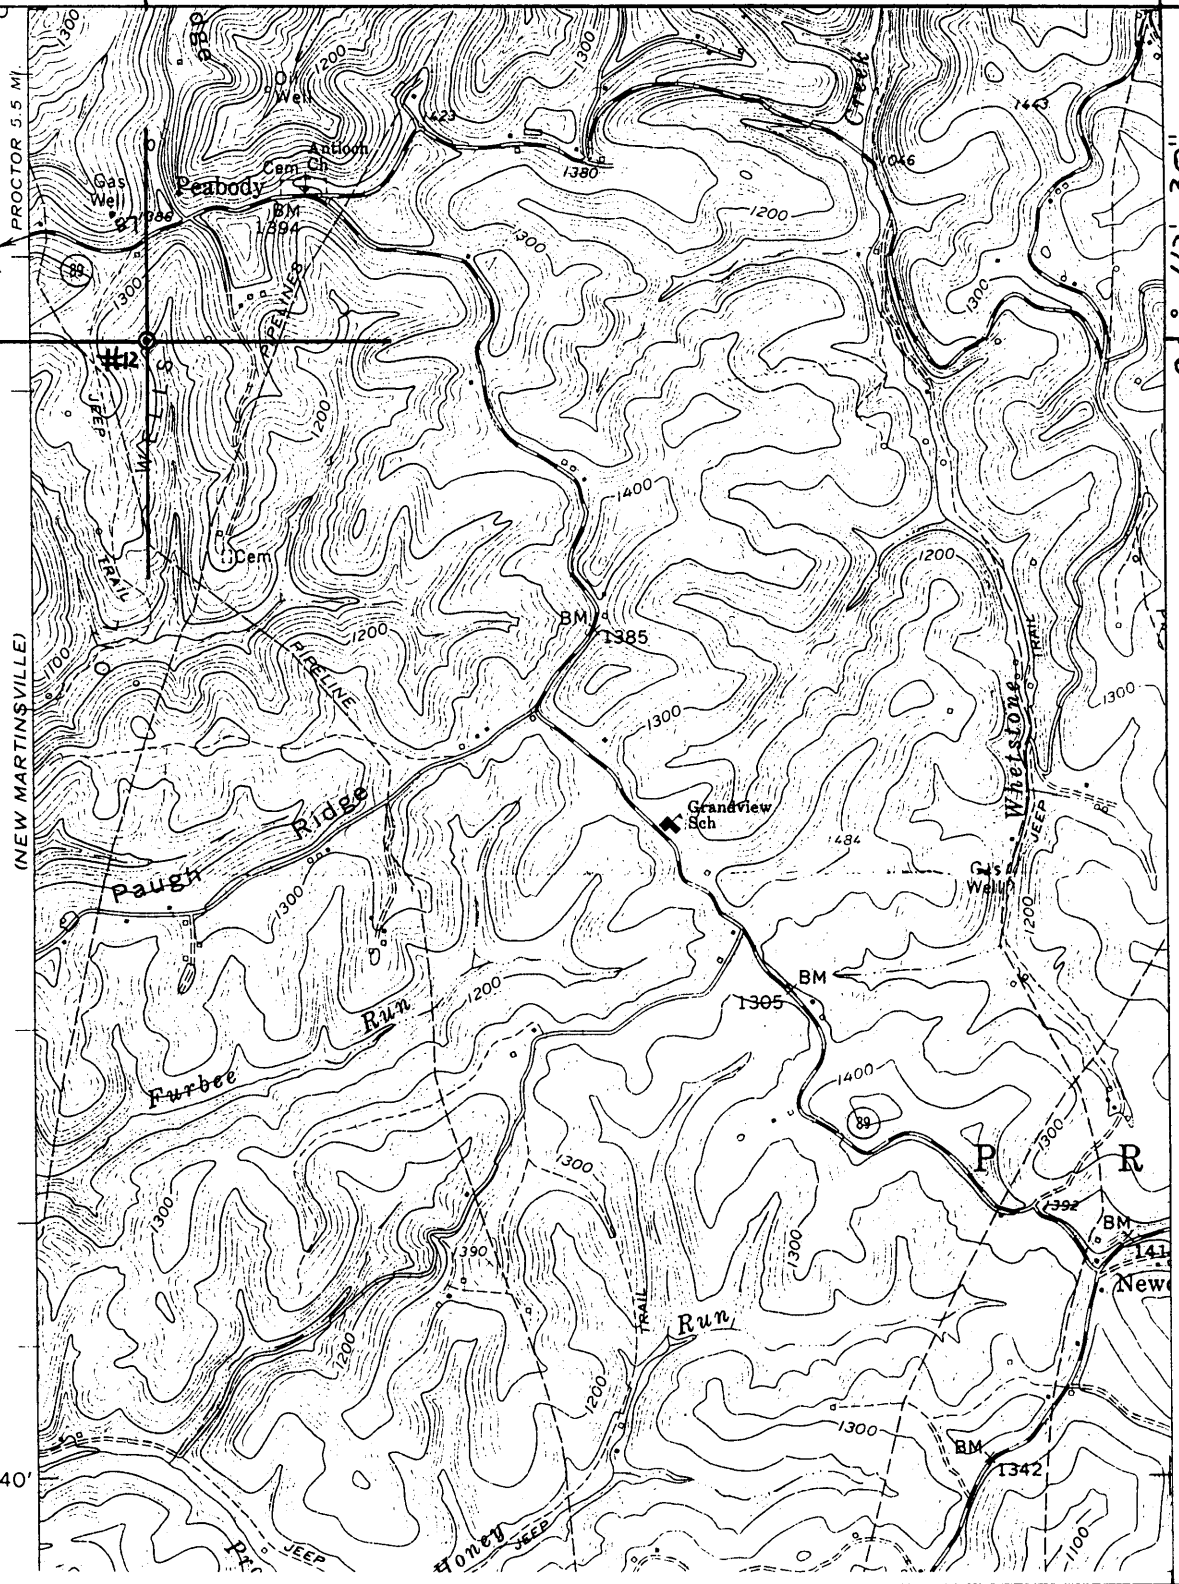

20488

I THE UNDERSIGNED, HEREBY CERTIFY THAT THIS PLAT IS CORRECT TO THE BEST OF MY KNOWLEDGE AND BELIEF.

SIGNED *Deryl Perkins*  
 TITLE Deryl Perkins - VICE PRESIDENT

STATE OF WEST VIRGINIA  
 DIVISION OF ENVIRONMENTAL PROTECTION  
 OFFICE OF OIL AND GAS

DATE March 27, 19 95  
 FARM Al & Henry Garner NO. 12  
 API WELL NO.  
47-103-1662-N

WELL TYPE: OIL  GAS  LIQUID INJECTION  WASTE DISPOSAL   
 (IF "GAS") PRODUCTION  STORAGE  DEEP  SHALLOW   
 LOCATION: ELEVATION 1210 Topo WATERSHED Proctor Creek  
 DISTRICT Proctor 7 COUNTY Wetzel  
 QUADRANGLE Wileyville 681

SURFACE OWNER Unknown ACREAGE ?  
 OIL & GAS ROYALTY OWNER Unknown LEASE ACREAGE 323.5 Ac.

LEASE NO. \_\_\_\_\_  
 PRODUCING FORMATION Gordon TOTAL DEPTH 2900 +/-

WELL OPERATOR Perkins Oil & Gas DESIGNATED AGENT Deryl Perkins  
 ADDRESS P.O. Box 547 ADDRESS P.O. Box 547  
Pennsboro, West Virginia 26415 Pennsboro, West Virginia 26415



STATE OF WEST VIRGINIA  
DIVISION OF ENVIRONMENTAL PROTECTION  
SECTION OF OIL AND GAS

WELL REGISTER ASSIGNMENT

This API Number 47-103-01662, issued to PERKINS OIL & GAS, INC. is evidence of permission to operate the well that is referenced at the location described on the attached plat, subject to the provisions of Chapters 22 and 22B of the West Virginia Code of 1931, as amended, and all rules and regulations promulgated thereunder. The name and telephone number of the Oil and Gas Inspector for this well is RANDAL MICK -  
304-986-3324.

Spills or emergency discharges must be reported to 1-800-654-3312.

Failure to abide by all statutory and regulatory provisions governing all duties and operations hereunder may result in suspension or revocation of your permits and in addition may result in civil and/or criminal penalties.

The enclosed WR-35 must be completed by you and returned to this office. In addition annual production reports must be submitted on this well and failure to do so may require you to plug the well.

Theodore M. Streit  
Chief

By: T. M. Streit

Title: \_\_\_\_\_

Operator's Well No: GARNER #12

Farm Name: GARNER, AL & HENRY

API Well Number : 47-103-01662 N

Date Issued : 04/18/95

APR 18 1995