


LATITUDE 39° 42' 30"

5,550'

LONGITUDE 80° 25' 00"

2,850'

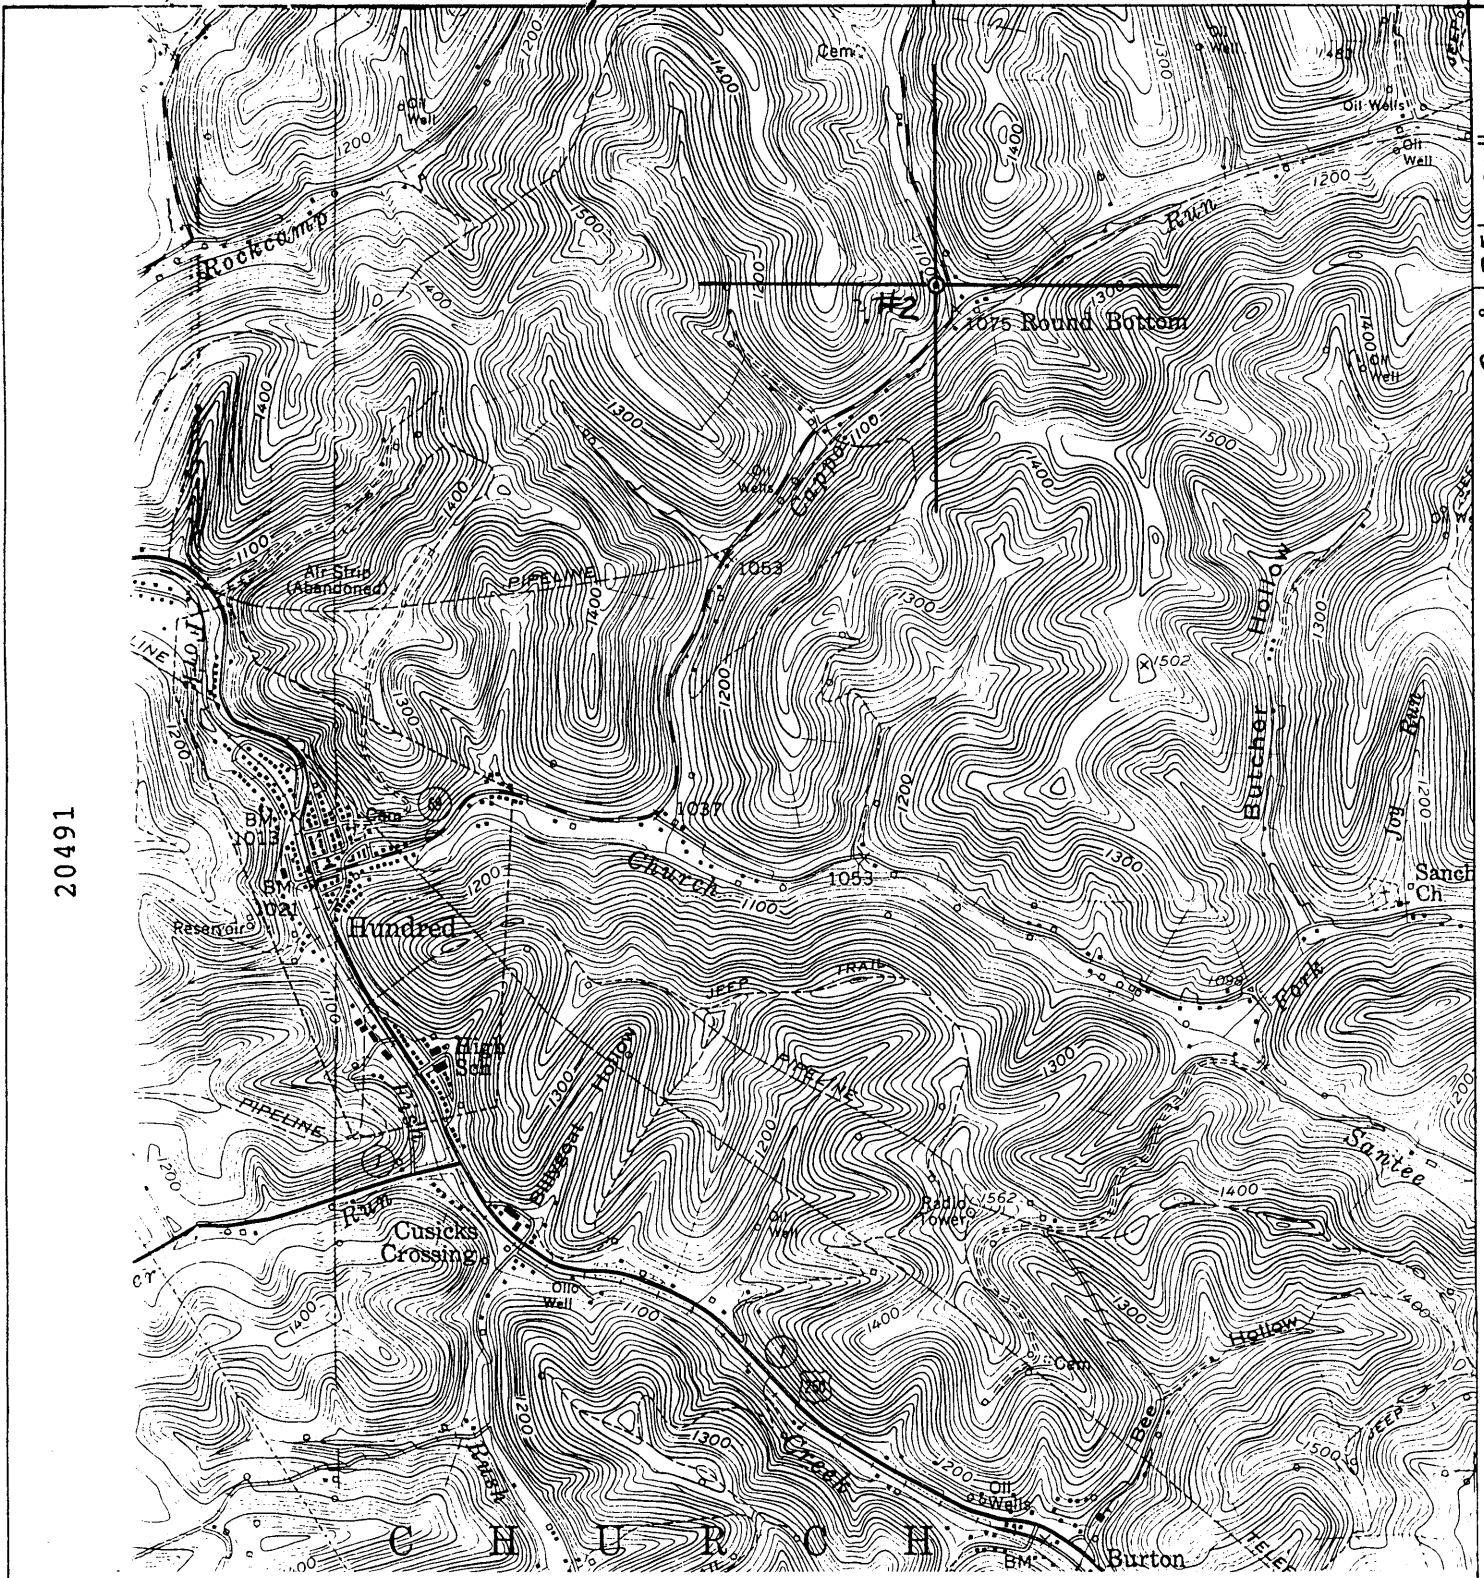

20491

I THE UNDERSIGNED, HEREBY CERTIFY THAT THIS PLAT IS CORRECT TO THE BEST OF MY KNOWLEDGE AND BELIEF.

SIGNED

*Deryl Perkins*

TITLE

Deryl Perkins - VICE PRESIDENT

STATE OF WEST VIRGINIA  
DIVISION OF ENVIRONMENTAL PROTECTION  
OFFICE OF OIL AND GAS

DATE March 27, 19 95

FARM W.H. Hixenbaugh NO. 2

API WELL NO.

47-103-1665-N

WELL TYPE: OIL  GAS  LIQUID INJECTION  WASTE DISPOSAL   
(IF "GAS") PRODUCTION  STORAGE  DEEP  SHALLOW

LOCATION: ELEVATION 1111 WATERSHED Cappo Run

DISTRICT Church 2 COUNTY Wetzel

QUADRANGLE Hundred 403

SURFACE OWNER Unknown ACREAGE ?

OIL & GAS ROYALTY OWNER Unknown LEASE ACREAGE 104 Ac.

LEASE NO. \_\_\_\_\_

PRODUCING FORMATION Gordon TOTAL DEPTH 3075'

WELL OPERATOR Perkins Oil & Gas DESIGNATED AGENT Deryl Perkins

ADDRESS P.O. Box 547 ADDRESS P.O. Box 547

Pennsboro, West Virginia 26415 Pennsboro, West Virginia 26415

Latitude

+  
.55s  
1.03w

Longitude

Topo Location

7.5' Loc. \_\_\_\_\_ 15' Loc. \_\_\_\_\_  
\_\_\_\_\_ (calc.) \_\_\_\_\_

Company Perkins O+G

Farm WH Hixsonbaugh #2

15' Quad \_\_\_\_\_  
(sec.)

7.5' Quad Hundred

District Church

WELL LOCATION PLAT

County 103 Permit 1665-N

71138?

STATE OF WEST VIRGINIA  
DIVISION OF ENVIRONMENTAL PROTECTION  
SECTION OF OIL AND GAS

WELL REGISTER ASSIGNMENT

This API Number 47-103-01665, issued to PERKINS OIL & GAS, INC. is evidence of permission to operate the well that is referenced at the location described on the attached plat, subject to the provisions of Chapters 22 and 22B of the West Virginia Code of 1931, as amended, and all rules and regulations promulgated thereunder. The name and telephone number of the Oil and Gas Inspector for this well is RANDAL MICK -  
304-986-3324.

Spills or emergency discharges must be reported to 1-800-654-3312.

Failure to abide by all statutory and regulatory provisions governing all duties and operations hereunder may result in suspension or revocation of your permits and in addition may result in civil and/or criminal penalties.

The enclosed WR-35 must be completed by you and returned to this office. In addition annual production reports must be submitted on this well and failure to do so may require you to plug the well.

Theodore M. Streit  
Chief

By: 

Title: \_\_\_\_\_

Operator's Well No: HIXENBAUGH #2

Farm Name: HIXENBAUGH, W.H.

API Well Number : 47-103-01665 N

Date Issued : 04/18/95

APR 21 1995