
- 2000;

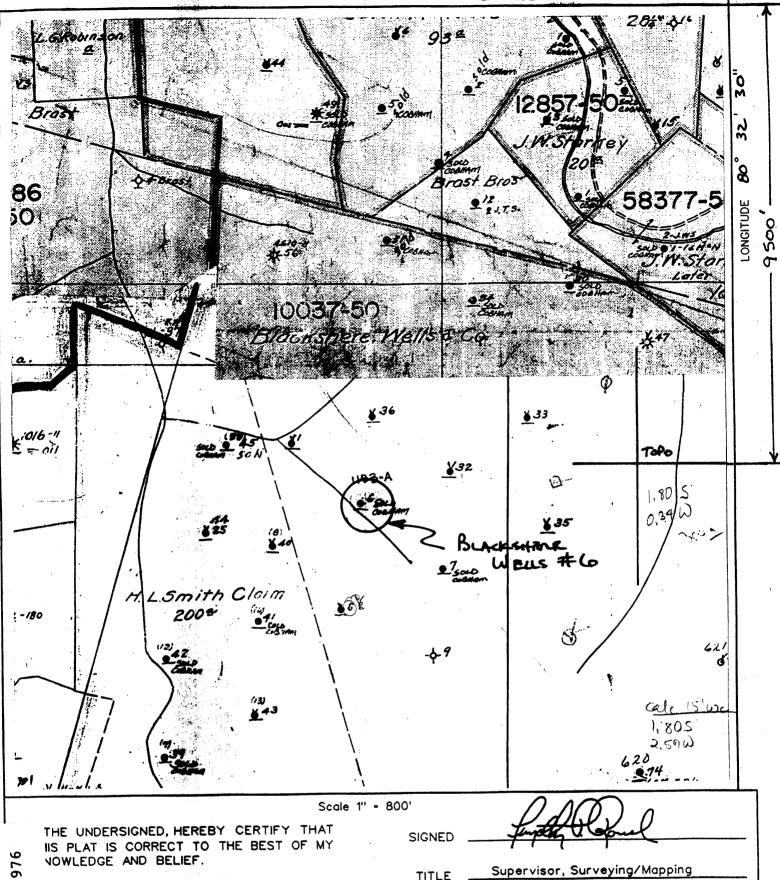

TITLE

	SI	ATE	-	OF	WES'	T VIR	GINIA	
DIVISIO	Ν	OF	E	NVI	RONM	ENTA	L PR	OTECTIO
	0	FFIC	Έ	OF	OIL	AND	GAS	

October 31 ., 19<u>96</u> DATE _NO._6 Blackshere Wells & Co. FARM. API WELL NO. 47-103 - 1722-1

WELL TYPE: OIL X GAS LIQUID INJECTION WASTE DISPOSAL _	
COUNTY WATERSHED COUNTY	Kun .
SURFACE OWNERUnknown OIL & GAS ROYALTY OWNERUnknown	LEASE ACREAGE
PRODUCING FORMATION Big Injun	TOTAL DEPTH ZZZO
WELL OPERATOR Pennzoil Products Company DESIGNATED AGENT ADDRESS P.O. Box 5519 ADDRESS Vienna, WV 25105	Philip S. Ondrusek P.O. Box 5519 Vienna, WV 26105 12/06/1996

Latitude

Topo Location

7.5' Loc._____ 15' Loc.____ (calc.)

Company <u>Pennzoil</u>

Farm B. Wellsa Co #6

15' Quad _______(sec.)

7.5' Quad _____

District Grant

WELL LOCATION PLAT

County 103 Permit 1722

6-6 100

SERIAL NOFAF	ئكىنى	L COMPA aclishuri-Lu ELLS & Ci	^	WE	C
•	_ N	s. 2	E.		w. 4
	-			Map N	
VATERS OF Horgan					
DISTRICT Grant	COUNTY	y Wetze	1 STAT	5 77	.Va.
DRILLING COMMENCED 11		COMPLETED	1 /00 /4 00		_{тн_} 2220
SANDS	TOP	BOTTOM	ELEV. TOP		-
·	107	BOTTOM	ELEV. 10P	- :	CASING.
PGH. COAL OR BIG LIME				_10	460
Pgh Coal	802	809		8 1	4 1300
<u> Big Injun Sand</u>	2120			6 5	V8 2160
Oil	2190	1			
				PACKER	S AND DEPTH SET
				1	····
NITIAL PROD. 30 B	n] e	P	ig Injun		2100
	<u> </u>	SAND	TE TE JUN	DEPTH_	502
$\frac{4}{4}$	15		11 11	· • -	1388 BC
HOT */ */ V TOUA	RTS. TU			••	2184

STATE OF WEST VIRGINIA DIVISION OF ENVIRONMENTAL PROTECTION SECTION OF OIL AND GAS

WELL REGISTER ASSIGNMENT

This API Number 47-103-01722, issued to PENNZOIL PRODUCTS COMPANY is evidence of permission to operate the well that is referenced at the location described on the attached plat, subject to the provisions of Chapters 22 and 22B of the West Virginia Code of 1931, as amended, and all rules and regulations promulgated thereunder. The name and telephone number of the Oil and Gas Inspector for this well is RANDAL MICK -304-759-0579.

Spills or emergency discharges must be reported to 1-800-654-3312.

Failure to abide by all statutory and regulatory provisions governing all duties and operations hereunder may result in suspension or revocation of your permits and in addition may result in civil and/or criminal penalties.

The enclosed WR-35 must be completed by you and returned to this office. In addition annual production reports must be submitted on this well and failure to do so may require you to plug the well.

Theodore M. Streit
Chief

By:

Title:_____

Operator's Well No: BLACKSHERE #6 1.16

Farm Name:

API Well Number : 47-103-01722 N

Date Issued : 12/04/96