
-2200'-

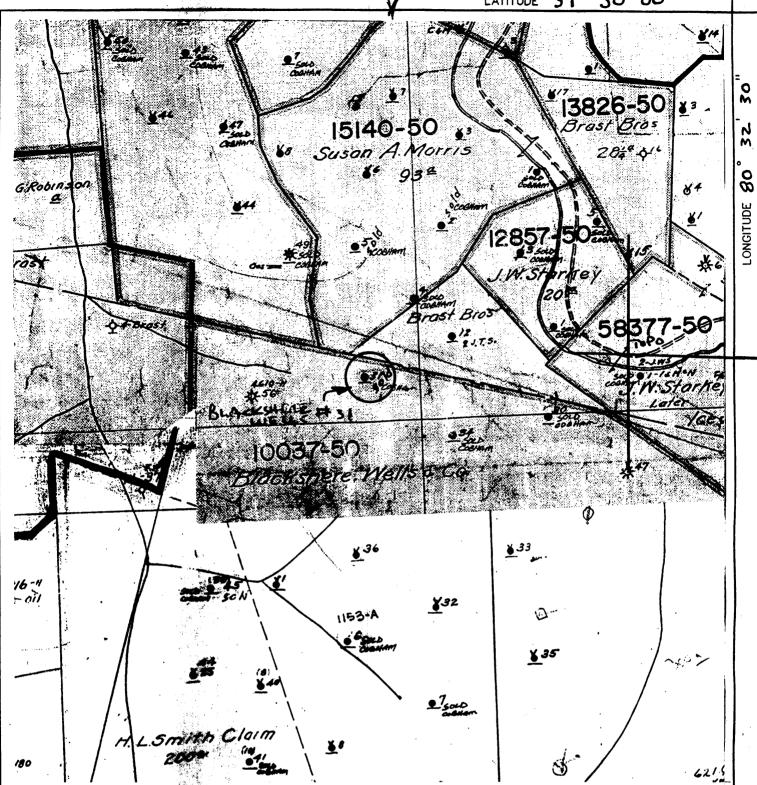

THE UNDERSIGNED, HEREBY CERTIFY THAT IS PLAT IS CORRECT TO THE BEST OF MY NOWLEDGE AND BELIEF.

Vienna, WV 26105

Scale 1" - 800'

AT
MY

SIGNED

Vienna, WV 26105

TITLE Supervisor, Surveying/Mapping

STATE OF WEST VIRGINIA	DATEOctober 31 19 96
DIVISION OF ENVIRONMENTAL PROTECTION	FARM Blackshere Wells & Co. NO. 31
OFFICE OF OIL AND GAS	47-103-1726-N
WELL TYPE: OIL X GAS LIQUID INJECTION WASTE DISPOS	SAL Was 103 70922
(IF "GAS") PRODUCTION STORAGE DEEP S	HALLOW
LOCATION: ELEVATION 1400 TO WATERSHED MOCCA	in Run
DISTRICT GRANT COUNTY_	
QUADRANGLE FOLSOM	
SURFACE OWNERUnknown	ACREAGE
OIL & GAS ROYALTY OWNER Unknown	LEASE ACREAGE 3800 Ac.
LEASE NO.	6-6/00
PRODUCING FORMATION Big Injun	TOTAL DEPTH 2526
WELL OPERATOR Pennzoil Products Company DESIGNATED AGE	NT Philip S. Ondrusek
	S P.O. Box 5519

Well Sold to SOUTH	J. & H. Pr PENN OI	oductions L COMPA	11-7-68 NY—Сом	47-/63	-1726
SERIAL NOFAI ELEVATION	N. 3 Fork, Sc	s3	800	TE VO	2952 2952
PGH. COAL OR BIG LIME PGH GOAT  Fig Injun Sand Pay	1130 2405 2504	1149		10  8 1/4  3 5/3	895 <b>£669</b> 2431
SAS TEST SHOT 10/15/00 QUANTE REMARKS REPORTED BY W'F			ig Injun		504 (/257 526

## STATE OF WEST VIRGINIA DIVISION OF ENVIRONMENTAL PROTECTION SECTION OF OIL AND GAS

## WELL REGISTER ASSIGNMENT

This API Number 47-103-01726, issued to PENNZOIL PRODUCTS COMPANY is evidence of permission to operate the well that is referenced at the location described on the attached plat, subject to the provisions of Chapters 22 and 22B of the West Virginia Code of 1931, as amended, and all rules and regulations promulgated thereunder. The name and telephone number of the Oil and Gas Inspector for this well is RANDAL MICK

- 304-759-0579.

Spills or emergency discharges must be reported to 1-200-654 2212

Spills or emergency discharges must be reported to 1-800-654-3312.

Failure to abide by all statutory and regulatory provisions governing all duties and operations hereunder may result in suspension or revocation of your permits and in addition may result in civil and/or criminal penalties.

The enclosed WR-35 must be completed by you and returned to this office. In addition annual production reports must be submitted on this well and failure to do so may require you to plug the well.

> Theodore M. Streit Chief Title: Operator's Well No: BLACKSHERE #31 Farm Name: API Well Number: 47-103-01726 N

Date Issued: 12/04/96