
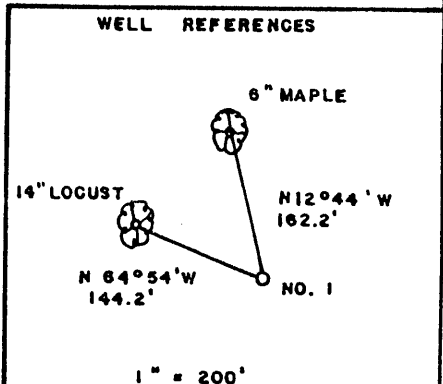


**KRECA / ROBINSON LEASE 33.6 AC.**

LATITUDE 39°37'30"

7.5' topo. loc.


12  
48

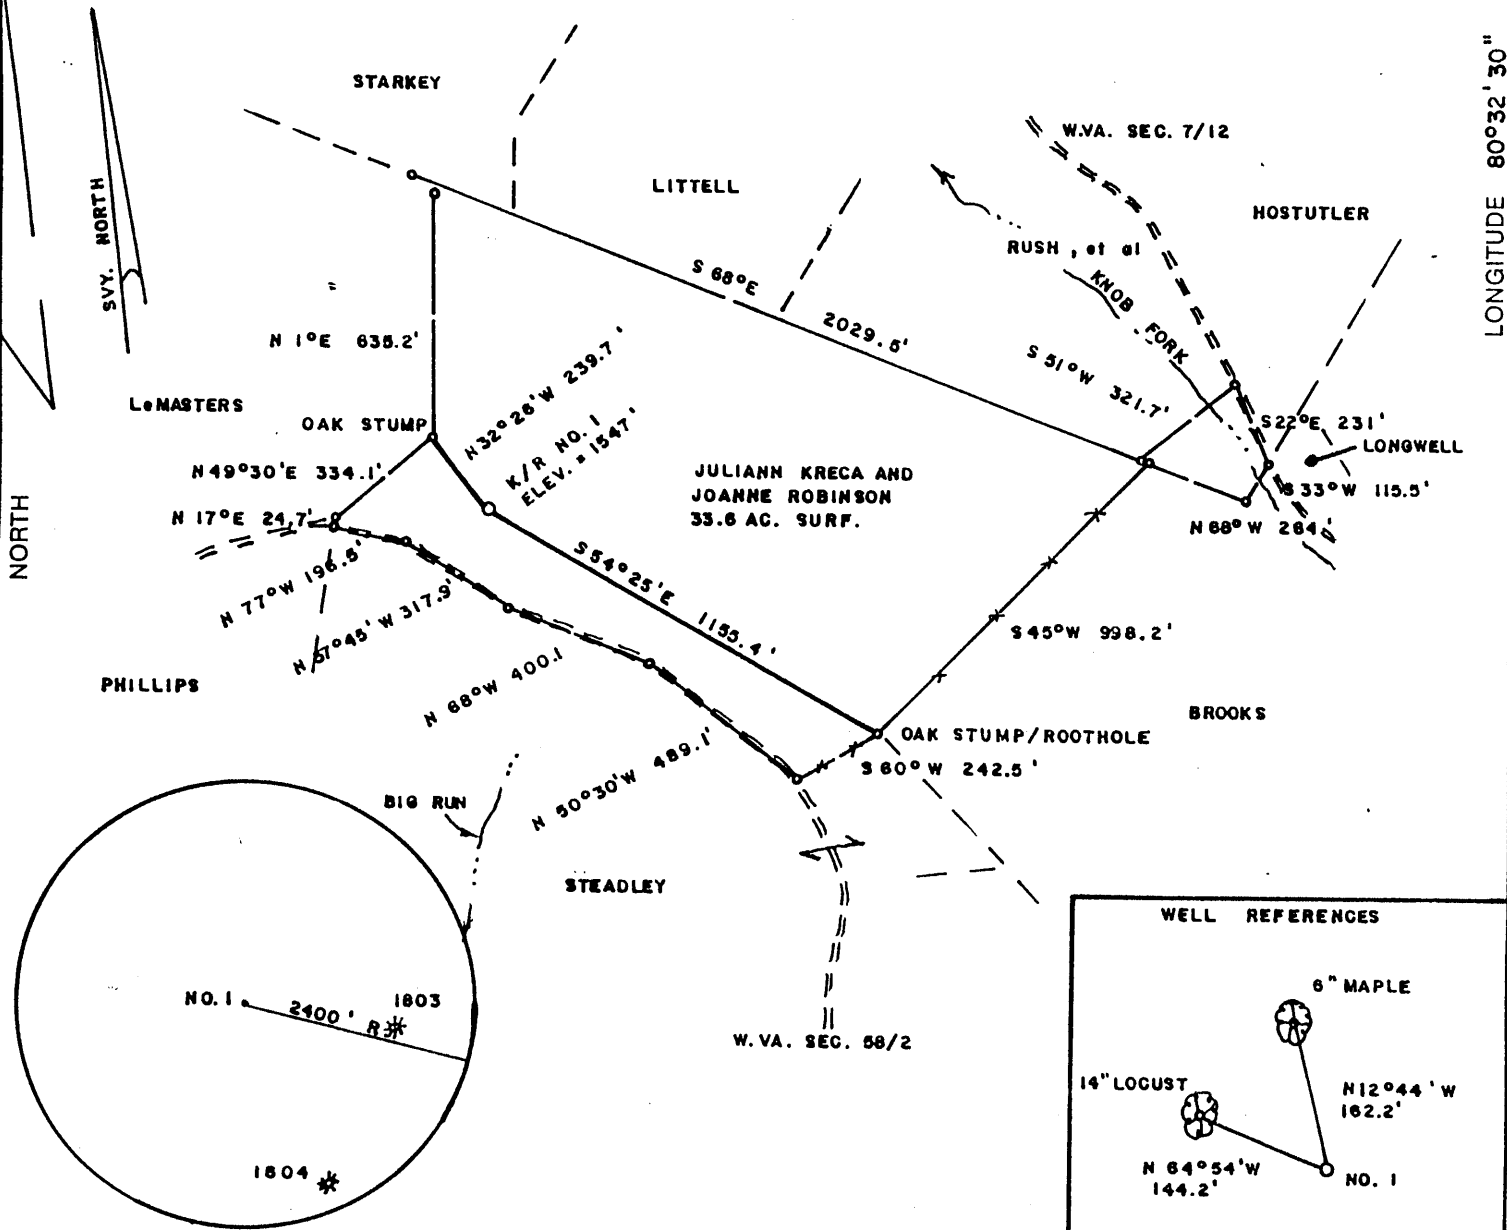

(+) DENOTES LOCATION OF WELL ON UNITED STATES TOPOGRAPHIC MAPS

FILE NO. \_\_\_\_\_  
 DRAWING NO. \_\_\_\_\_  
 SCALE 1" = 500'  
 MINIMUM DEGREE OF ACCURACY 1/200  
 PROVEN SOURCE OF ELEVATION BM EAST OF LEASE  
 ELEV. = 1322'

I THE UNDERSIGNED, HEREBY CERTIFY THAT THIS PLAT IS CORRECT TO THE BEST OF MY KNOWLEDGE AND BELIEF AND SHOWS ALL THE INFORMATION REQUIRED BY LAW AND THE REGULATIONS ISSUED AND PRESCRIBED BY THE DEPARTMENT OF ENERGY.  
 (SIGNED) Mark C. Echard  
 R.P.E. \_\_\_\_\_ L.L.S. 490

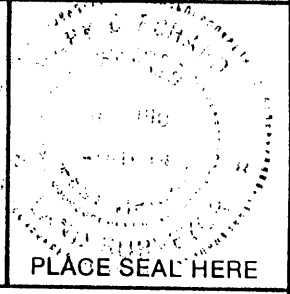

STATE OF WEST VIRGINIA  
 Division of Environmental Protection  
 OFFICE OF OIL AND GAS



DATE SEPTEMBER 25, 2000  
 OPERATOR'S WELL NO. KRECA NO. 1  
 API WELL NO. \_\_\_\_\_

WELL TYPE: OIL  GAS  LIQUID INJECTION  WASTE DISPOSAL   
 (IF "GAS,") PRODUCTION  STORAGE  DEEP  SHALLOW   
 LOCATION: ELEVATION 1547' WATERSHED BIG RUN & KNOB FORK  
 DISTRICT CENTER COUNTY WETZEL  
 QUADRANGLE BIG RUN 7.5'

SURFACE OWNER JULIANN KRECA and JOANNE ROBINSON ACREAGE 33.6  
 OIL & GAS ROYALTY OWNER JULIANN KRECA, et al LEASE ACREAGE 33.6  
 LEASE NO. \_\_\_\_\_

PROPOSED WORK: DRILL  CONVERT  DRILL DEEPER  REDRILL  FRACTURE OR STIMULATE  PLUG OFF OLD FORMATION  PERFORATE NEW FORMATION  OTHER PHYSICAL CHANGE IN WELL (SPECIFY) \_\_\_\_\_

PLUG AND ABANDON  CLEAN OUT AND REPLUG   
 TARGET FORMATION SPEECHLEY ESTIMATED DEPTH 3900'  
 WELL OPERATOR D.A.C. DESIGNATED AGENT KENNETH MASON  
 ADDRESS P.O. BOX 99 ADDRESS P.O. BOX 99  
ALMA, WV 26320 ALMA, WV 26320

FORM WW-6

COUNTY NAME WETZEL  
 PERMIT 1812

6-6 45



Kreca #1  
01-04-01

Stage #1	perfs	sand	avg rate	isip
5 <sup>th</sup> ,4 <sup>th</sup>	3116-3478	250 sks	20 bpm	3394#
Stage #2				
Big Injun	2210-2220	100 sks	18 bpm	2394#

Drillers Log

Sh	0	70
Sd	70	125
Sd/Sh	125	412
RR	412	440
Sd/Sh	440	832
Coal	832	836
Sd/Sh	836	1387
RR	1387	1408
Sd/Sh	1387	2205
Sd	2205	2280
Sd/Sh	2280	2492
Lime	2492	2652
Sd	2652	2670
Sd/Sh	2670	3560
Sd	3560	3580
SH	3580	3757
Td	3757	

Electric Log Tops

Big Lime	2508
Berea	2908
Gordon	3240

