

West Virginia Department of Environmental Protection
Office of Oil & Gas

WELL LOCATION FORM: GPS

API: 47- 103 - 1840 WELL NO: 2

FARM NAME: Kuhn Lease

RESPONSIBLE PARTY NAME: DAC Energy, LLC

COUNTY: Wetzel DISTRICT: Center

QUADRANGLE: Big Run 7.5'

SURFACE OWNER: Michael G. Kuhn

ROYALTY OWNER: Michael G. Kuhn

UTM GPS NORTHING: 4,385,199 (NAD 83)

UTM GPS EASTING: 540,177 (NAD 83) GPS ELEVATION: 463 m. (1519')

The Responsible Party named above has chosen to submit GPS coordinates in lieu of preparing a new well location plat for a plugging permit on the above well. The Office of Oil & Gas will not accept GPS coordinates that do not meet the following requirements:

1. Datum: NAD 1983, Zone:17 North, Coordinate Units: meters, Altitude: height above mean sea level (MSL) - meters.
2. Accuracy to Datum - 3.05 meters
3. Data Collection Method:

| | | | |
|-------------------|-------------------------------------|-----------------------------|-------------------------------------|
| Survey Grade GPS | <input type="checkbox"/> | Post Processed Differential | <input type="checkbox"/> |
| | | Real-Time Differential | <input type="checkbox"/> |
| Mapping Grade GPS | <input checked="" type="checkbox"/> | Post Processed Differential | <input checked="" type="checkbox"/> |
| | | Real-Time Differential | <input type="checkbox"/> |

RECEIVED
Office of Oil and Gas
AUG 20 2015


I the undersigned, hereby certify this data is correct to the best of my knowledge and belief and shows all the information required by law and the regulations issued and prescribed by the Office of Oil and Gas.


Signature Kenneth R. Mason

President
Title

May 11, 2015
Date

SUBJECT WELL
Kuhn No.2
47-103-01840

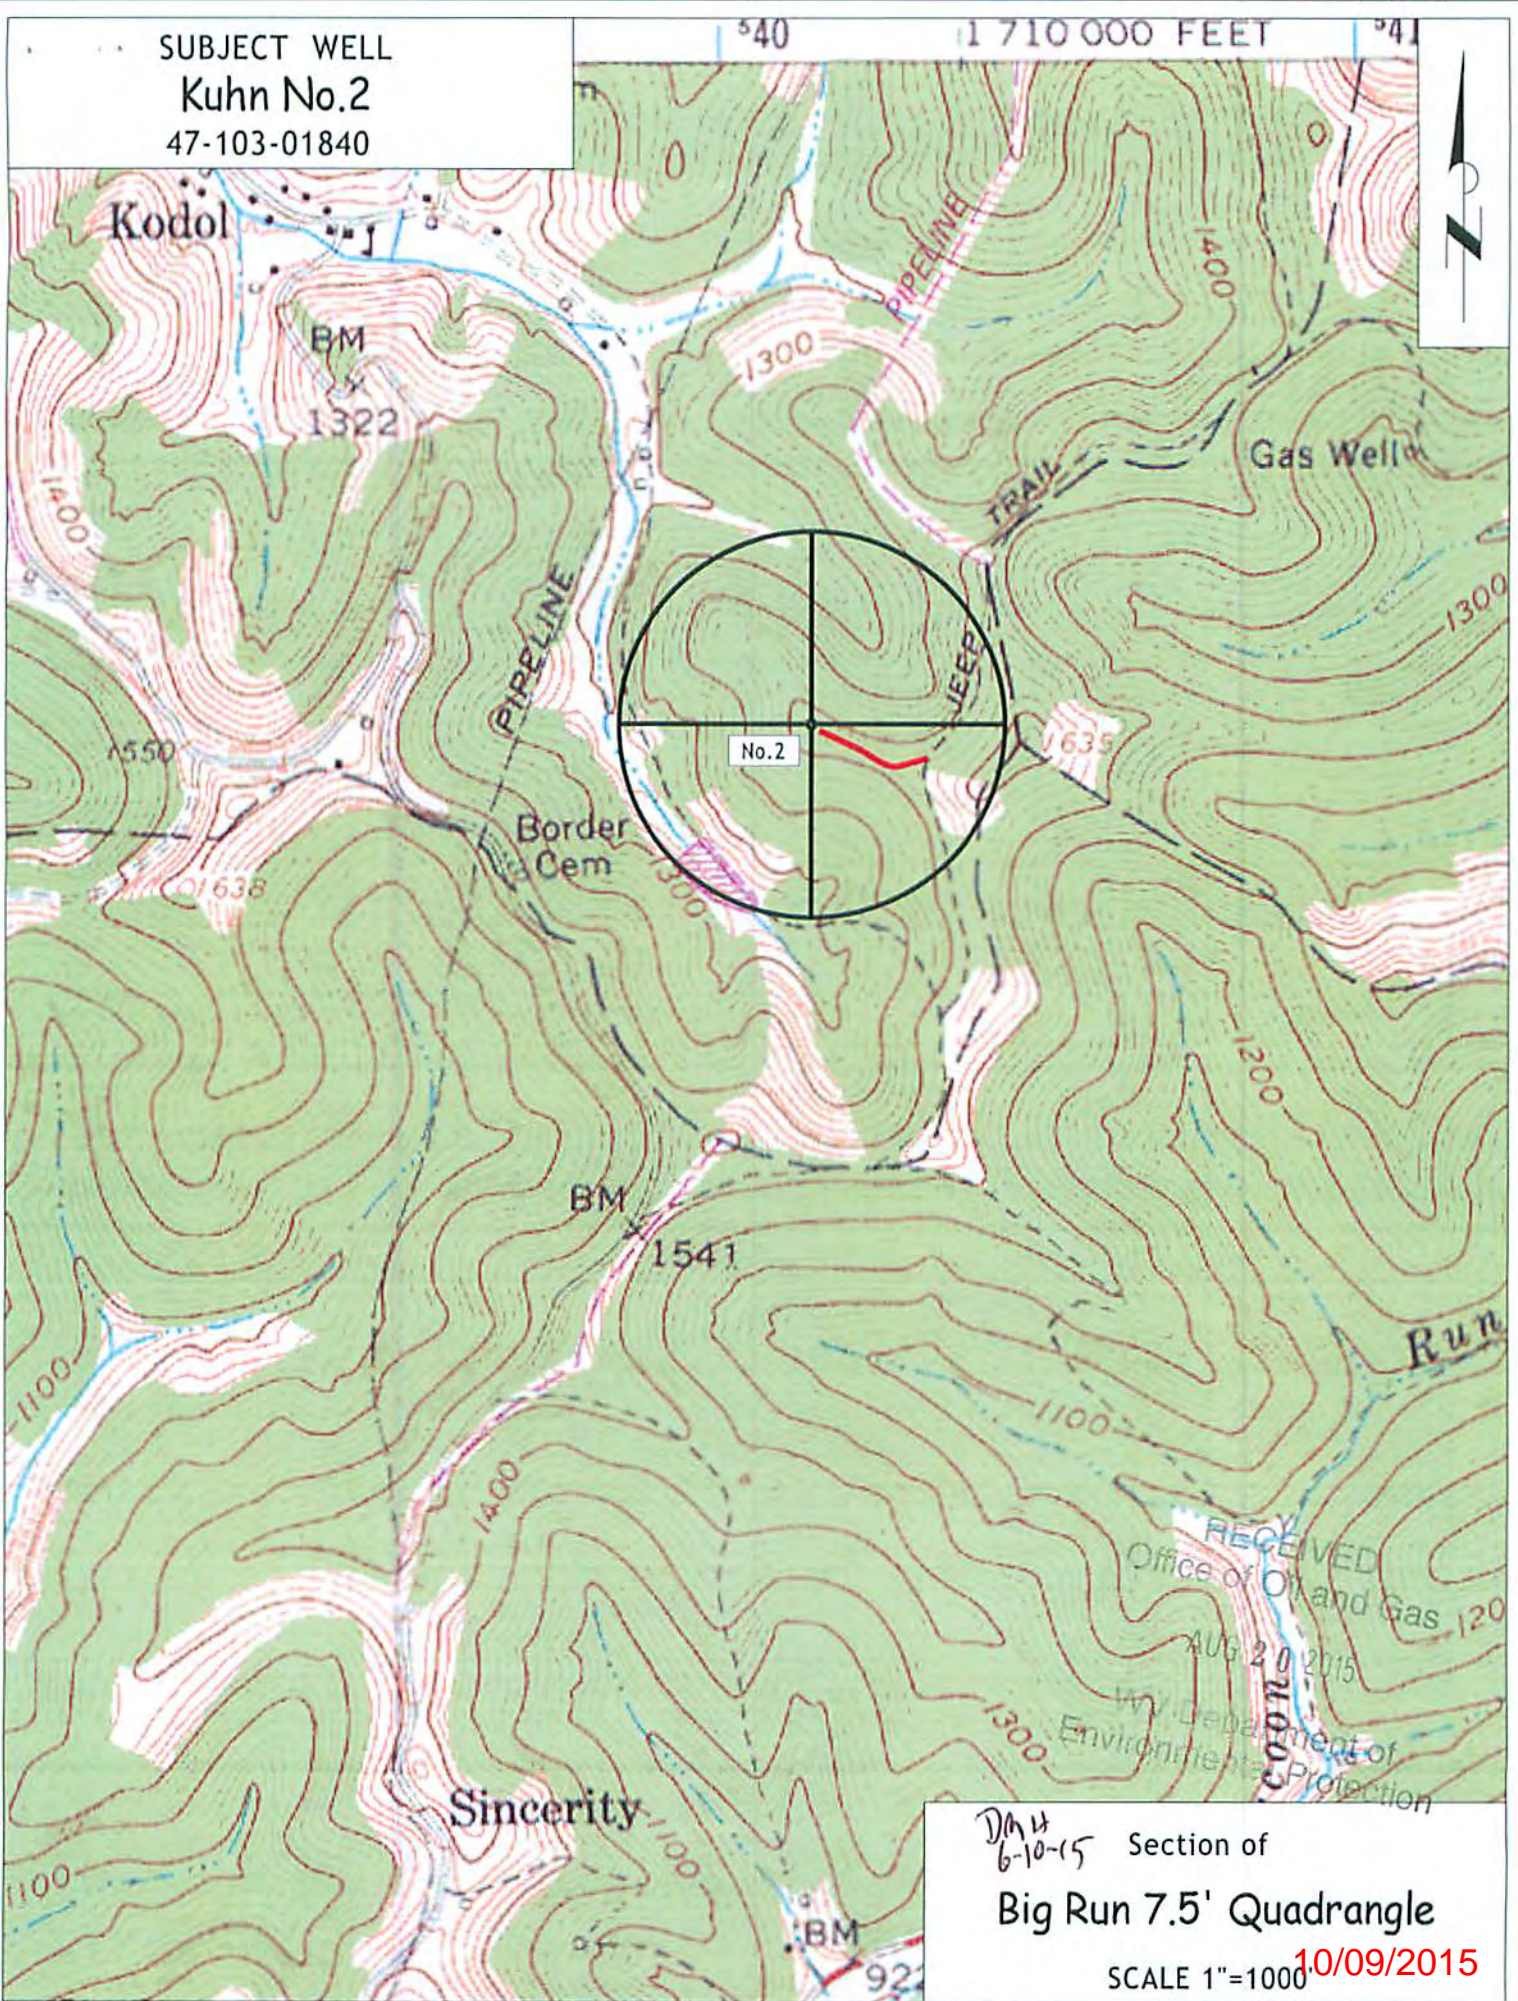

DMH
6-10-15 Section of
Big Run 7.5' Quadrangle
SCALE 1"=1000' 10/09/2015