

Company QUAKER STATE OIL & REFG. CORP.

Address Box 1789, PARKERSBURG, W.VA.

Farm JOHN MILLS

Tract _____ Acres 5200 Lease No. _____

Well (Farm) No. 108 Serial No. _____

Elevation (Spirit Level) 1063.54'

Quadrangle LITTLETON

County WETZEL District GRANT

Engineer Wm. N. Wilmoth

Engineer's Registration No. 3935

File No. _____ Drawing No. _____

Date JAN. 23, 1962 Scale 1" = 400'

STATE OF WEST VIRGINIA
 DEPARTMENT OF MINES
 OIL AND GAS DIVISION
 CHARLESTON

WELL LOCATION MAP
 FILE NO. WET-1141-A
 Nov 1902

+ Denotes location of well on United States Topographic Maps, scale 1 to 62,500, latitude and longitude lines being represented by border lines as shown.

- Denotes one inch spaces on border line of original tracing.



1520

STATE OF WEST VIRGINIA
DEPARTMENT OF MINES
OIL AND GAS DIVISION

Quadrangle Linton

WELL RECORD

Oil or Gas Well Oil well
(KIND)

Permit No. 147A 221902

Company Quaker State Oil Refng. Corp.
Address Box 1789, Parkersburg, W.Va.
Farm John Mills Estate Acres 5700
Location (waters) Buffalo Run of Fishing Creek
Well No. 108 Elev. 1063.5
District Grant County Wetzel
The surface of tract is owned in fee by State of W.Va.

Mineral rights are owned by Mills-Wetzel Lands Inc.
134 S. LaSalle St. Address Chicago 3, Ill.

Drilling commenced June 6, 1905
Drilling completed August 24, 1905

Date Shot _____ From _____ To _____
With 30 qts. glycerin

Open Flow _____ /10ths Water in _____ Inch
_____ /10ths Merc. in _____ Inch

Volume _____ Cu. Ft.

Rock Pressure _____ lbs. _____ hrs.

Oil _____ bbls., 1st 24 hrs.

WELL ACIDIZED _____

WELL FRACTURED _____

RESULT AFTER TREATMENT _____

ROCK PRESSURE AFTER TREATMENT _____

Fresh Water _____ Feet Salt Water _____ Feet

Casing and Tubing	Used in Drilling	Left in Well	Packers
Size			Kind of Packer
16			
13	16	16	
10	300	---	Size of
8 1/4	1260	---	
6 5/8	2075	2075	Depth set
5 3/16	2235	2235	
3			Perf. top
2			Perf. bottom
Liners Used			Perf. top
			Perf. bottom

CASING CEMENTED _____ SIZE _____ No. Ft. _____ Date _____


COAL WAS ENCOUNTERED AT _____ FEET _____ INCHES

_____ FEET _____ INCHES _____ FEET _____ INCHES

_____ FEET _____ INCHES _____ FEET _____ INCHES

Formation	Color	Hard or Soft	Top	Bottom	Oil, Gas or Water	Depth	Remarks
Pitts. Coal			800				
Big Injun			2113	2335	Gas & Oil	2136	Show
Stray Sand			2893				
					Gas	2904	
					Oil	2905	
					Oil	2912	
Total Depth	-	2927					

APR 6 1962

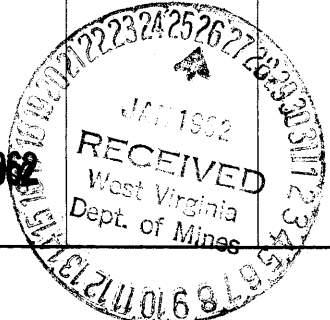

JOHN MILLS ESTATE NO. 108 WELL.

Grant District, Wetzel County, W. Va.

By Quaker State Oil Refing. Corp. Box 1789, Parkersburg, W. Va.

Drilled under permit No. Wet-1147-A; Littleton Quadrangle.

On 5200 acres, on Buffalo Run of Fishing Creek.

Elevation 1063.5' L.

Surface owned by State of W. Va.

Minerals owned by Mills^{Wetzel} Lands Inc. 134 S. LaSalle St. Chicago 3, Ill.

Drilling commenced June 6, 1905; completed August 24, 1905.

Well with 30 qts. glycerin.

Casing: 13", 16' left in; 10", 300' (pulled) 8 $\frac{1}{2}$ ", 1260' (pulled) 6-5/8",

2075' left in; 5-3/16", 2235' left in.

Gas and oil show 2136'. Gas 2904'. Oil 2905'. Oil 2912'.

Oil well.

Record from Mrs. Griffith to RCT, April 6, 1962. C. F. No. 1520.

	Top.	Bottom.
Pittsburgh Coal		800
Big Injun	2113	- 2335
Stray Sand		2893
Total Depth		2927