



---

west virginia department of environmental protection

---

Office of Oil and Gas  
601 57<sup>th</sup> Street, S.E.  
Charleston, WV 25304  
(304) 926-0450  
fax: (304) 926-0452

Austin Caperton, Cabinet Secretary  
[www.dep.wv.gov](http://www.dep.wv.gov)

Friday, April 27, 2018  
WELL WORK PERMIT  
Vertical / Re-Work

SWN PRODUCTION COMPANY, LLC  
POST OFFICE BOX 12359

SPRING, TX 773914954

Re: Permit approval for ALBERT & MARY HOHMAN 1  
47-103-02231-00-00

This well work permit is evidence of permission granted to perform the specified well work at the location described on the attached pages and located on the attached plat, subject to the provisions of Chapter 22 of the West Virginia Code of 1931, as amended, and all rules and regulations promulgated thereunder, and to any additional specific conditions and provisions outlined in the pages attached hereto. Notification shall be given by the operator to the Oil and Gas Inspector at least 24 hours prior to the construction of roads, locations, and/or pits for any permitted work. In addition, the well operator shall notify the same inspector 24 hours before any actual well work is commenced and prior to running and cementing casing. Spills or emergency discharges must be promptly reported by the operator to 1-800-642-3074 and to the Oil and Gas Inspector.

Please be advised that form WR-35, Well Operators Report of Well Work is to be submitted to this office within 90 days of completion of permitted well work, as should form WR-34 Discharge Monitoring Report within 30 days of discharge of pits, if applicable. Failure to abide by all statutory and regulatory provisions governing all duties and operations hereunder may result in suspension or revocation of this permit and, in addition, may result in civil and/or criminal penalties being imposed upon the operators.

Per 35 CSR 4-5.2.g this permit will expire in two (2) years from the issue date unless permitted well work is commenced. If there are any questions, please feel free to contact me at (304) 926- 0450.

James A. Martin  
Chief

A blue ink signature of James A. Martin, written in a cursive style.

Operator's Well Number: ALBERT & MARY HOHMAN 1  
Farm Name: HOHMAN, ALBERT & MARY  
U.S. WELL NUMBER: 47-103-02231-00-00  
Vertical Re-Work  
Date Issued: 4/26/2018

## PERMIT CONDITIONS

West Virginia Code §22-6-11 allows the Office of Oil and Gas to place specific conditions upon this permit. Permit conditions have the same effect as law. Failure to adhere to the specified permit conditions may result in enforcement action.

### CONDITIONS

---

1. If the operator encounters an unanticipated void, or an anticipated void at an unanticipated depth, the operator shall notify the inspector within 24 hours. Modifications to the casing program may be necessary to comply with W. Va. Code §22-6-20, which requires drilling to a minimum depth of thirty feet below the bottom of the void, and installing a minimum of twenty (20) feet of casing. Under no circumstance should the operator drill more than fifty (50) feet below the bottom of the void or install less than twenty (20) feet of casing below the bottom of the void.
2. Pursuant to 35 CSR 4-19.1.a, at the request of the surface owner all water wells or springs within 1000 feet of the proposed well that are actually utilized for human consumption, domestic animals or other general use shall be sampled and analyzed.
3. Pursuant to 35 CSR 4-19.1.c, if the operator is unable to sample and analyze any water well or spring with one thousand (1,000) feet of the permitted well location, the Office of Oil and Gas requires the operator to sample, at a minimum, one water well or spring located between one thousand (1,000) feet and two thousand (2,000) feet of the permitted well location.
4. All pits must be lined with a minimum of 20 mil thickness synthetic liner.
5. In the event of an accident or explosion causing loss of life or serious personal injury in or about the well or while working on the well, the well operator or its contractor shall give notice, stating the particulars of the accident or explosion, to the oil and gas inspector and the Chief within twenty-four (24) hours.
6. During the surface casing and cementing process, in the event cement does not return to the surface, or any other casing string that is permitted to circulate cement to the surface and does not return to the surface, the oil and gas inspector shall be notified within twenty-four (24) hours
7. Well work activities shall not constitute a hazard to the safety of persons.
8. Operator shall provide the Office of Oil & Gas notification of the date that drilling commenced on this well. Such notice shall be provided by sending an email to DEPOOGNotify@wv.gov within 30 days of commencement of drilling.

**STATE OF WEST VIRGINIA**  
**DEPARTMENT OF ENVIRONMENTAL PROTECTION, OFFICE OF OIL AND GAS**  
**WELL WORK PERMIT APPLICATION**

1) Well Operator: SWN Production Co., LLC 494512924 Wetzel Proctor Wileyville  
rework Operator ID County District Quadrangle

2) Operator's Well Number: Albert & Mary Hohman 1 3) Elevation: 1302'

4) Well Type: (a) Oil  or Gas   
(b) If Gas: Production  / Underground Storage   
Deep  / Shallow

5) Proposed Target Formation(s): Upper Devonian Proposed Target Depth: 6868-69'

6) Proposed Total Depth: 9910' Feet Formation at Proposed Total Depth: Tuscarora

7) Approximate fresh water strata depths: 381' Deepest water well within 1500' is +985' SS elevation, which calculates to 332' TVD at the well location.

8) Approximate salt water depths: 1639' Salinity curve analysis on the Margaret Sue Kelley 10H to the south determined that the top of Salt Water is in a sand lobe within the Raven Cliff Formation.

9) Approximate coal seam depths: 1078'

10) Approximate void depths, (coal, Karst, other): None that we are aware of.

11) Does land contain coal seams tributary to active mine? No

12) Describe proposed well work and fracturing methods in detail (attach additional sheets if needed)

\*\*See Attachment WILL FRAC UPPER DEVONIAN.

*DMH*  
*3-14-18*

**13) CASING AND TUBING PROGRAM**

TYPE	SPECIFICATIONS			FOOTAGE	INTERVALS	CEMENT
	Size	Grade	Weight per ft	For Drilling	Left in Well	Fill -up (Cu. Ft.)
Conductor	20"			40'	40'	
Fresh Water	13 3/8"	J-55	54.5	1140'	1140'	CTS
Coal						
Intermediate	9 5/8"	J-55	40.0	2558'	2558'	CTS
Production	7"	P-110	26.0	9717'	9717'	
Tubing						RECEIVED Office of Oil and Gas
Liners						MAR 21 2018

Packers: Kind: \_\_\_\_\_  
Sizes: \_\_\_\_\_  
Depths Set \_\_\_\_\_

WV Department of  
Environmental Protection

04/27/2018

**Albert Mary Hohman #1****Updated Procedure (April 24, 2018)**

1. MIRU Workover Rig & kill well
2. POH w/tbg
3. RUN corrosion log/ cement bond log and pulse neutron log
4. Check PBSD 7117'
5. Set Retrievable Bridge Plug w/Pressure Gauge set above Lower Marcellus @ 6975'
6. Pressure test casing
7. Ensure wellbore is filled with water leaving a 1000' air gap
8. RDMO WO Rig Leave a lower master valve and a cross over spool to 7-1/16" looking up 5K
9. RIH w/micro seismic array & Tilt meter (min OD required 3.9") record fractures from the Margaret Sue Kelly 2H & 4H for a total of 20 stages
10. POH with micro seismic array & tilt meter
11. RU wireline & perforate Single Cluster in Upper Devonian Approx. 6868-69' 6 spf 60 deg phasing 12 holes
12. If time allows pump a DFIT
13. Frac Upper Devonian (single Cluster 25-30 BPM 70,000#'s) tag proppant with Carbo ceramics non-radioactive tracer (NRT)
14. RIH w/Temp Log
15. Retrieve RBP and gauge
16. RIH Pulse Neutron Log
- ★ 17. Set CIBP & 100' of cement 20' above the Lower Marcellus @ 6975'
18. MIRU Workover Rig
19. RIH w/6830' of 2-3/8" tbg
20. RD Workover Rig


g m m



Well Summary

ALBERT-MARY HOHMAN 1

Well RC#: 4001158166

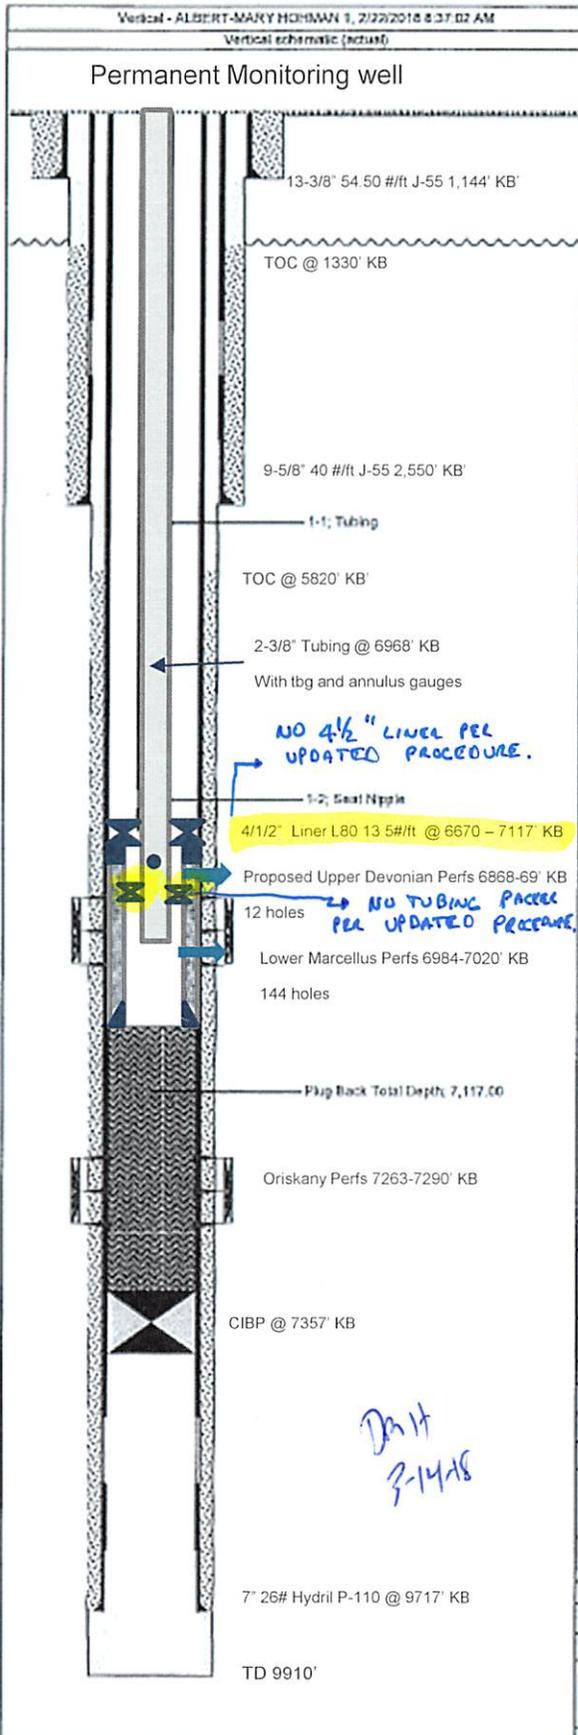

Well Header Setup			
Well Name ALBERT-MARY HOHMAN 1		Well/API Number 47103022310000	
Original KB Elevation (ft) 1,334.00	Ground Elevation (ft) 1,302.00	Spud Date 4/30/2007	Reg Release Date 6/5/2007
Surface Legal Location		Latitude (°) 39.69688237	Longitude (°) -80.70699018
Wellbore Sections Setup			
Wellbore Name ALBERT-MARY HOHMAN 1		Kick Off Depth (ftKB)	Vertical Section Direction (°)
Section Des	Size (in)	Act Top (ftKB)	Act Btm (ftKB)
Surface	17 1/2	15.0	1,144.0
Intermediate	12 1/4	1,144.0	2,550.0
Production	8 3/4	2,550.0	9,910.0
Plug Back Total Depths			
Date	Depth (ftKB)	Method	Com
	7,117.0		
Casing Data			
Surface			
Casing Description Surface	Run Date 5/2/2007	Set Depth (ftKB) 1,144.00	
Item Des	OD (in)	Wt (lb/ft)	Grade
Casing Joints	13.375	54.50	J-55
Intermediate			
Casing Description Intermediate	Run Date 5/6/2007	Set Depth (ftKB) 2,550.00	
Item Des	OD (in)	Wt (lb/ft)	Grade
Casing Joints	9.625	40.00	J-55
Float Collar	9.625		
Casing Joints	9.625	40.00	N-80
Float Shoe	9.625		
Production			
Casing Description Production	Run Date 5/31/2007	Set Depth (ftKB) 9,917.00	
Item Des	OD (in)	Wt (lb/ft)	Grade
Casing Joints	7.000	26.00	P-110
Float Collar	7.000		
Casing Joints	7.000	26.00	P-110
Float Shoe	7.000		
Cement Data			
5/2/2007 05:00, Surface			
Description Surface Casing Cement	String 5/2/2007 05:00, Surface	Wellbore ALBERT-MARY HOHMAN 1	Type Casing
Stage Number	Description	Top (ftKB)	Btm (ftKB)
1	Surface Casing Cement	15.0	1,144.0
Fluid	Fluid Des	Amount (sacks)	Class
		21	
5/6/2007 23:00, Intermediate			
Description Intermediate Casing Cement	String 5/6/2007 23:00, Intermediate	Wellbore ALBERT-MARY HOHMAN 1	Type Casing
Stage Number	Description	Top (ftKB)	Btm (ftKB)
1	Intermediate Casing Cement	1,330.0	2,550.0
Fluid	Fluid Des	Amount (sacks)	Class
		4	Type 1
		4	
5/31/2007 20:15, Production			
Description Production Casing Cement	String 5/31/2007 20:15, Production	Wellbore ALBERT-MARY HOHMAN 1	Type Casing
Stage Number	Description	Top (ftKB)	Btm (ftKB)
	Production Casing Cement	5,820.0	9,917.0
Fluid	Fluid Des	Amount (sacks)	Class
		13	Poz 50/50
5/31/2007 20:15, Production			
Description Production Casing Cement	String 5/31/2007 20:15, Production	Wellbore ALBERT-MARY HOHMAN 1	Type Plug

NO 4 1/2" LINER PER UPDATED PROCEDURE.

NO TUBING PACKER PER UPDATED PROCEDURE.

Dr H  
3-14-08

WR-35

DATE: June 24, 2008  
API #: 47-10302231

State of West Virginia  
Division of Environmental Protection  
Section of Oil and Gas

Well Operator's Report of Well Work

Farm name: ALBERT AND MARY HOHMAN Operator Well No.: 625531

LOCATION: Elevation: 1302' Quadrangle: WILEYVILLE 7.5

District: PROCTOR County: WETZEL  
Latitude: 4200 Feet South of 39 Deg. 42 Min. 30 Sec.  
Longitude 11400 Feet West of 80 Deg. 40 Min. 00 Sec.

Company: CHESAPEAKE APPALACHIA, L.L.C.

	Casing & Tubing	Used in Drilling	Left in well	Cement fill up Cu. Ft.
Address: Post Office Box 6070 Charleston, WV 25362-0070				
Agent: Michael John				
Inspector: Bill Hatfield	20"	40'		
Date Permit Issued: 03/27/2007	13 3/8"	1140	1140	CTS
Date Well Work Commenced: 04/30/2007	9 5/8"	2558	2558	CTS
Date Well Work Completed:	7"	9717	9717	
Verbal Plugging:				
Date Permission granted on:				
Rotary XX Cable Rig				
Total Depth (feet): 9710'				
Fresh Water depths (ft):				RECEIVED Office of Oil and Gas
Salt water depths (ft):				MAR 21 2018
Is coal being mined in area (Y/N)? NO				
Coal Depths (ft):				WV Department of Environmental Protection

OPEN FLOW DATA

6984 - 7020 Set Cement Plug  
between Oriskany and Marcellus

Producing formation Marcellus Pay zone depth (ft) \_\_\_\_\_

X Gas: Initial open flow \_\_\_\_\_ MCF/d Oil: Initial open flow \_\_\_\_\_ Bbl/d  
Final open flow 1500 MCF/d Final open flow 0 Bbl/d  
Time of open flow between initial and final tests \_\_\_\_\_ Hours

Static rock Pressure 2400 psig (surface pressure) after 72 Hours

Second producing formation \_\_\_\_\_ Pay zone depth (ft) \_\_\_\_\_

Gas: Initial open flow \_\_\_\_\_ MCF/d Oil: Initial open flow \_\_\_\_\_ Bbl/d  
Final open flow \_\_\_\_\_ MCF/d Final open flow \_\_\_\_\_ Bbl/d  
Time of open flow between initial and final tests \_\_\_\_\_ Hours

Static rock Pressure \_\_\_\_\_ psig (surface pressure) after \_\_\_\_\_ Hours

NOTE: ON BACK OF THIS FORM PUT THE FOLLOWING: 1). DETAILS OF PERFORATED INTERVALS, FRACTURING OR STIMULATING, PHYSICAL CHANGE, ETC. 2). THE WELL LOG WHICH IS A SYSTEMATIC DETAILED GEOLOGICAL RECORD OF ALL FORMATIONS, INCLUDING COAL ENCOUNTERED BY THE WELLBORE.

Signed: [Signature] Chesapeake Appalachia, L.L.C.  
By: Mare Watkins, District Manager  
Date: 6/24/08



Frac delayed. Log scheduled for 10/8 to determine if there is a casing leak.

**10/4/2007** Loaded from SMS  
Frac delayed. Log scheduled for 10/8 to determine if there is a casing leak.

**10/5/2007** Loaded from SMS  
Frac delayed. Log scheduled for 10/5 to determine if there is a casing leak.

**10/8/2007** Loaded from SMS  
Schlumberger ran GHOST image, Gas hold up & GR/PSI/Temp logs. Logs indicated that the gas into the casing is leaking past the bottom plugs.

**10/9/2007** Loaded from SMS  
Coil tubing scheduled to arrive Oct 10.

**10/10/2007** Loaded from SMS  
MIRU Leader Coil Tubing.

**10/11/2007** Loaded from SMS  
TIH w/ Leader coil tubing. Tagged plug @ 7043~ @ 1:00 PM. Began drilling. Drilled for 15 minutes. Pump truck broke down. POOH for night.

**10/12/2007** Loaded from SMS  
MIRU Leader CTU. RIH. Tag plug # 1 @ 7043~ . Mill (on water) from 8:30 AM to 12:15 PM. Chase plug to plug # 2 @ 7051.3~ mill on plug until 6:30 PM. Milled to 7052.4~ Having difficulty with severe hanging & finally quit drilling. POOH to inspect mill. Pulled to 3700~ . Started to drag 7,000 to 12,000 over string weight. Got to surface. SI 7] . Trouble assumed to be in pack off assembly. Can not get mill out of lubricator to inspect. SDFN will resume in AM. Pumped a total of 1490 bbls.

**10/15/2007** Loaded from SMS

**ORISKANY Plug from ~ 7357' to 7100'.**

10/13- RIH. Tag bottom @ 7357~ . MIRU BJ Services. Spot 50 sks cement plug (Type 1, .8% CD-32, .125% ASA301, .4% BA-10 mixed @ 14.6 PPG, 1.33 CuFt/sk.) Dress top of plug @ 7100~ . Circulate hole to surface. Spot 500 gals MSA acid from 7070~ to 6760~ . POOH. Blowing coil clean with N2. Shut down, secure well head. RDMO Leader coil unit & pumping equipment.

10/12- Found debris in the pack-off head. Replaced mill. Chain tensioner not working, repair. RIH & tag plug @ 7056~ . Mill out plug. Chase to 7345~ . POOH. Secure well head. Remove mill. Release Baker Tool. Pumped 525 bbls.

**10/16/2007** Loaded from SMS  
Completed water hauling.

**10/17/2007** Loaded from SMS  
Key Energy ran sinker bar. Tag cmt plug @ 7117~ . Perforate the Marcellus 6984~ - 7020~ w/ 144 holes @ 60 deg phase w/ 4 spf using tag guns. Preparing for frac.

**10/18/2007** Loaded from SMS  
Perforate the Marcellus 10/16/07 from 6984~ - 7020~ w/ 144 holes @ 60 deg phase w/ 4 spf using tag guns. Preparing for frac.

Stimulation Stage 1: Frac													
BD Rate BPM	BD Press psi	BD ISIP	Pre FG psi/ft	ATP psi	MTP psi	ATR BPM	MTR BPM	Post FG psi/ft	Clean Vol bbls	ISIP psi	5 min psi	10 min psi	15 min psi
									25580	0			
Total		lb	Max Conc										
Comment													

**10/19/2007** Loaded from SMS

WW-2A  
(Rev. 6-14)

1.) Date: 2/21/2018  
2.) Operator's Well Number Albert & Marv Hohman  
State County Permit  
3.) API Well No.: 47- 103 - 02231

**STATE OF WEST VIRGINIA**  
**DEPARTMENT OF ENVIRONMENTAL PROTECTION, OFFICE OF OIL AND GAS**  
**NOTICE AND APPLICATION FOR A WELL WORK PERMIT**

4) Surface Owner(s) to be served:  
(a) Name Albert and Marv Hohman  
Address 197 Whetstone Road  
New Martinsville, WV 26155  
(b) Name \_\_\_\_\_  
Address \_\_\_\_\_  
(c) Name \_\_\_\_\_  
Address \_\_\_\_\_  
5) (a) Coal Operator  
Name \_\_\_\_\_  
Address \_\_\_\_\_  
(b) Coal Owner(s) with Declaration  
Name Consolidation Coal Company  
Address 1800 Washington Road  
Pittsburgh, PA 15241  
(c) Coal Lessee with Declaration  
Name \_\_\_\_\_  
Address \_\_\_\_\_  
6) Inspector Derek Hautt  
Address PO Box 85  
Smithville, WV 26178  
Telephone 304-206-7613

**TO THE PERSONS NAMED ABOVE TAKE NOTICE THAT:**

       Included is the lease or leases or other continuing contract or contracts by which I hold the right to extract oil and gas  
**OR**

       Included is the information required by Chapter 22, Article 6, Section 8(d) of the Code of West Virginia (see page 2)

I certify that as required under Chapter 22-6 of the West Virginia Code I have served copies of this notice and application, a location plat, and accompanying documents pages 1 through        on the above named parties by:

- Personal Service (Affidavit attached)
- Certified Mail (Postmarked postal receipt attached)
- Publication (Notice of Publication attached)

I have read and understand Chapter 22-6 and 35 CSR 4, and I agree to the terms and conditions of any permit issued under this application.

I certify under penalty of law that I have personally examined and am familiar with the information submitted on this application form and all attachments, and that based on my inquiry of those individuals immediately responsible for obtaining the information, I believe that the information is true, accurate and complete.

I am aware that there are significant penalties for submitting false information, including the possibility of **imprisonment.**



Well Operator SWN Production Co., LLC  
By: Dee Southall  
Its: Senior Regulatory Analyst  
Address: P.O. Box 1300  
Jane Lew, WV 26378  
Telephone: 304-884-1610  
Email: Dee\_Southall@swn.com

RECEIVED  
Office of Oil and Gas  
MAR 21 2018  
WV Department of  
Environmental Protection

Subscribed and sworn before me this 14th day of March, 2018

Brittany R Woody Notary Public  
My Commission Expires 11/27/2022

Oil and Gas Privacy Notice

WW-2A1  
(Rev. 1/11)

Operator's Well Number Albert & Mary Hohman 1

**INFORMATION SUPPLIED UNDER WEST VIRGINIA CODE  
Chapter 22, Article 6, Section 8(d)  
IN LIEU OF FILING LEASE(S) AND OTHER CONTINUING CONTRACT(S)**

Under the oath required to make the verification on page 1 of this Notice and Application, I depose and say that I am the person who signed the Notice and Application for the Applicant, and that -

- (1) the tract of land is the same tract described in this Application, partly or wholly depicted in the accompanying plat, and described in the Construction and Reclamation Plan;
- (2) the parties and recordation data (if recorded) for lease(s) or other continuing contract(s) by which the Applicant claims the right to extract, produce or market the oil or gas are as follows:

Grantor, Lessor, etc.	Grantee, Lessee, etc.	Royalty	Book/Page
See Attachment			

**Acknowledgement of Possible Permitting/Approval  
In Addition to the Office of Oil and Gas**

The permit applicant for the proposed well work addressed in this application hereby acknowledges the possibility of the need for permits and/or approvals from local, state, or federal entities in addition to the DEP, Office of Oil and Gas, including but not limited to the following:

- WV Division of Water and Waste Management
- WV Division of Natural Resources
- WV Division of Highways
- U.S. Army Corps of Engineers
- U.S. Fish and Wildlife Service
- County Floodplain Coordinator

RECEIVED  
Office of Oil and Gas

MAR 21 2013

WV Department of  
Environmental Protection

The applicant further acknowledges that any Office of Oil and Gas permit in no way overrides, replaces, or nullifies the need for other permits/approvals that may be necessary and further affirms that all needed permits/approvals should be acquired from the appropriate authority before the affected activity is initiated.

Well Operator: SWN Production Co., LLC  
 By: Its: Gary Nuckolls  
Staff Landman

**EXHIBIT "A"**

Attached to and made a part of the State of West Virginia Oil and Gas Permit Form, WW-6A1, by SWN Production Company, LLC, Operator  
Albert-Mary Hohman 1  
Wetzel County, West Virginia

#	TMP	LEASE #	LESSOR	LESSEE	ROYALTY	BK/PG
1	12-8-12	723461-029	Albert L. Hohman and Mary Hohman (Albert L. Hohman and Mary Hohman, Trustees of The Hohman Revocable Trust, dated August 8, 2014)	Chesapeake Appalachia, L.L.C.	12.5%	111A/437
			Chesapeake Appalachia, L.L.C.	SWN Production Company		157A/540

**RECEIVED**  
Office of Oil and Gas  
MAR 21 2012  
WV Department of  
Environmental Protection

103-02231W

WW-9  
(5/16)

103-02231W

API Number 47 - 103 - 02231  
Operator's Well No. Albert & Mary Hohman 1

STATE OF WEST VIRGINIA  
DEPARTMENT OF ENVIRONMENTAL PROTECTION  
OFFICE OF OIL AND GAS  
FLUIDS/ CUTTINGS DISPOSAL & RECLAMATION PLAN

Operator Name SWN Production Co., LLC OP Code 494512924

Watershed (HUC 10) Upper Ohio South Quadrangle Wileyville

Do you anticipate using more than 5,000 bbls of water to complete the proposed well work? Yes  No

Will a pit be used? Yes  No

ANY WELL EFFLUENT MUST  
BE CONTAINED IN TANKS AND  
DISPOSED OF OFF-SITE.

If so, please describe anticipated pit waste: \_\_\_\_\_

Will a synthetic liner be used in the pit? Yes  No  If so, what ml.? \_\_\_\_\_

JWM

Proposed Disposal Method For Treated Pit Wastes:

- \_\_\_\_\_ Land Application (if selected provide a completed form WW-9-GPP)
- \_\_\_\_\_ Underground Injection ( UIC Permit Number \_\_\_\_\_ )
- \_\_\_\_\_ Reuse (at API Number \_\_\_\_\_ )
- \_\_\_\_\_ Off Site Disposal (Supply form WW-9 for disposal location)
- \_\_\_\_\_ Other (Explain \_\_\_\_\_)

Will closed loop system be used? If so, describe: NA

Drilling medium anticipated for this well (vertical and horizontal)? Air, freshwater, oil based, etc. NA

-If oil based, what type? Synthetic, petroleum, etc. \_\_\_\_\_

Additives to be used in drilling medium? NA

RECEIVED  
Office of Oil and Gas

Drill cuttings disposal method? Leave in pit, landfill, removed offsite, etc. NA

MAR 21 2018

-If left in pit and plan to solidify what medium will be used? (cement, lime, sawdust) \_\_\_\_\_

-Landfill or offsite name/permit number? NA

WV Department of  
Environmental Protection

Permittee shall provide written notice to the Office of Oil and Gas of any load of drill cuttings or associated waste rejected at any West Virginia solid waste facility. The notice shall be provided within 24 hours of rejection and the permittee shall also disclose where it was properly disposed.


I certify that I understand and agree to the terms and conditions of the GENERAL WATER POLLUTION PERMIT issued on April 1, 2016, by the Office of Oil and Gas of the West Virginia Department of Environmental Protection. I understand that the provisions of the permit are enforceable by law. Violations of any term or condition of the general permit and/or other applicable law or regulation can lead to enforcement action.

I certify under penalty of law that I have personally examined and am familiar with the information submitted on this application form and all attachments thereto and that, based on my inquiry of those individuals immediately responsible for obtaining the information, I believe that the information is true, accurate, and complete. I am aware that there are significant penalties for submitting false information, including the possibility of fine or imprisonment.

Company Official Signature [Signature]

Company Official (Typed Name) Dee Southall

Company Official Title Senior Regulatory Analyst

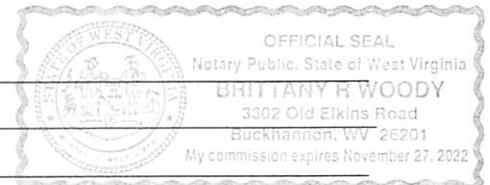

Subscribed and sworn before me this 19th day of March, 20 18

Brittany R Woody Notary Public

My commission expires 11/27/22

04/27/2018

Proposed Revegetation Treatment: Acres Disturbed 6.40 Prevegetation pH \_\_\_\_\_

Lime as determined by pH test min. 2 Tons/acre or to correct to pH 5.53

Fertilizer type 10-20-20

Fertilizer amount 600 lbs/acre

Mulch Hay/Straw 2.5 Tons/acre

Seed Mixtures

**Temporary**

**Permanent**

Seed Type lbs/acre

Seed Type lbs/acre

**\*\*See Attachment**

Attach:

Maps(s) of road, location, pit and proposed area for land application (unless engineered plans including this info have been provided). If water from the pit will be land applied, provide water volume, include dimensions (L, W, D) of the pit, and dimensions (L, W), and area in acres, of the land application area.

Photocopied section of involved 7.5' topographic sheet.

Plan Approved by: 

Comments: \_\_\_\_\_

\_\_\_\_\_

\_\_\_\_\_

Title: Oil + Gas Inspector Date: 3-14-18

Field Reviewed? (  ) Yes (  ) No

RECEIVED  
Office of Oil and Gas

MAR 21 2018

WV Department of  
Environmental Protection



# WVD Seeding Specification



To Order Seed contact Lyndsi Eddy Flippo office 570-996-4271 cell 501-269-5451 lyndsi\_eddy@swn.com (please allow 7 to 10 days for delivery)

NON-ORGANIC PROPERTIES	
Seed Mixture: ROW Mix	SWN Supplied
Orchardgrass	40%
Timothy	15%
Annual Ryegrass	15%
Brown Top Millet	5%
Red Top	5%
Medium Red Clover	5%
White Clover	5%
Birdsfoot Trefoil	5%
Rough Bluegrass	5%
All legumes are inoculated at 5x normal rate	
Apply @ 100lbs per acre April 16th- Oct. 14th	
Apply @ 200lbs per acre Oct. 15th- April 15th PLUS 50lbs per acre of Winter Wheat	

SOIL AMENDMENTS	
10-20-20 Fertilizer	*Apply @ 500lbs per Acre
Pelletized Lime	Apply @ 2 Tons per Acre
*unless otherwise dictated by soil test results	

**Seeding Calculation Information:**  
 1452' of 30' ROW/LOD is One Acre  
 871' of 50' ROW/LOD is One Acre  
 622' of 70' ROW/LOD is One Acre

**Synopsis:**  
 Every 622 linear feet in a 70' ROW/LOD, you should be using (2) 50lb bags of seed, (4) 50lb bags of fertilizer and (80) 50lb bags of Lime (2x seed in winter months + 50lb Winter Wheat/ac).

**Special Considerations:**  
 Landowner Special Considerations including CREP program participants require additional guidance that is not given here. Discuss these requirements with SWN supervision at the beginning of the project to allow time for special seed delivery.

ORGANIC PROPERTIES	
Seed Mixture: SWN Production Organic Mix	SWN Supplied
Organic Timothy	50%
Organic Red or White Clover	50%
OR	
Organic Perennial Ryegrass	50%
Organic Red or White Clover	50%
Apply @ 100lbs per acre April 16th- Oct. 14th	
Apply @ 200lbs per acre Oct. 15th- April 15th	
Organic Fertilizer @ 200lbs per Acre	Pelletized Lime @ 2 Tons per Acre

WETLANDS (delineated as jurisdictional wetlands)	
Seed Mixture: Wetland Mix	SWN Supplied
VA Wild Ryegrass	20%
Annual Ryegrass	20%
Fowl Bluegrass	20%
Cosmos 'Sensation'	10%
Redtop	5%
Golden Tickseed	5%
Maryland Senna	5%
Showy Tickseed	5%
Fox Sedge	2.5%
Soft Rush	2.5%
Woolgrass	2.5%
Swamp Verbena	2.5%
Apply @ 25lbs per acre April 16th- Oct. 14th	
Apply @ 50lbs per acre Oct. 15th- April 15th	
NO FERTILIZER OR LIME INSIDE WETLAND LIMITS	

RECEIVED  
 Office of Oil and Gas  
 MAR 21 2018  
 WV Department of  
 Environmental Protection

103-02231W

NA

STATE OF WEST VIRGINIA  
DEPARTMENT OF ENVIRONMENTAL PROTECTION  
OFFICE OF OIL AND GAS  
GROUNDWATER PROTECTION PLAN

Operator Name: SWN Production Co., LLC  
Watershed (HUC 10): Steener Fork Quad: Wileyville  
Farm Name: Albert & Mary Hohman

1. List the procedures used for the treatment and discharge of fluids. Include a list of all operations that could contaminate the groundwater.

2. Describe procedures and equipment used to protect groundwater quality from the list of potential contaminant sources above.

3. List the closest water body, distance to closest water body, and distance from closest Well Head Protection Area to the discharge area.

4. Summarize all activities at your facility that are already regulated for groundwater protection.

RECEIVED  
Office of Oil and Gas  
MAR 21 2018  
WV Department of  
Environmental Protection

5. Discuss any existing groundwater quality data for your facility or an adjacent property.

04/27/2018

6. Provide a statement that no waste material will be used for deicing or fill material on the property.

7. Describe the groundwater protection instruction and training to be provided to the employees. Job procedures shall provide direction on how to prevent groundwater contamination.

8. Provide provisions and frequency for inspections of all GPP elements and equipment.

Signature: \_\_\_\_\_

Date: \_\_\_\_\_

**RECEIVED**  
**Office of Oil and Gas**  
**MAR 21 2018**  
**WV Department of**  
**Environmental Protection**

04/27/2018


103-07231W

RECEIVED  
Office of Oil and Gas  
MAR 21 2018  
WV Department of  
Environmental Protection

# ALBERT & MARY HOHMAN WTZ WELL PAD AS-BUILT AND EROSION & SEDIMENT CONTROL IMPROVEMENT PLAN

PROCTOR DISTRICT, WETZEL COUNTY, WEST VIRGINIA  
LYNN CAMP RUN WATERSHED

WILEYVILLE USGS 7.5 QUAD MAP

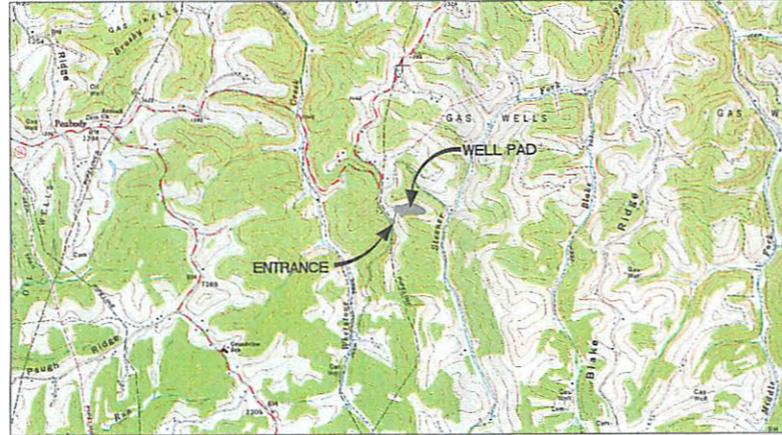

WEST VIRGINIA STATE PLANE COORDINATE SYSTEM  
NORTH ZONE, NAD83  
ELEVATION BASED SURVEY, GRADE GPS & OPUS  
POST-PROCESSING

**SHEET INDEX:**

- 1 - COVER SHEET
- 2 - LEGEND
- 3-4 - VICINITY MAP
- 5 - OVERALL PLAN SHEET INDEX
- 6 - ACCESS ROAD & WELL PAD AS-BUILT PLAN
- 7 - ACCESS ROAD AS-BUILT PROFILE
- 8-9 - WELL PAD AS-BUILT SECTIONS
- 10-11 - CONSTRUCTION DETAILS

**LOCATION COORDINATES:**  
ACCESS ROAD ENTRANCE  
LATITUDE: 39.695652 LONGITUDE: -80.709263 (NAD 83)  
N 4394018.82 E 524927.11 (UTM ZONE 17 METERS)  
CENTROID OF PAD  
LATITUDE: 39.696723 LONGITUDE: -80.707795 (NAD 83)  
N 4394138.13 E 525052.52 (UTM ZONE 17 METERS)  
EVACUATION GATHERING AREA  
LATITUDE: 39.695673 LONGITUDE: -80.709129 (NAD 83)  
N 4395491.45 E 530585.09 (UTM ZONE 17 METERS)

**GENERAL DESCRIPTION:**  
THE ACCESS ROAD(S) AND WELL PAD HAVE BEEN CONSTRUCTED TO AID IN THE DEVELOPMENT OF INDIVIDUAL MARCELLUS SHALE GAS WELLS.

**FLOODPLAIN NOTES:**  
THE PROPOSED SITE IS LOCATED WITHIN FEMA FLOOD ZONE 'X' PER FEMA FLOOD MAP #54103C0075C.

**MISS UTILITY STATEMENT:**  
MISS UTILITY SHALL BE NOTIFIED IF ANY ADDITIONAL EXCAVATION IS NECESSARY.

**PROJECT CONTACTS:**


**OPERATOR:**  
SOUTHWESTERN ENERGY  
179 INNOVATION DRIVE  
JANE LEW, WV 26378  
PHONE: (304) 617-1416  
**SHAWN JACKSON - FIELD PLANNING SUPERVISOR**  
OFFICE: (304) 884-1818 CELL: (304) 641-3204

**AS-BUILT ENGINEER/SURVEYOR:**  
NAVITUS ENGINEERING, INC.  
CYRUS S. KUMP, PE - PROJECT  
MANAGER/ENGINEER  
OFFICE: (888) 662-4185 CELL: (540) 686-6747

- NOTES:**
1. ALL BMP'S MUST REMAIN IN PLACE AND FUNCTIONAL UNTIL ALL AREAS WITHIN THE LIMIT OF DISTURBANCE ARE COMPLETELY AND PERMANENTLY STABILIZED. MAINTENANCE MUST INCLUDE INSPECTION OF ALL EROSION AND SEDIMENT CONTROLS AFTER EACH RUNOFF EVENT IN EXCESS OF 0.5" AND ON A BIWEEKLY BASIS.
  2. THE CONSTRUCTION SITE SHOULD BE STABILIZED AS SOON AS POSSIBLE AFTER COMPLETION. ESTABLISHMENT OF FINAL STABILIZATION MUST BE INITIATED NO LATER THAN 7 DAYS AFTER REACHING FINAL GRADE. FINAL STABILIZATION MEANS THAT ALL SOIL-DISTURBING ACTIVITIES ARE COMPLETED, AND THAT EITHER A PERMANENT VEGETATIVE COVER WITH A DENSITY OF 70% OR GREATER HAS BEEN ESTABLISHED OR THAT THE SURFACE HAS BEEN STABILIZED BY HARD COVER SUCH AS PAVEMENT OR BUILDINGS. IT SHOULD BE NOTED THAT THE 70% REQUIREMENT REFERS TO THE TOTAL AREA VEGETATED AND NOT JUST A PERCENT OF THE SITE.
  3. ALL PERMANENT SEDIMENT CONTROL MEASURES CAN BE REMOVED AFTER THE SITE IS PERMANENTLY STABILIZED AND APPROVAL IS RECEIVED FROM THE WVDEP.
  4. ANY AREAS DISTURBED BY REMOVAL OF CONTROLS SHALL BE REPAIRED, STABILIZED, AND PERMANENTLY SEEDED.
  5. THE AS-BUILT INFORMATION SHOWN HEREON REFLECTS FIELD DATA COLLECTED RELATING TO THE FINAL GRADING OF THE DISTURBED AREA AS OF AUGUST 31, 2017. NAVITUS ENGINEERING IS NOT RESPONSIBLE FOR ANY CHANGES MADE TO THE SITE AFTER THE ABOVE MENTIONED DATES.
  6. THE EXISTING CONTAINMENT BERM AROUND THE WELL PAD SHALL BE REPAIRED AS NECESSARY TO ENSURE 100% CONTAINMENT OF ALL FLUIDS PRIOR TO DRILLING OPERATIONS
  7. THE EXISTING EGREGESSES TO THE WELL PAD SHALL HAVE THE MOUNTABLE BERMS REPAIRED AS NECESSARY TO ENSURE 100% CONTAINMENT OF ALL FLUIDS PRIOR TO DRILLING OPERATIONS.

**ALBERT & MARY HOHMAN WTZ LIMITS OF DISTURBANCE AREA (AC)**

Total Site	
Access Road (444')	0.87
Well Pad	5.53
<b>Total Affected Area</b>	<b>6.40</b>
Impacts to County Route 1/11 RW	
Access Road (7')	0.02
<b>Total Affected Area</b>	<b>0.02</b>
Impacts to Albert & Mary Hohman TM 12 05-12	
Access Road (437')	0.85
Well Pad	5.53
<b>Total Affected Area</b>	<b>6.38</b>

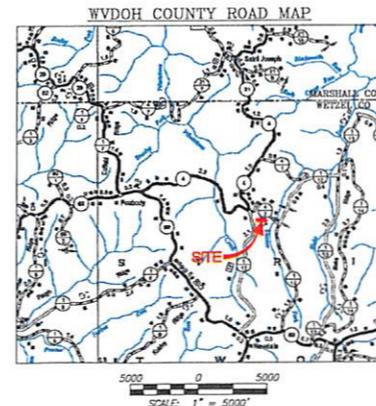

Well Name	Elev. (MSL)	WV North		UTM (METERS)		NAD 83	
		NAD 27	NAD 83	Zone 17	Lat & Long DMS	Lat & Long DD	
Albert & Mary Hohman 1 (Drilled)	1,285.11	N 438191.18	N 438197.71	N 4394143.28	LAT 39-41-44.5270	LAT 39.690913	
APM 47-103-02231		E 1660229.39	E 1628791.39	E 525502.90	LONG -80-42-28.3660	LONG -80.707324	

DMH  
3-14-18

**REPRODUCTION NOTE**  
THESE PLANS WERE CREATED TO BE PLOTTED ON 22"x34" (ANSI D) PAPER. HALF SCALE DRAWINGS ARE ON 11"x17" (ANSI B) PAPER.  
THESE PLANS WERE CREATED FOR COLOR PLOTTING AND ANY REPRODUCTIONS IN GRAY SCALE OR COLOR MAY RESULT IN A LOSS OF INFORMATION AND SHOULD NOT BE USED FOR CONSTRUCTION PURPOSES.

**AS-BUILT CERTIFICATIONS:**  
THE DRAWINGS, CONSTRUCTION NOTES, AND REFERENCE DIAGRAMS ATTACHED HERETO HAVE BEEN PREPARED IN ACCORDANCE WITH THE WEST VIRGINIA CODE OF STATE RULES, DIVISION OF ENVIRONMENTAL PROTECTION, OFFICE OF OIL AND GAS CRS 35-8.

MISS Utility of West Virginia  
1-800-245-4848  
West Virginia State Law  
(Section XIV: Chapter 24-C)  
Requires that you call two business days before you dig in the state of West Virginia.  
IT'S THE LAW!!

**EX. WELL PAD HAS BEEN RECLAIMED.  
PAD CONTAINMENT WILL NEED TO BE  
ESTABLISHED FOR FUTURE DRILLING.**

**NAVITUS**  
ENERGY ENGINEERING  
Telephone: (888) 662-4185 | www.NavitusEng.com

REVISION	DATE

**sw**  
Southwestern Energy  
THIS DOCUMENT WAS PREPARED FOR: SOUTHWESTERN ENERGY

COVER SHEET  
**ALBERT & MARY HOHMAN WTZ**  
WELL PAD  
PROCTOR DISTRICT  
WETZEL COUNTY, WEST VIRGINIA



DATE: 09/27/2017  
SCALE: AS SHOWN  
SHEET 1 OF 11

103-0223/W

# LEGEND

LEGEND			
EX. INDEX CONTOUR & CONTOUR LABEL		PR. INDEX CONTOUR (10' INTERVAL) & CONTOUR LABEL	
EX. INTERMEDIATE CONTOUR		PR. INTERMEDIATE CONTOUR (2' INTERVAL)	
EX. PROPERTY LINE		PR. INTERMEDIATE CONTOUR (1' INTERVAL)	
EX. TOP OF BERM		PR. INDEX ROAD CONTOUR (10' INTERVAL) & CONTOUR LABEL	
EX. ROAD EDGE OF GRAVEL/DIRT		PR. INTERMEDIATE ROAD CONTOUR (2' INTERVAL)	
EX. ROAD EDGE OF PAVEMENT		PR. PADS/STOCKPILE TOPO LIMITS	
EX. ROAD CENTERLINE		PERMITTED LIMITS OF DISTURBANCE	
EX. GUARDRAIL		MODIFICATION LIMITS OF DISTURBANCE	
EX. BRIDGE		PR. ROAD/IMPONEMENT EDGE OF GRAVEL	
EX. DITCHLINE/DRAINAGE FEATURE		PR. ROAD CENTERLINE	
EX. RIP-RAP		PR. GUARDRAIL	
EX. CULVERT		PR. ROCK CONSTRUCTION ENTRANCE	
EX. TRESTLE		PR. AIR BRIDGE	
EX. BUILDING		PR. CULVERT	
EX. MISCELLANEOUS FEATURE		PR. DITCH	
EX. 100 YR FEMA FLOODPLAIN		PR. RIP-RAP TRAPEZOIDAL DITCH	
EX. DELINEATED STREAM		PR. OUTLET PROTECTION	
EX. DELINEATED WETLAND/POND		PR. DIVERSION	
100' WETLAND/STREAM BUFFER		PR. ROCK LEVEL SPREADER	
STREAM/WETLAND DELINEATION STUDY AREA		PR. COMPOST FILTER SOCK	
EX. FENCELINE		PR. SUPER SILT FENCE	
EX. GATE		PR. WELL HEAD	
EX. PERMETER SAFETY FENCE		PR. PAD DEWATERING SYSTEM	
EX. ACCESS GATE WITH EMERGENCY LIFELINE		PR. TOP OF PAD CONTAINMENT BERM	
EX. WELL HEAD ON DESIGNED PAD		PR. 220' X 320' PAD FOOTPRINT	
EX. GAS WELL		PR. SPOT SHOT	
EX. PIPELINE		PR. PERMETER SAFETY FENCE	
EX. PIPELINE R/W		PR. ACCESS GATE WITH EMERGENCY LIFELINE	
EX. PIPELINE METER		PR. PIPELINE	
EX. PIPELINE VALVE		PR. PIPELINE R/W	
EX. PIT		PR. OVERHEAD UTILITY	
EX. OVERHEAD UTILITY		PR. POWER POLE/GUY WIRE	
EX. POWER POLE/GUY WIRE		PR. OVERHEAD UTILITY R/W	
EX. UNDERGROUND ELECTRIC		PR. WATERLINE	
EX. UNDERGROUND TELEPHONE		BORING LOCATION	
EX. UNDERGROUND FIBER OPTIC		X-SECTION/PROFILE GRID INDEX	
EX. UTILITY R/W		X-SECTION/PROFILE GRID INTERMEDIATE	
EX. WATERLINE		X-SECTION/PROFILE PROPOSED GRADE	
EX. WATER WELL/EX. SPRING		X-SECTION/PROFILE EXISTING GRADE	
EX. COMPOST SOCK		X-SECTION/PROFILE WATER SURFACE	
EX. SUPER SILT FENCE		X-SECTION/PROFILE CULVERT	
EX. SILT FENCE		MATCHLINE	
APPROX. LOCATION OF SLIDE AREA		EX. MUSTER AREA	
APPROX. LOCATION OF BOSROW/ SPOOL AREA		EX. MAILBOX	
PR. TOE BENCH		EX. TEG	
EX. APPROX. SURFACE & SUB-SURFACE WELL LINE AREA		EX. VHU	
EX. APPROX. SURFACE & SUB-SURFACE BLOW-DOWN/DUMP LINE AREA		EX. VHT	
EX. ESD & APPROX. SURFACE & SUB-SURFACE ESD LINE		EX. BTEX	
EX. APPROX. SURFACE & SUB-SURFACE SALES LINE AREA		EX. COMPRESSOR	
EX. CONDENSATE LINE		EX. FLARE DRUM & BLOW CASE	
EX. PRODUCED WATER LINE		EX. METER SKID	
EX. FLASH GAS/MAKEUP GAS/ FUEL SUPPLY LINE		EX. REBOILER	
EX. ABOVE-GND VAPOR LINE		EX. DEHY W/ REBOILER	
EX. SECONDARY CONTAINMENT		EX. STORAGE TANK	
		EX. STABILIZER	
		EX. WELL PAD DEWATERING SYSTEM	

**NAVITUS**  
ENERGY ENGINEERING  
Telephone: (888) 662-4183 | www.NavitusEng.com

REVISION	DATE

**sw**  
Southwestern Energy  
THIS DOCUMENT  
WAS PREPARED FOR:  
SOUTHWESTERN ENERGY


**ALBERT & MARY HOHMAN WITZ**  
WELL PAD  
PROCTOR DISTRICT  
WETZEL COUNTY, WEST VIRGINIA



DATE: 09/27/2017  
SCALE: N/A  
SHEET 2 OF 11



GRID NORTH AND ELEVATIONS SHOWN  
HEREIN WERE ESTABLISHED BY  
SURVEY GRADE CPS

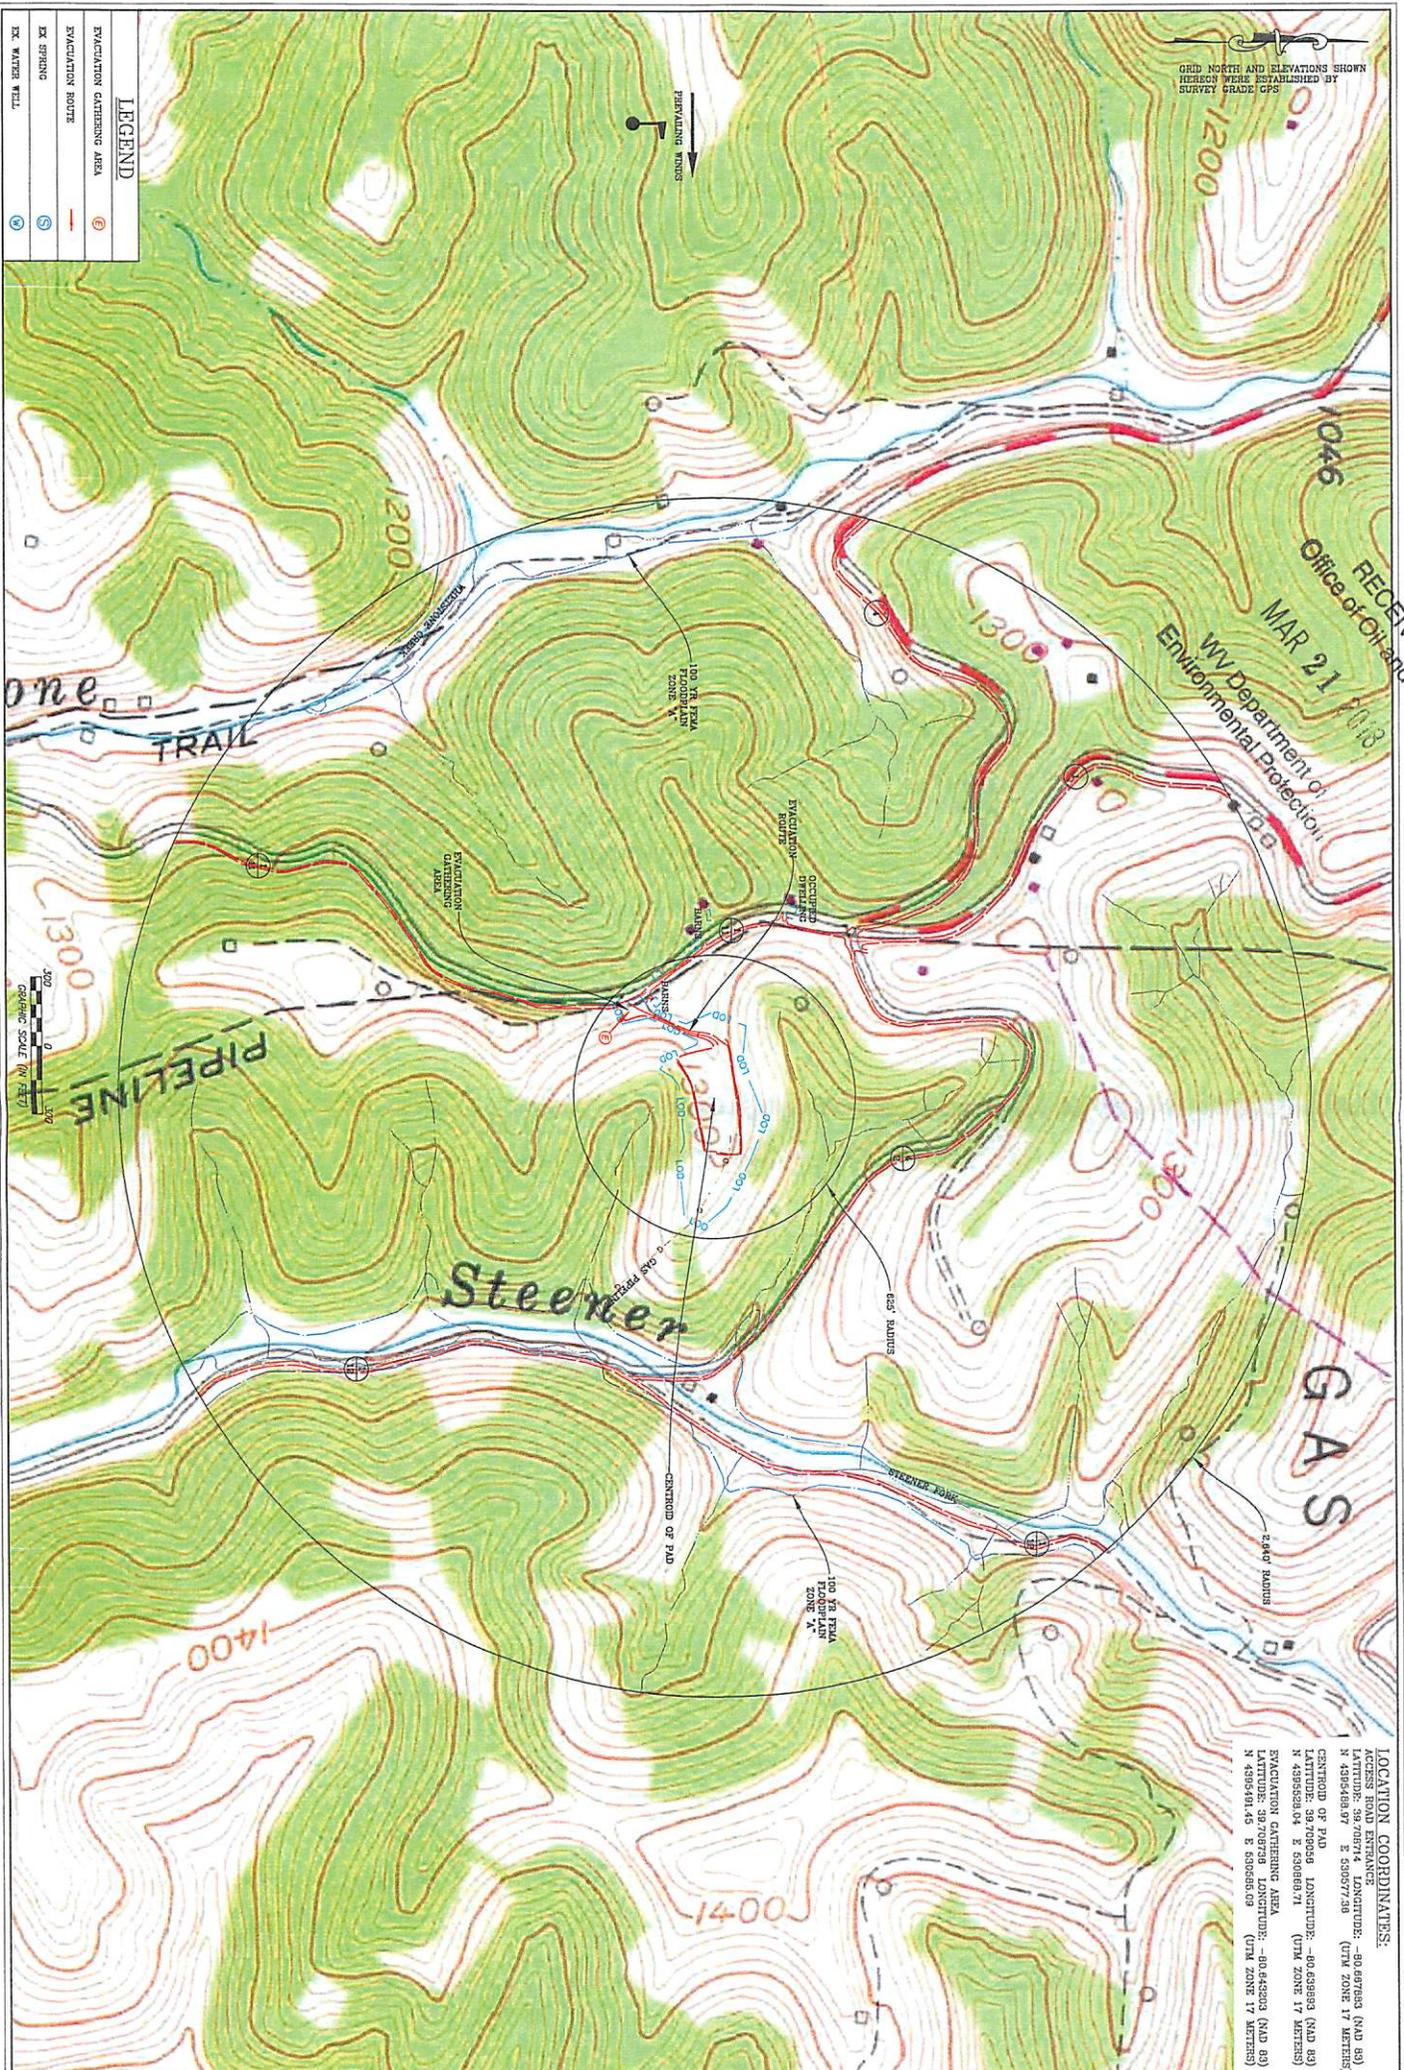

RECEIVED  
MAR 21 2018  
WV Department of  
Environmental Protection  
Office of Oil and Gas

LOCATION COORDINATES:  
ACCESS ROAD ENTRANCE  
LATITUDE: 39.701714 LONGITUDE: -80.639933 (NAD 83)  
N 4829381.04 E 550077.58 (UTM ZONE 17 4829381)  
CENTROID OF PAD  
LATITUDE: 39.700826 LONGITUDE: -80.639933 (NAD 83)  
N 4829381.04 E 550077.58 (UTM ZONE 17 4829381)  
EVACUATION GATHERING AREA  
LATITUDE: 39.700826 LONGITUDE: -80.639933 (NAD 83)  
N 4829381.04 E 550077.58 (UTM ZONE 17 4829381)

**LEGEND**

EVACUATION GATHERING AREA	(Symbol: Circle with dot)
EVACUATION ROUTE	(Symbol: Dashed line)
EX SPRING	(Symbol: Circle with 'S')
EX WATER WELL	(Symbol: Circle with 'W')



DATE: 09/27/2017  
SCALE: 1" = 300'  
SHEET 4 OF 11

VICINITY MAP  
**ALBERT & MARY HOHMAN WTZ**  
WELL PAD  
PROCTOR DISTRICT  
WETZEL COUNTY, WEST VIRGINIA

**SWM**  
Southwestern Energy  
THIS DOCUMENT  
WAS PREPARED FOR:  
SOUTHWESTERN ENERGY

DATE	REVISION

**NAVITUS**  
ENERGY ENGINEERING  
Telephone: (888) 652-4185 | www.NavitusEng.com

04/27/2018

103-02231W

RECEIVED  
Office of Oil and Gas  
MAR 21 2018  
WV Department of  
Environmental Protection

# OVERALL PLAN SHEET INDEX

**NAVITUS**  
ENERGY ENGINEERING  
Telephone: (888) 962-4187 | www.NavitusEng.com

GRID NORTH AND ELEVATIONS SHOWN HEREON WERE ESTABLISHED BY SURVEY GRADE GPS

TM 12-0812  
ALBERT &  
MARY HOHMAN

TM 12-0811.3  
ANNA L. &  
STEVE  
RAYMOND  
HOHMAN

TM 12-0811.4  
ROBERT FRANCIS  
NICK & MARY JO  
VILLES

TM 12-0801  
LAWRENCE E.  
HRS & RAYMOND  
A. SCHEIBELHOOD

SHEET 5

TM 12-0801  
LAWRENCE E.  
HRS & RAYMOND  
A. SCHEIBELHOOD

TM 12-0812  
ALBERT &  
MARY HOHMAN

WELL PAD

SHEET 5

TM 12-0812  
ALBERT &  
MARY HOHMAN

REVISION	DATE

**sw**  
Southwestern Energy  
THIS DOCUMENT  
WAS PREPARED FOR:  
SOUTHWESTERN ENERGY

OVERALL PLAN SHEET INDEX  
**ALBERT & MARY HOHMAN WIZ**  
WELL PAD  
PROCTOR DISTRICT  
WETZEL COUNTY, WEST VIRGINIA



DATE: 09/27/2017  
SCALE: 1" = 100'  
SHEET 5 OF 11

- NOTES:**
1. THE AS-BUILT INFORMATION SHOWN HEREON REFLECTS FIELD DATA COLLECTED RELATING TO THE FINAL GRADING OF THE DISTURBED AREA AS OF AUGUST 31, 2017.
  2. THE PROPERTY LINES SHOWN HEREON DO NOT REPRESENT A BOUNDARY SURVEY ON ANY OF THE PARCELS SHOWN. THE PROPERTY LINES ARE BASED ON COUNTY REAL ESTATE TAX MAPS, GIS INFORMATION AND DEEDS OF RECORD.
  3. UTILITIES AND THEIR LOCATIONS AS SHOWN HEREON ARE BASED ON OBSERVABLE EVIDENCE OF THOSE VISIBLE, ABOVE-GROUND FACILITIES, FEATURES, AND MARKERS WHICH WERE FOUND ON THE SUBJECT PROPERTY AT THE TIME OF SURVEY PERFORMED BY NAVITUS ENGINEERING. NAVITUS ENGINEERING CANNOT GUARANTEE THE ACCURACY OF THE UTILITY MARKINGS PERFORMED BY OTHERS OR THAT ALL UTILITIES EXISTING WITHIN THE LIMITS OF THIS PLAN ARE SHOWN. ANY UTILITIES ENCOUNTERED SUBSEQUENT TO PLAN APPROVAL OR DURING CONSTRUCTION THAT ARE NOT SHOWN ON THE PLAN SHOULD BE REPORTED TO NAVITUS ENGINEERING AND SOUTHWESTERN ENERGY.



**LEGEND**


EVACUATION GATHERING AREA	(E)
EVACUATION ROUTE	→

DMH  
3-14-18

103-02231W

# ACCESS ROAD & WELL PAD AS-BUILT PLAN

RECEIVED  
Office of Oil and Gas  
MAR 21 2018  
WV Department of  
Environmental Protection

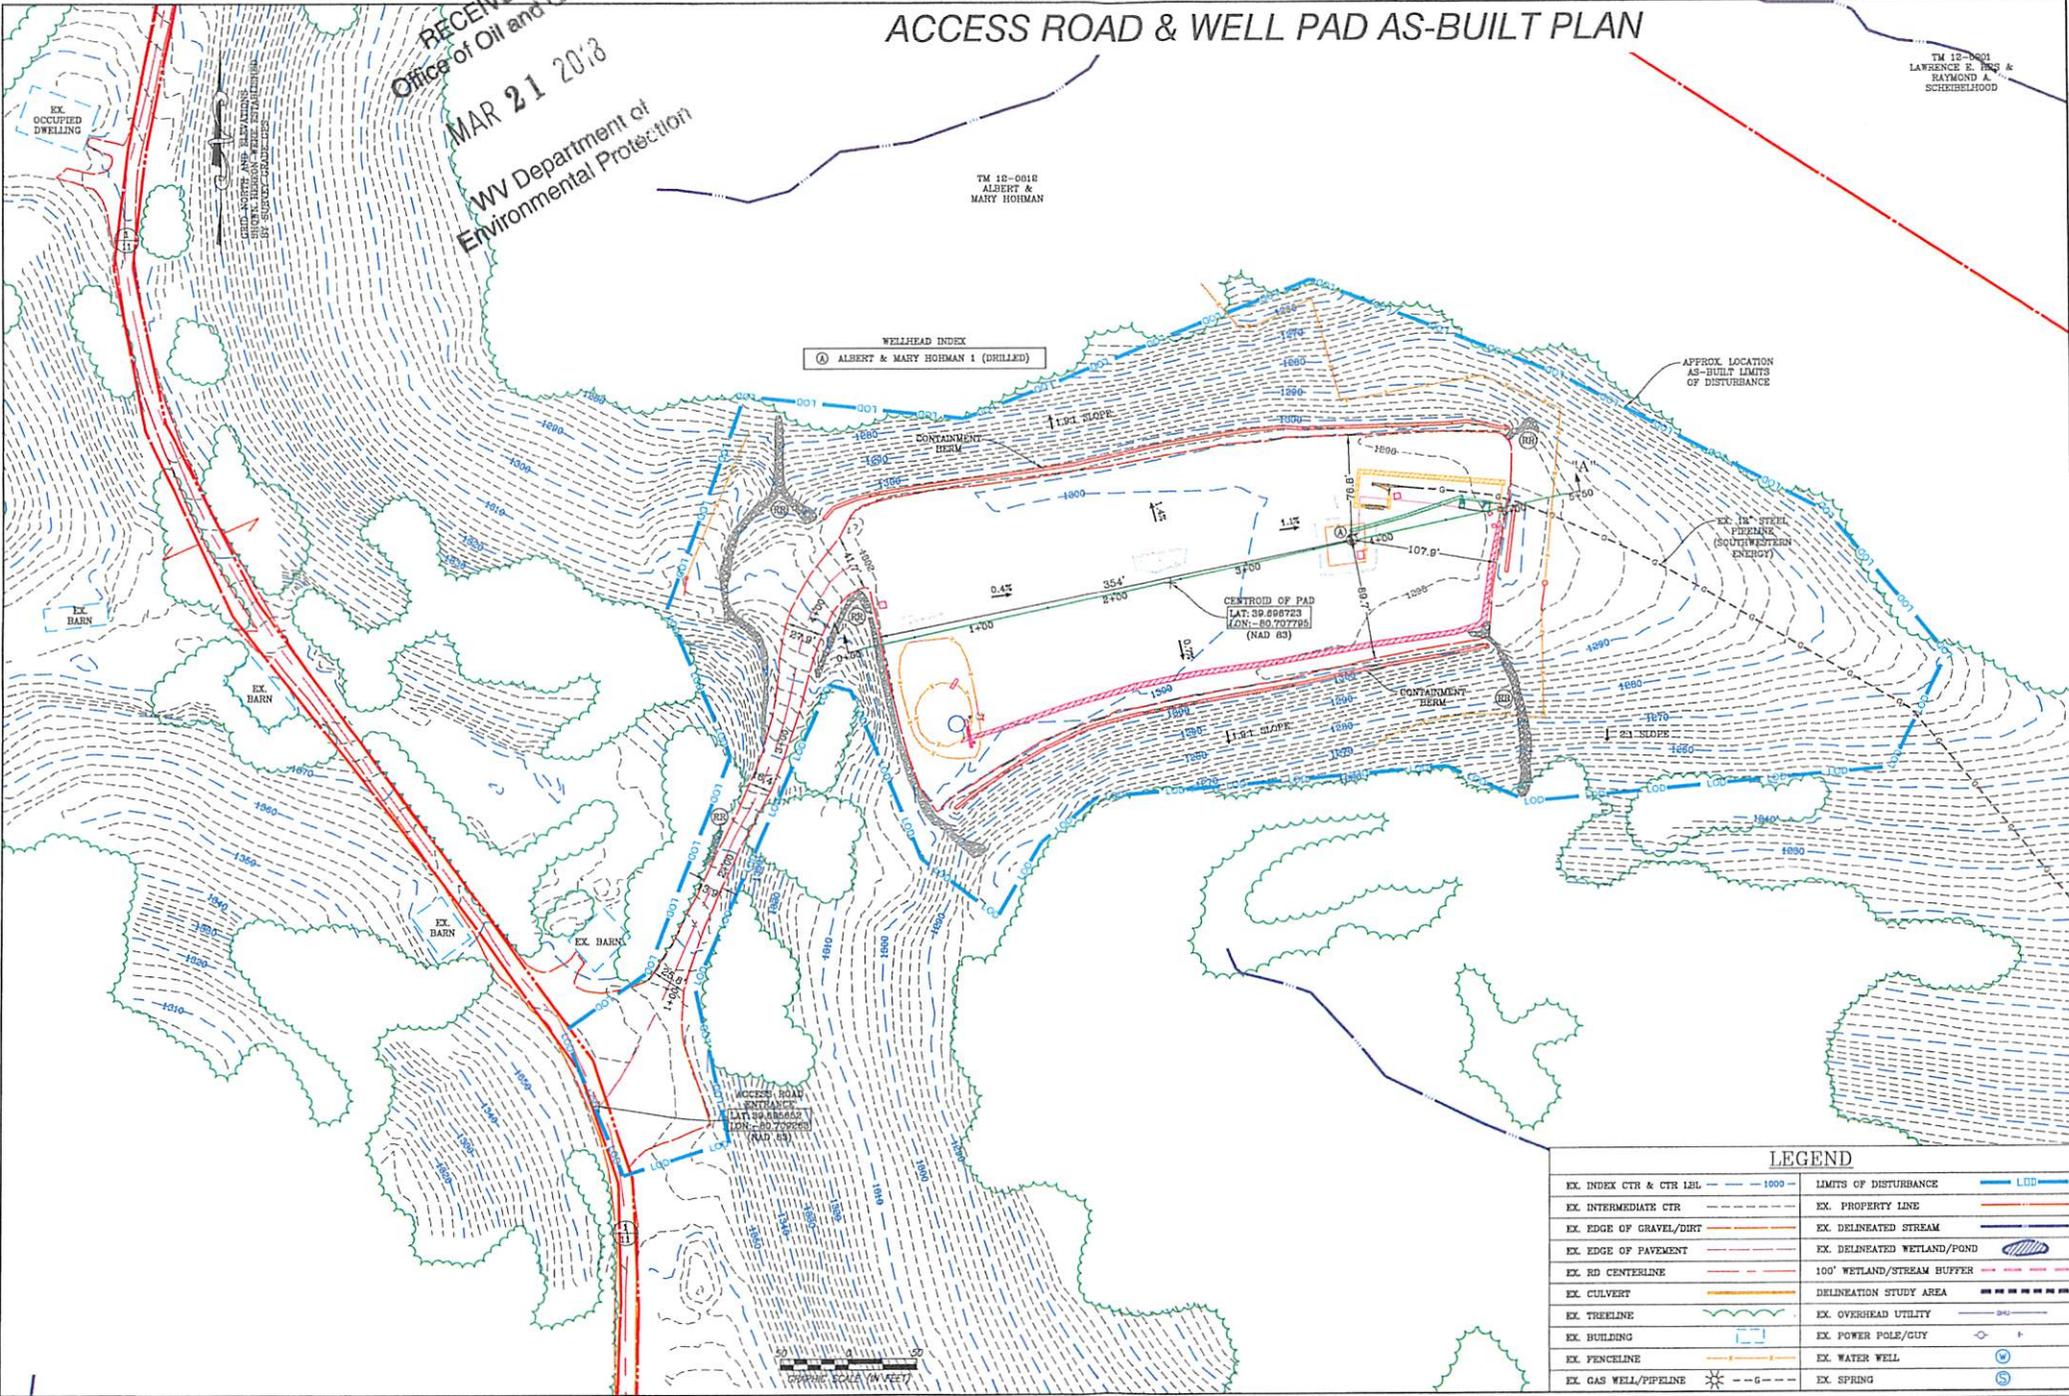

WELLHEAD INDEX  
① ALBERT & MARY HOHMAN 1 (DRILLED)

ACCESS ROAD  
CENTROID  
LAT: 39.886852  
LON: -80.739249  
(NAD 83)

CENTROID OF PAD  
LAT: 39.898723  
LON: -80.737765  
(NAD 83)

### LEGEND

EX. INDEX CTR & CTR LBL	--- 1000 ---	LIMITS OF DISTURBANCE	---
EX. INTERMEDIATE CTR	---	EX. PROPERTY LINE	---
EX. EDGE OF GRAVEL/DIRT	---	EX. DELINEATED STREAM	---
EX. EDGE OF PAVEMENT	---	EX. DELINEATED WETLAND/POND	---
EX. RD CENTERLINE	---	100' WETLAND/STREAM BUFFER	---
EX. CULVERT	---	DELINEATION STUDY AREA	---
EX. TREELINE	---	EX. OVERHEAD UTILITY	---
EX. BUILDING	---	EX. POWER POLE/GUY	---
EX. FENCELINE	---	EX. WATER WELL	---
EX. GAS WELL/PIPELINE	---	EX. SPRING	---

**NAVITUS**  
ENERGY ENGINEERING  
Telephone: (888) 662-4162 | www.navitusEng.com

REVISION	DATE

**sw**  
Southwestern Energy  
THIS DOCUMENT  
WAS PREPARED FOR:  
SOUTHWESTERN ENERGY

ACCESS ROAD & WELL PAD AS-BUILT PLAN  
**ALBERT & MARY HOHMAN WTZ**  
WELL PAD  
PROCTOR DISTRICT  
WETZEL COUNTY, WEST VIRGINIA



DATE: 09/27/2017  
SCALE: 1" = 50'  
SHEET 6 OF 11









STANDARD STAKEOUT RIBBON COLOR SCHEME  
N.T.S.





	YELLOW RIBBON: YELLOW RIBBON USED TO INDICATE TOP OF CUTS (C)
	YELLOW AND ORANGE RIBBON: YELLOW AND ORANGE RIBBON USED TO INDICATE GRADE AT TOP OF PAD/POND/YIT
	ORANGE RIBBON: ORANGE RIBBON USED TO INDICATE TOES OF FILLS (F)
	PINK RIBBON: PINK RIBBON USED TO INDICATE TOP HOLE LOCATION
	PINK & BLACK STRIPE RIBBON: PINK & BLACK STRIPE RIBBON USED TO INDICATE VERTICAL CUT (VC) AT PAD/POND/YIT CORNER OR EDGE. PINK & BLACK STRIPE RIBBON USED TO INDICATE VERTICAL FILL (VF) AT PAD/POND/YIT CORNER OR EDGE.
	WHITE RIBBON: WHITE RIBBON USED TO INDICATE LIMITS OF DISTURBANCE
	WHITE & BLUE RIBBON: WHITE & BLUE RIBBON USED TO INDICATE LIMITS OF CLEARING
	PINK & WHITE STRIPE RIBBON: PINK & WHITE STRIPE RIBBON USED TO INDICATE EROSION AND SEDIMENT CONTROL STRUCTURES
	ORANGE & WHITE STRIPE RIBBON: ORANGE & WHITE STRIPE RIBBON USED TO INDICATE TOPSOIL STOCKPILE LOCATIONS
	BLUE RIBBON: BLUE RIBBON USED TO INDICATE CENTERLINE (CL) DITCH
	BLUE RIBBON: BLUE RIBBON USED TO INDICATE BOTTOM (BTM) SEDIMENT TRAPS
	PINK & WHITE RIBBON: PINK & WHITE RIBBON USED TO INDICATE WETLANDS
	LIME GREEN & ORANGE RIBBON: LIME GREEN & ORANGE RIBBON USED TO INDICATE CENTERLINE (CL) OR EDGE OF LEASE ROAD
	GREEN RIBBON: GREEN RIBBON USED TO INDICATE CULVERT CROSSINGS

CELLAR DETAIL  
N.T.S.

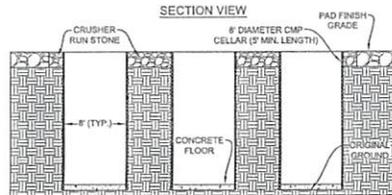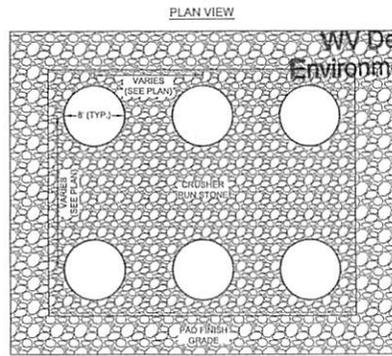


- NOTES:  
1. ALL STONE PLACED ON PAD AND AROUND THE CELLARS SHALL BE COMPACTED.  
2. CELLARS SHALL BE INSTALLED AND SURFACE GRADED TO PREVENT WATER COLLECTION IN CELLARS.

TYPICAL R.E.C.P. (ROLLED EROSION CONTROL PRODUCT) SLOPE INSTALLATION  
N.T.S.

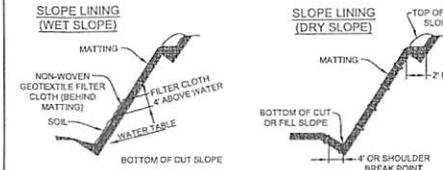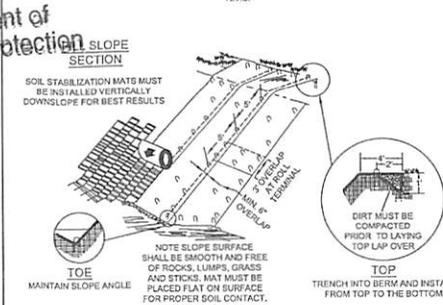

MODIFIED SOURCE: VDOT STANDARDS AND VIRGINIA DECORING

COMPOST FILTER SOCK  
N.T.S.

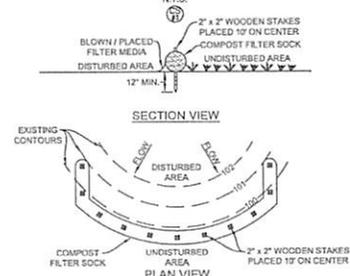


ADAPTED FROM FILTERXXX  
SOCK FABRIC SHALL MEET STANDARDS OF TABLE 4.1. COMPOST SHALL MEET THE FOLLOWING STANDARDS:

ORGANIC MATTER CONTENT	FIBROUS AND ELONGATED
80%-100% (DRY WEIGHT BASIS)	
pH	5.5-8.0
MOISTURE CONTENT	35%-55%
PARTICLE SIZE	98% PASS THROUGH 1\" SCREEN
SOLUBLE SALT CONCENTRATION	5.0 G/G MAXIMUM


- NOTES:  
1. COMPOST FILTER SOCK SHALL BE PLACED AT EXISTING LEVEL GRADE. BOTH ENDS OF THE SOCK SHALL BE EXTENDED AT LEAST 8' UP THE SLOPE OR TO A HEIGHT EQUAL TO THE EFFECTIVE SOCK HEIGHT, WHICHEVER IS GREATER AT 45° TO THE MAIN SOCK ALIGNMENT. MAXIMUM SLOPE LENGTH AND ANY SOCK SHALL NOT EXCEED MANUFACTURER'S MAXIMUM PERMISSIBLE SLOPE LENGTH.  
2. TRAFFIC SHALL NOT BE PERMITTED TO CROSS FILTER SOCKS.  
3. ACCUMULATED SEDIMENT SHALL BE REMOVED WHEN IT REACHES 1/2 THE ABOVE GROUND HEIGHT OF THE SOCK AND DISPOSED IN THE MANNER DESCRIBED ELSEWHERE IN THE PLAN.  
4. SOCKS SHALL BE INSPECTED WEEKLY AND AFTER EACH RUNOFF EVENT. DAMAGED SOCKS SHALL BE REPAIRED ACCORDING TO MANUFACTURER'S SPECIFICATIONS OR REPLACED WITHIN 24 HOURS OF INSPECTION.  
5. BIODEGRADABLE FILTER SOCKS SHALL BE REPLACED AFTER 6 MONTHS; PHOTODEGRADABLE SOCKS AFTER 1 YEAR. POLYPROPYLENE SOCKS SHALL BE REPLACED ACCORDING TO MANUFACTURER'S RECOMMENDATIONS.  
6. UPON STABILIZATION OF THE AREA TRIBUTARY TO THE SOCK, STAKES SHALL BE REMOVED. THE SOCK MAY BE LEFT IN PLACE AND VEGETATED OR REMOVED. IN THE LATTER CASE, THE MESH SHALL BE CUT OPEN AND THE MULCH SPREAD AS A SOIL SUPPLEMENT.  
7. IN THE EVENT THE GROUND IS FROZEN, REBAR WITH SAFETY CAPS SHALL BE USED INSTEAD OF WOODEN STAKES TO ANCHOR THE FILTER SOCK. ONCE THE GROUND THAW, THE REBAR ANCHORS SHALL BE REMOVED AND REPLACED WITH 2\" x 2\" WOODEN STAKES AND INSTALLED AS SHOWN IN THE DETAIL ABOVE.

MOUNTABLE BERM  
N.T.S.

PLAN VIEW

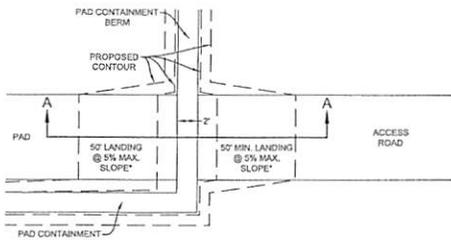


CROSS-SECTION A-A

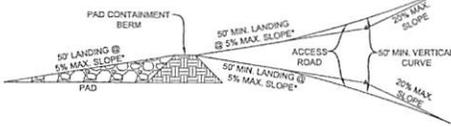


- NOTES:  
1. MOUNTABLE BERMS THAT DO NOT SERVE AS THE MAIN PAD ACCESS MAY BE STEEPER THAN 5% IF NOTED IN THE PLANS.

SLOPE TRACKING  
N.T.S.

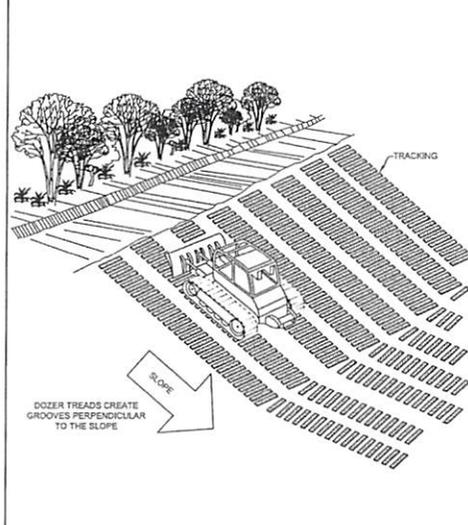

- NOTES:  
1. TRACKING SLOPES ARE DONE BY RUNNING TRACKED MACHINERY UP AND DOWN THE SLOPE, LEAVING TREAD MARKS PARALLEL TO THE CONTOUR. IF A BULLDOZER IS USED, THE BLADE SHOULD BE UP.

WELL PAD UNDERDRAIN CATCH BASIN & OUTLET  
N.T.S.

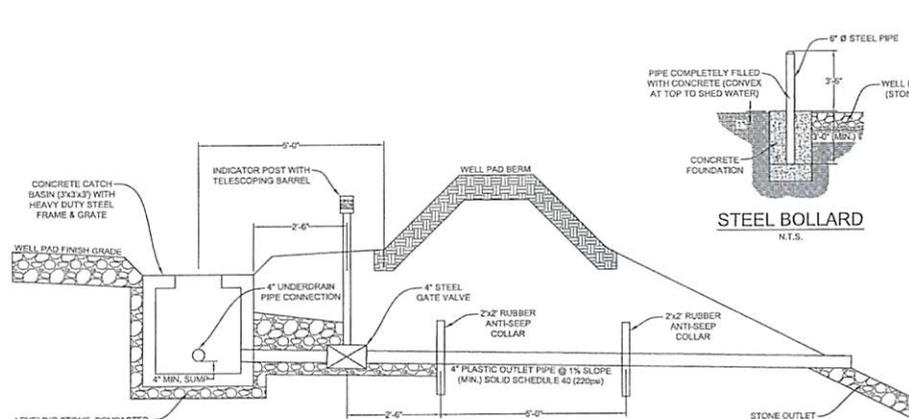

- NOTES:  
1. UNDERDRAIN #10 LOW INVERT ELEVATIONS SHALL BE ABOVE THE TOP OF THE DISCHARGE TO PREVENT BACKFLOW INTO THE UNDERDRAIN.  
2. TOP OF CONCRETE CATCH BASIN SHALL BE SET BELOW THE FINISH STONE GRADE OF THE WELL PAD TO ENSURE SURFACE WATER CAN FLOW INTO THE BASIN.  
3. STEEL GATE VALVE, INDICATOR POST WITH TELESCOPING BARREL, AND ANTI-SEEP COLLARS SHALL BE INSTALLED PER MANUFACTURER'S RECOMMENDATIONS.  
4. LOCATION AND HEIGHT OF INDICATOR POST SHALL BE FIELD VERIFIED FOR ACCESSIBILITY BY OWNER PRIOR TO INSTALLATION.  
5. THERE SHALL BE NO DISCHARGE THROUGH WELL PAD OUTLETS FROM DRILL PAD DURING DRILLING OR COMPLETION ACTIVITIES.  
6. ALL GATE VALVES SHALL BE CLOSED DURING WELL PAD DRILLING OR COMPLETION ACTIVITIES.  
7. CATCH BASIN SHALL BE PROTECTED BY STEEL BOLLARDS AS SHOWN ON THE PLAN AND INSTALLED PER THE STEEL BOLLARD DETAIL.

NAVITUS  
ENERGY ENGINEERING  
Telephone: (888) 692-4455 | www.NavitusEng.com

REVISION	DATE

sw  
Southwestern Energy  
THIS DOCUMENT WAS PREPARED FOR: SOUTHWESTERN ENERGY

CONSTRUCTION DETAILS  
ALBERT & MARY HOHMAN WITZ  
WELL PAD  
PROCTOR DISTRICT  
WEITZEL COUNTY, WEST VIRGINIA





DATE: 09/27/2017  
SCALE: AS SHOWN  
SHEET 10 OF 11





**SURVEYORS  
ENGINEERS  
ENVIRONMENTAL  
GIS MAPPING**

www.jhacompanies.com  
68011 Vineyard Road  
St. Clairsville, Ohio 43950  
740-695-6100

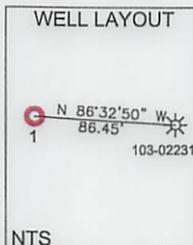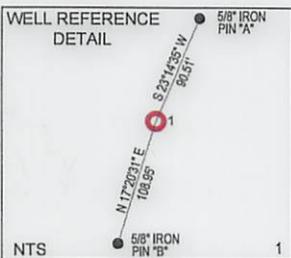


**NOTES ON SURVEY**

1. COORDINATE SYSTEM IS UTM NAD 83 DATUM, ZONE 17, U.S. FOOT AND WELL COORDINATES ESTABLISHED USING SURVEY GRADE GPS.
2. SURFACE AND ROYALTY OWNER INFORMATION AND THEIR BOUNDARIES SHOWN HEREON WERE PLOTTED FROM DEEDS AND/OR TAX PARCEL MAPS PROVIDED BY CLIENT AND/OR FIELD LOCATIONS.
3. THIS PLAT DOES NOT REPRESENT A BOUNDARY SURVEY OF THE PARCELS SHOWN HEREON.
4. NO DWELLINGS OR BUILDINGS WITHIN 625 FEET OF PROPOSED CENTER OF PAD
5. NO PERENNIAL STREAMS, LAKES, PONDS, RESERVOIRS OR WETLANDS WITHIN 100 FEET OF THE LIMITS OF DISTURBANCE.
6. NO NATURALLY PRODUCING TROUT STREAM WITHIN 300 FEET OF THE LIMITS OF DISTURBANCE.
7. NO WATER WELLS OR DEVELOPED SPRINGS WITHIN 250 FEET OF PROPOSED WELL.

GRID NORTH  
UTM, NAD83 DATUM, ZONE 17, US FT




LINE	BEARING	DISTANCE
L1	N 51°49'23" E	1675.38'
L2	S 18°24'24" E	628.31'

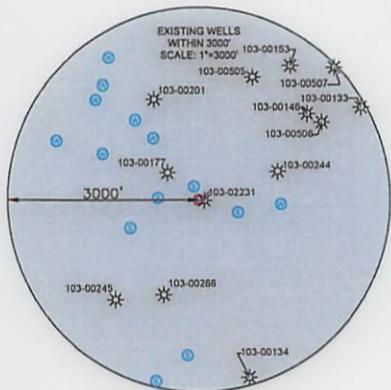

TRACT	SURFACE OWNER (S) / ROYALTY OWNER (R)	TAX PARCEL
1	ALBERT L. HOHMAN & MARY HOHMAN (TRUSTEES OF THE HOHMAN REVOCABLE TRUST, DATED AUGUST 8, 2014) (S/R)	12-8-12

TRACT	SURFACE OWNER	TAX PARCEL
A	JOSEPH & SUSANNA VILLERS (LIFE ESTATE) AND ROBERT FRANCIS VILLERS (REMAINDERMAN)	12-8-11.1
B	PATRICK A. SCHEIBELHOOD; THEODORE N. SCHEIBELHOOD; EDWARD L. SCHEIBELHOOD; THERESA SHUTLER; CLARA SCHEIBELHOOD; MARGARET SCHEIBELHOOD; MARSHA ECHARD; MARK SCHEIBELHOOD; MATTHEW SCHEIBELHOOD; & NICHOLAS SCHEIBELHOOD	12-9-1
C	MARGARET, SUE KELLEY	12-9-17
D	PATRICK A. SCHEIBELHOOD; THEODORE N. SCHEIBELHOOD; EDWARD L. SCHEIBELHOOD; THERESA SHUTLER; CLARA SCHEIBELHOOD; MARGARET SCHEIBELHOOD; MARSHA ECHARD; MARK SCHEIBELHOOD; MATTHEW SCHEIBELHOOD; & NICHOLAS SCHEIBELHOOD	12-9-16
E	LOIS J. ESTEP	12-8-25
F	ALBERT L. HOHMAN & MARY L. HOHMAN, TRUSTEES OF THE HOHMAN REVOCABLE LIVING TRUST DATED AUGUST 8, 2014; JOSEPH A. HOHMAN & DEBRA K. HOHMAN, HIS WIFE	12-8-24
G	ALBERT L. HOHMAN & MARY L. HOHMAN, TRUSTEES OF THE HOHMAN REVOCABLE LIVING TRUST DATED AUGUST 8, 2014; JOSEPH A. HOHMAN & DEBRA K. HOHMAN, HIS WIFE	12-8-24.3
H	ALBERT L. HOHMAN & MARY L. HOHMAN, TRUSTEES OF THE HOHMAN REVOCABLE LIVING TRUST DATED AUGUST 8, 2014; JOSEPH A. HOHMAN & DEBRA K. HOHMAN, HIS WIFE	12-8-10
I	STEVEN RAYMOND HOHMAN & CATHERINE A. HOHMAN, HUSBAND AND WIFE	12-8-11.3

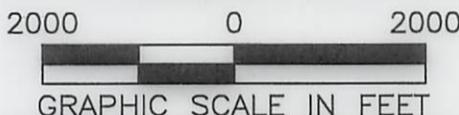

**SURFACE HOLE LOCATION (SHL):**  
UTM (NAD83, ZONE 17, METERS):  
NORTHING: 4394148.25  
EASTING: 525092.90

**BOTTOM HOLE LOCATION (BHL):**  
UTM (NAD83, ZONE 17, METERS):  
NORTHING: 4394148.25  
EASTING: 525092.90

I, THE UNDERSIGNED, HEREBY CERTIFY THAT THIS PLAT IS CORRECT TO THE BEST OF MY KNOWLEDGE AND BELIEF AND SHOWS ALL THE INFORMATION REQUIRED BY LAW AND REGULATIONS ISSUED AND PRESCRIBED BY THE DEPARTMENT OF ENVIRONMENTAL PROTECTION.

P.S. 2041 *[Signature]* 3-19-18

COMPANY: **SWN** Production Company, LLC

(+) DENOTES LOCATION OF WELL ON UNITED STATES TOPOGRAPHIC MAPS

WVDEP  
OFFICE OF OIL & GAS  
601 57TH STREET  
CHARLESTON, WV 25034

MINIMUM DEGREE OF ACCURACY: 1/200

PROVEN SOURCE OF ELEVATION: SURVEY GRADE GPS (NAVD 88, US FT)

ALBERT-MARY HOHMAN

OPERATOR'S WELL #: 1

API WELL #: 47 103 02231W  
STATE COUNTY PERMIT

WELL TYPE: OIL  WASTE DISPOSAL  PRODUCTION  DEEP  GAS  LIQUID INJECTION  STORAGE  SHALLOW

WATERSHED: UPPER OHIO SOUTH ELEVATION: 1,298.4'-CONFIRMED GROUND ELEVATION

DISTRICT: PROCTOR COUNTY: WETZEL QUADRANGLE: WILEYVILLE, WV

SURFACE OWNER: ALBERT L. HOHMAN & MARY HOHMAN (TRUSTEES OF THE HOHMAN REVOCABLE TRUST) ACREAGE: ±104.48

OIL & GAS ROYALTY OWNER: ALBERT L. HOHMAN & MARY HOHMAN (TRUSTEES OF THE HOHMAN REVOCABLE TRUST) ACREAGE: ±104.48

DRILL  DRILL DEEPER  REDRILL  FRACTURE OR STIMULATE  PLUG OFF OLD FORMATION  PERFORATE NEW FORMATION

CONVERT  PLUG & ABANDON  CLEAN OUT & REPLUG  OTHER CHANGE  (SPECIFY) REWORK

TARGET FORMATION: MARCELLUS ESTIMATED DEPTH: 9,910' 04/27/2018

WELL OPERATOR: SWN PRODUCTION COMPANY, LLC DESIGNATED AGENT: DEE SOUTHALL

ADDRESS: P.O. BOX 1300 ADDRESS: P.O. BOX 1300

CITY: JANE LEW STATE: WV ZIP CODE: 26378 CITY: JANE LEW STATE: WV ZIP CODE: 26378

**LEGEND:**

- PROPOSED SURFACE HOLE / BOTTOM HOLE
- EXISTING / PRODUCING WELLHEAD
- LPL: LANDING POINT LOCATION
- EXISTING WATER WELL
- EXISTING SPRING
- SURVEYED BOUNDARY
- DRILLING UNIT
- LEASE BOUNDARY
- PROPOSED PATH

**REVISIONS:**

DATE: 03-19-2018

DRAWN BY: D.REED

SCALE: 1" = 2000'

DRAWING NO: 2018-236

WELL LOCATION PLAT