



4391
40'
4389
4388000'N
RECEIVED
Office of Oil and Gas
OCT 18 2023
WV Department of
Environmental Protection
120 000 FEET
(PA)

25' 250 000 FEET (PA) 51 52 53 80°22'30" 39°37'30" (MANNINGTON) 6963 1/2 SE



ROAD CLASSIFICATION

- Heavy duty ————
- Medium duty - - - - -
- Light duty - - - - -
- Unimproved dirt - - - - -
- U. S. Route ————
- State Route ————



QUADRANGLE LOCATION

HUNDRED, W. VA.—PA.

NW/4 MANNINGTON 15' QUADRANGLE
N 3937.5 — W 8022.5/7.5

'Hundred; WV,PA' Scale: 1" = 0.379Mi 610Mt 2.000Ft. 1 Mi = 2.640" . 1 cm = 240Mt

11/10/2023

WW-7
8-30-06



West Virginia Department of Environmental Protection
Office of Oil and Gas

WELL LOCATION FORM: GPS

API: 47-103-02303 WELL NO.: SC-4A

FARM NAME: MIKE SLEETH

RESPONSIBLE PARTY NAME: WEST VIRGINIA LAND RESOURCES INC.

COUNTY: WETZEL DISTRICT: CHURCH

QUADRANGLE: HUNDRED W.VA,PA

SURFACE OWNER: MIKE SLEETH

ROYALTY OWNER: _____

UTM GPS NORTHING: 4,390,413 m

UTM GPS EASTING: 550,284 m GPS ELEVATION: 382 m

The Responsible Party named above has chosen to submit GPS coordinates in lieu of preparing a new well location plat for a plugging permit or assigned API number on the above well. The Office of Oil and Gas will not accept GPS coordinates that do not meet the following requirements:

1. Datum: NAD 1983, Zone: 17 North, Coordinate Units: meters, Altitude: height above mean sea level (MSL) – meters.

2. Accuracy to Datum – 3.05 meters

3. Data Collection Method:

Survey grade GPS : Post Processed Differential _____

Real-Time Differential

Mapping Grade GPS _____ : Post Processed Differential _____

Real-Time Differential _____

4. Letter size copy of the topography map showing the well location.

I the undersigned, hereby certify this data is correct to the best of my knowledge and belief and shows all the information required by law and the regulations issued and prescribed by the Office of Oil and Gas.

Signature

PS 2002

Title

SEPTEMBER 11, 2023


Date

RECEIVED
Office of Oil and Gas


OCT 18 2023

WV Department of
Environmental Protection

11/10/2023

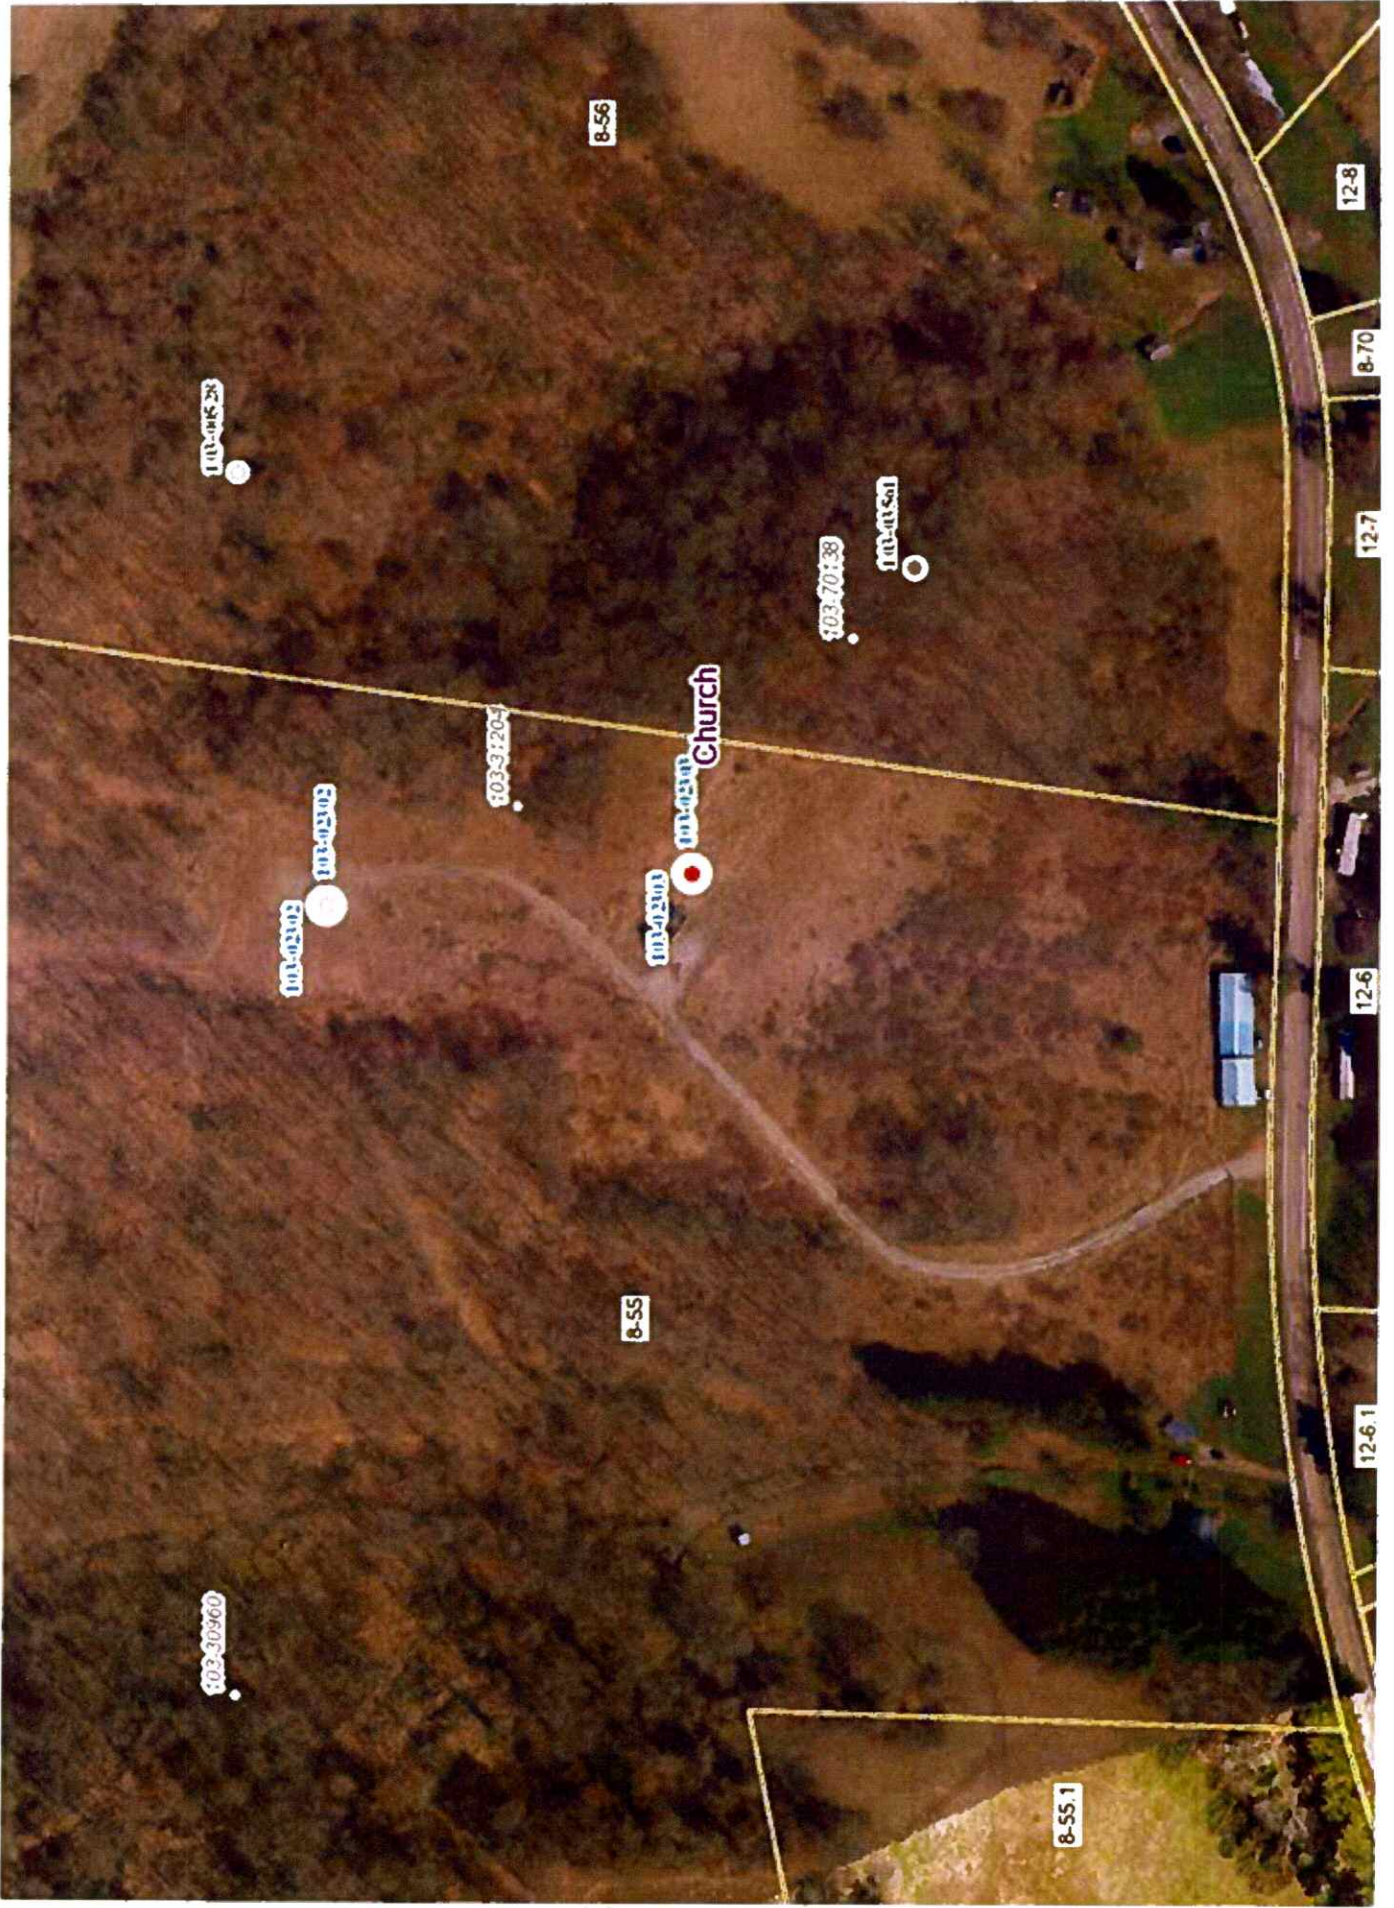

11/10/2023

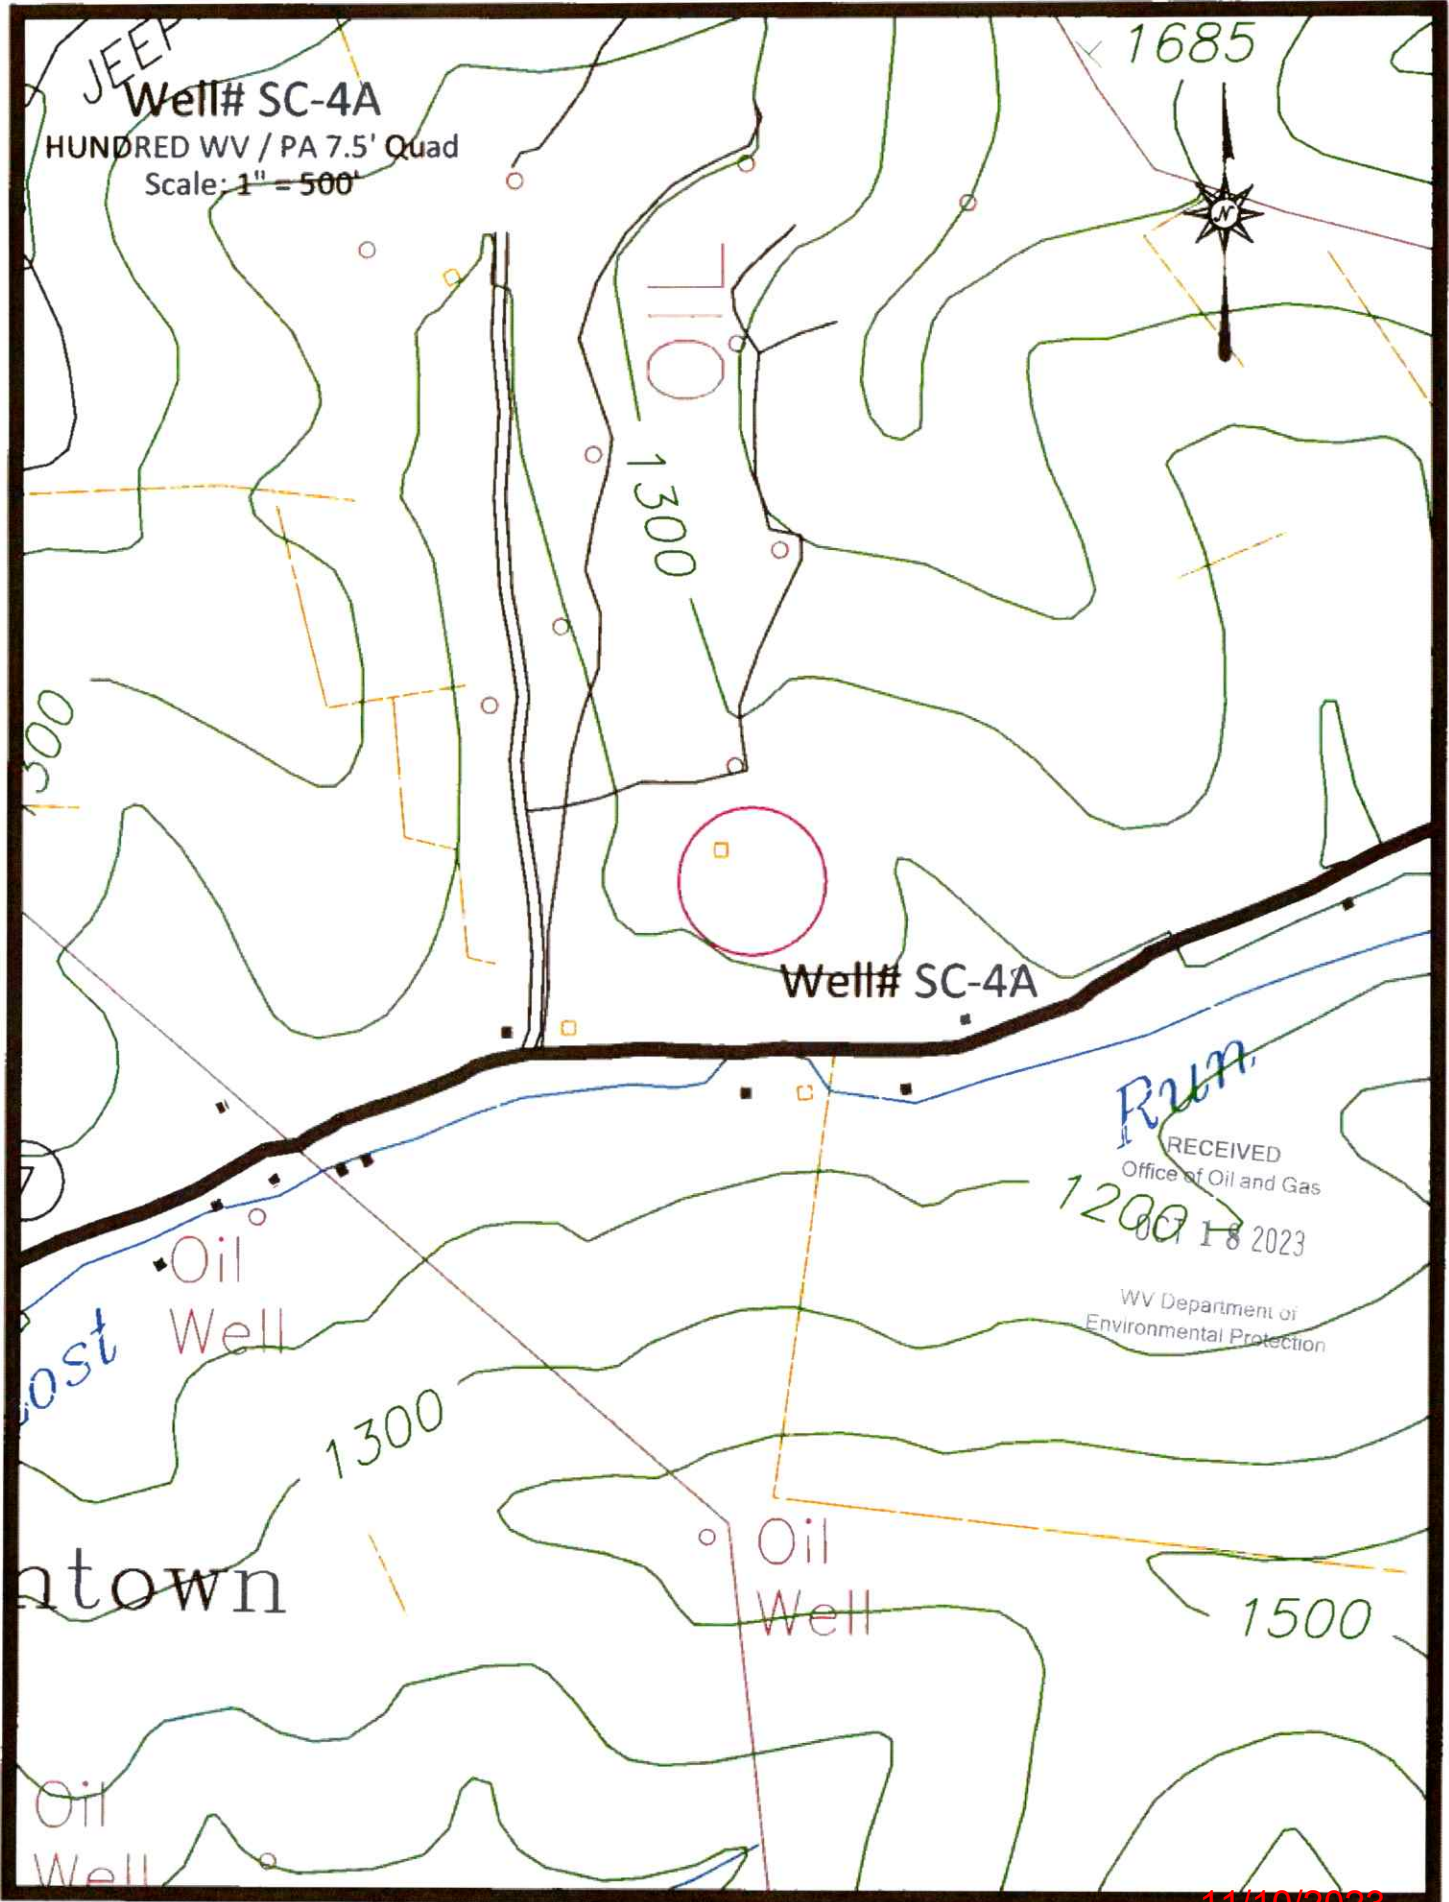


11/10/2023

Well# SC-4A

HUNDRED WV / PA 7.5' Quad

Scale: 1" = 2000'

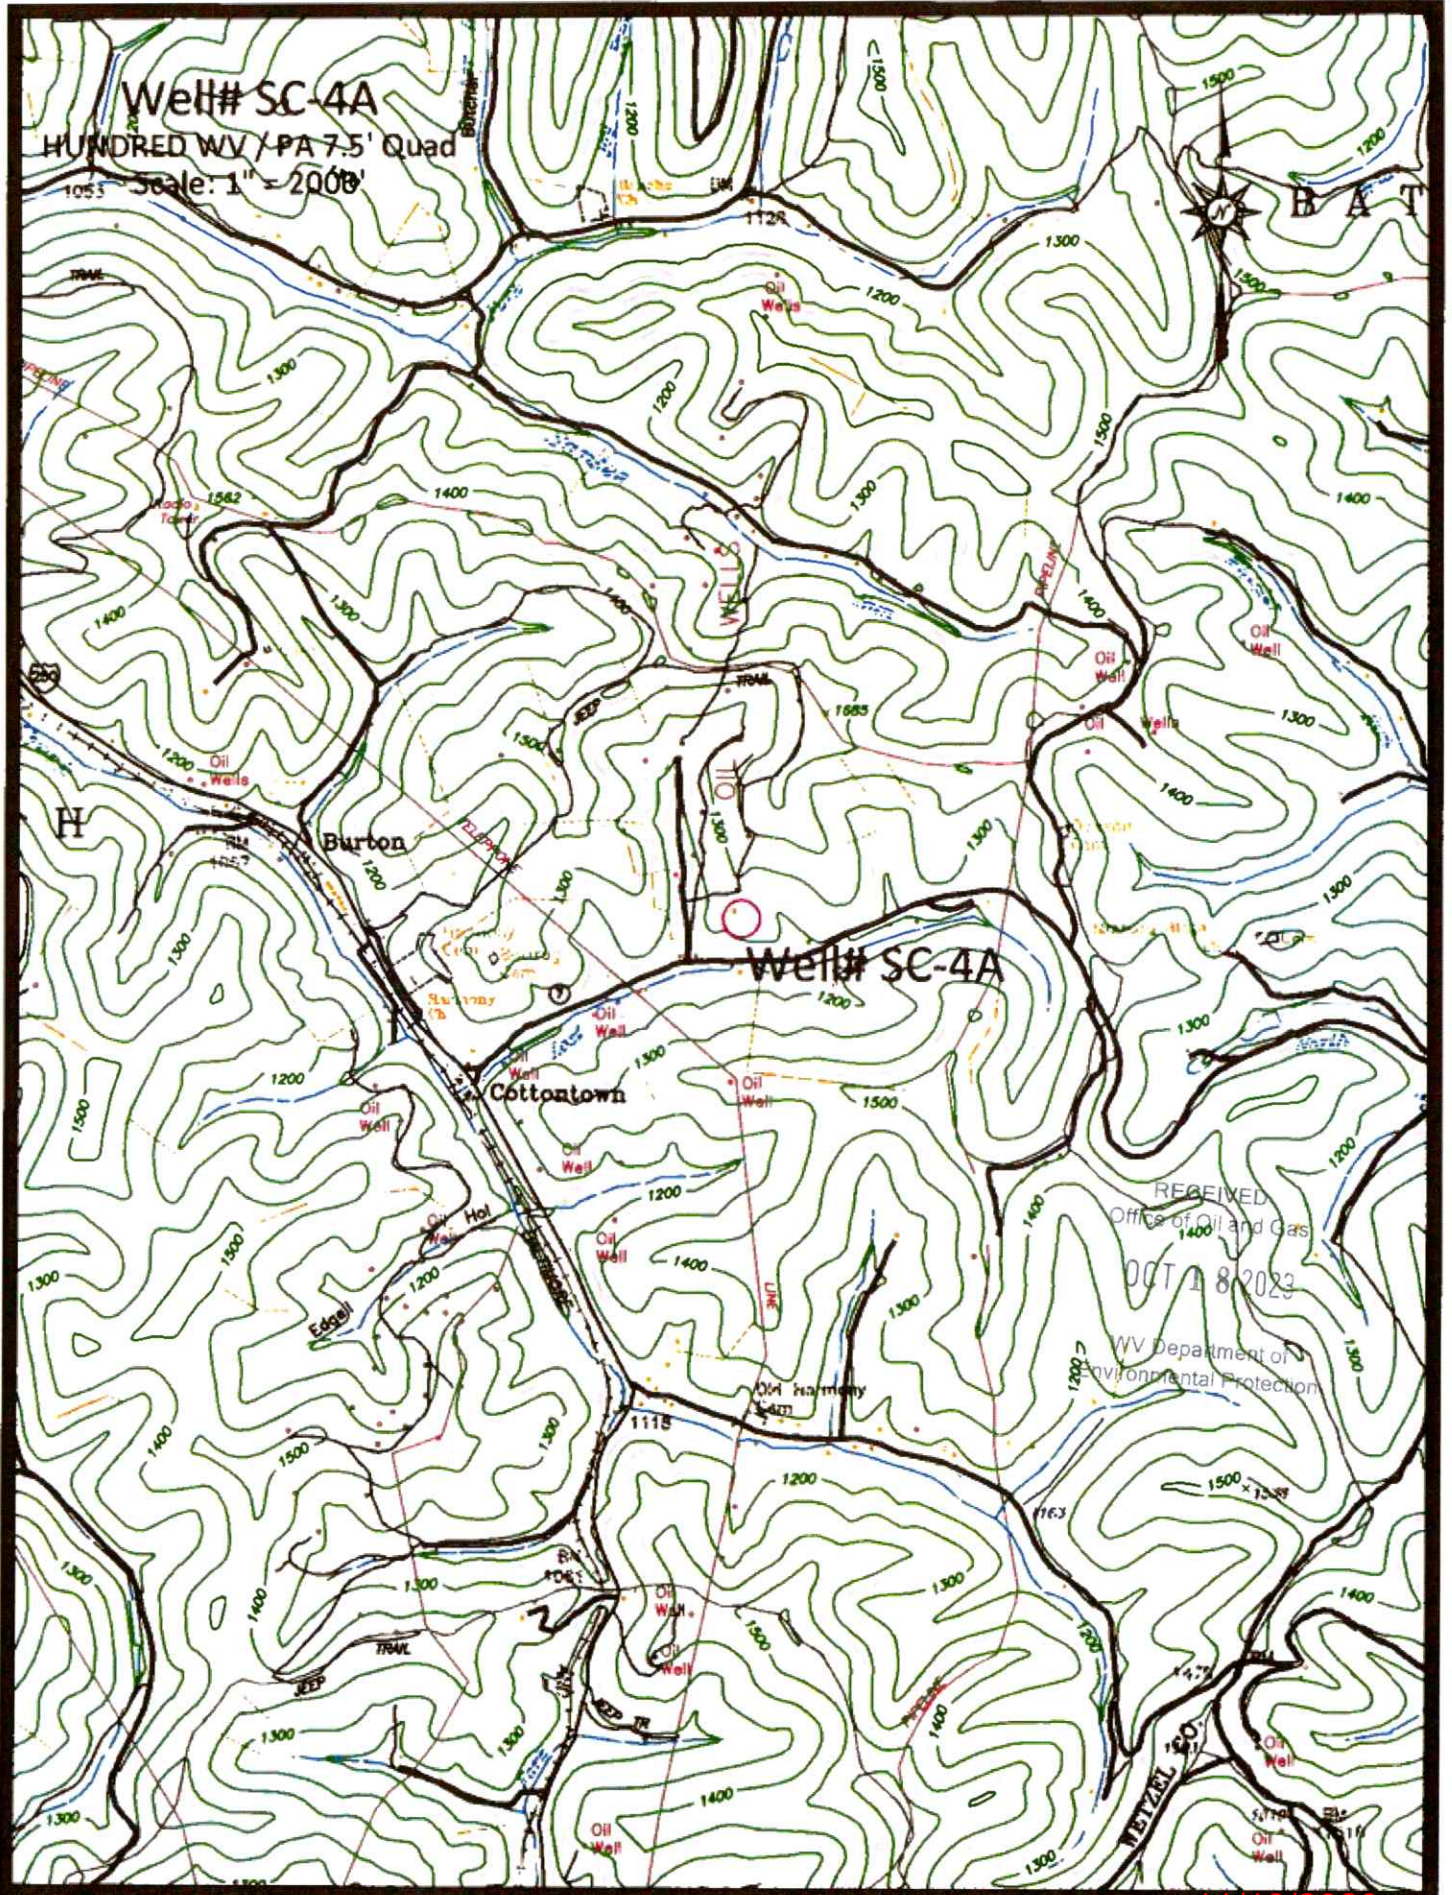

RECEIVED
Office of Oil and Gas
OCT 18 2023
WV Department of
Environmental Protection

11/10/2023

