

4710302348P


Topo Quad: Pine Grove 7.5' Scale: 1" = 2000'

County: Wetzel Date: January 03, 2022

District: Grant Project No: 40-34-00-09

47-103-02348 WV 510845-S (D.H. Cox)

Topo

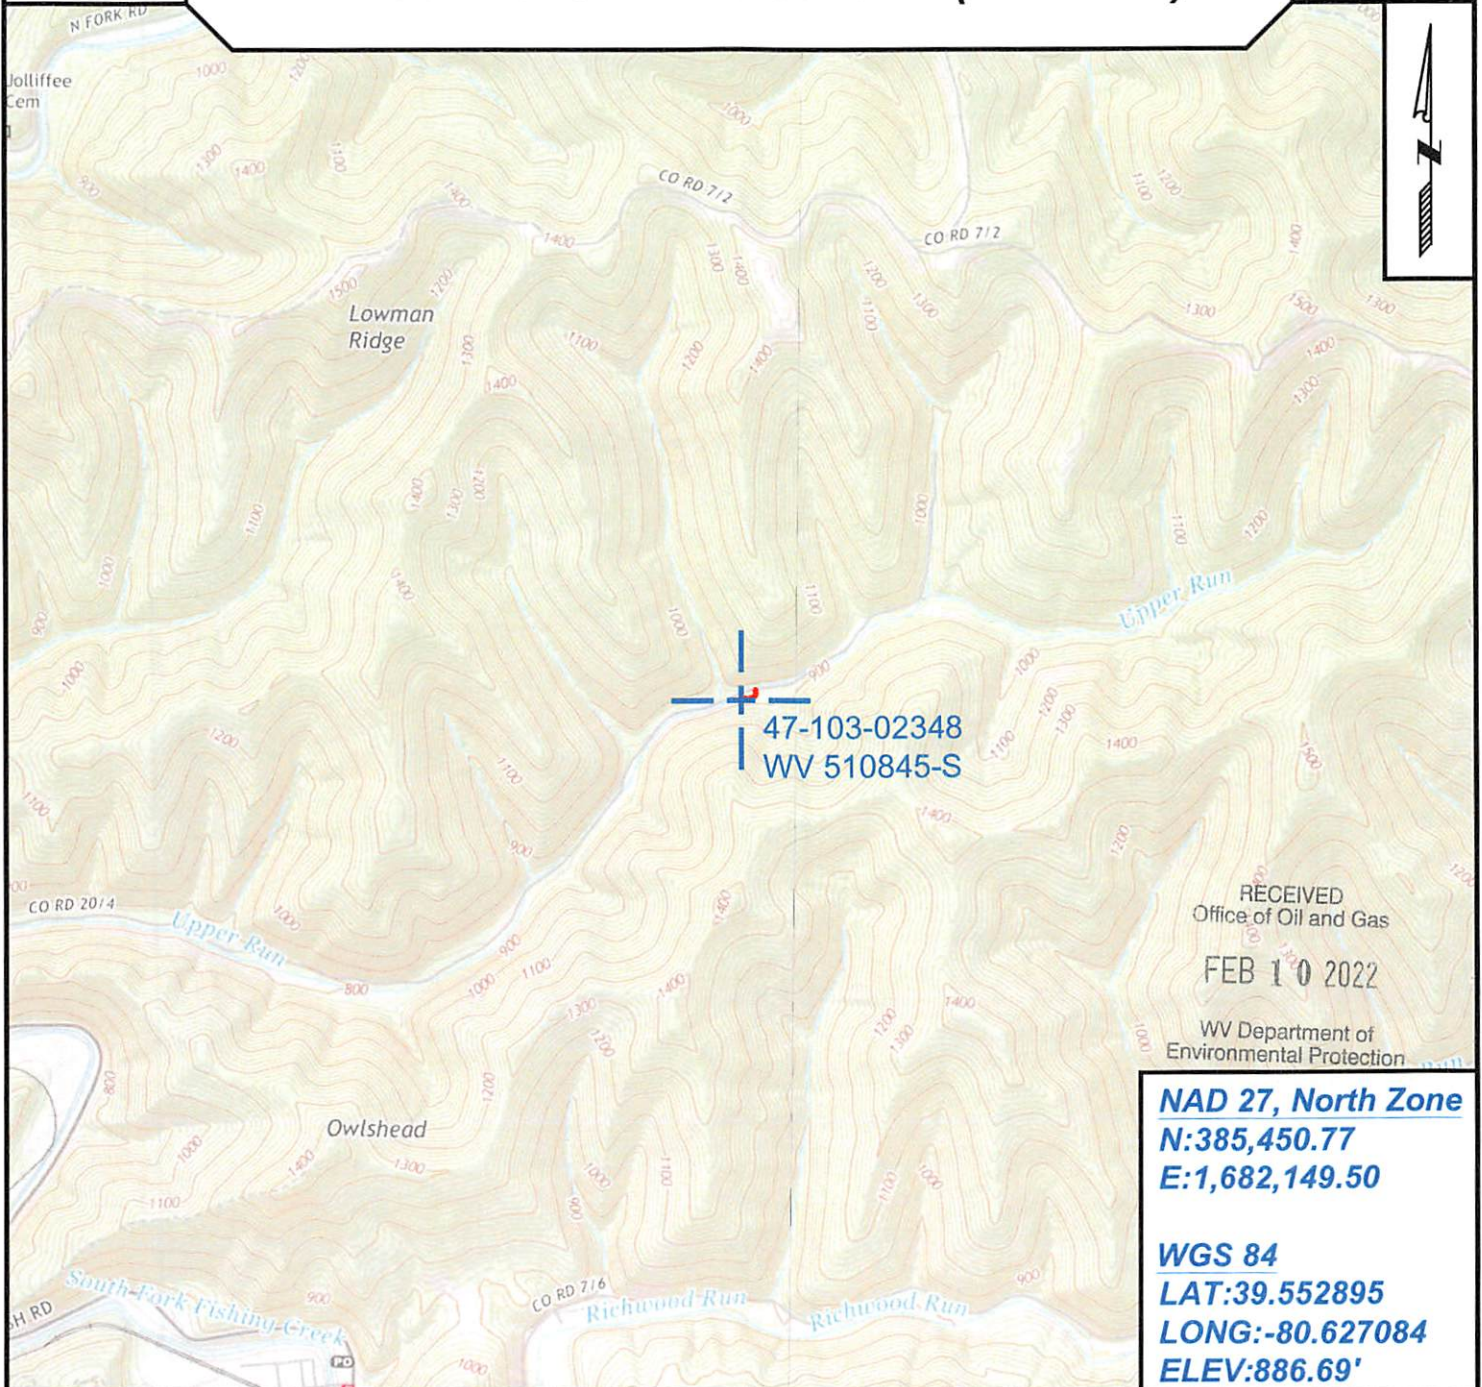

RECEIVED
Office of Oil and Gas
FEB 10 2022
WV Department of
Environmental Protection

NAD 27, North Zone
N:385,450.77
E:1,682,149.50

WGS 84
LAT:39.552895
LONG:-80.627084
ELEV:886.69'



SURVEYING AND MAPPING SERVICES PERFORMED BY:
ALLEGHENY SURVEYS, INC.
 1-800-482-8606
 237 Birch River Road
 Birch River, WV 26610
 PH: (304) 649-8606
 FAX: (304) 649-8608

PREPARED FOR:
EQT Production Company
 400 Woodcliff Drive
 Canonsburg, PA 15317

04/29/2022