

WW-7
8-30-06



West Virginia Department of Environmental Protection
Office of Oil and Gas
WELL LOCATION FORM: GPS

RECEIVED
Office of Oil and Gas

DEC 26 2018

WV Department of
Environmental Protection

API: 47-103-02433 WELL NO.: WV 519051 (Lantz #9)

FARM NAME: Lantz

RESPONSIBLE PARTY NAME: EQT Production Company

COUNTY: Wetzel DISTRICT: Grant

QUADRANGLE: Pine Grove 7.5'

SURFACE OWNER: West Virginia Conservation Commission

ROYALTY OWNER: Robert Lantz Miller, et al.

UTM GPS NORTHING: 4374259

UTM GPS EASTING: 530703 GPS ELEVATION: 238 m (783 ft)

The Responsible Party named above has chosen to submit GPS coordinates in lieu of preparing a new well location plat for a plugging permit or assigned API number on the above well. The Office of Oil and Gas will not accept GPS coordinates that do not meet the following requirements:

1. Datum: NAD 1983, Zone: 17 North, Coordinate Units: meters, Altitude: height above mean sea level (MSL) – meters.
2. Accuracy to Datum – 3.05 meters
3. Data Collection Method:
Survey grade GPS _____ : Post Processed Differential _____
Real-Time Differential _____
Mapping Grade GPS X : Post Processed Differential X
Real-Time Differential _____

4. **Letter size copy of the topography map showing the well location.**

I the undersigned, hereby certify this data is correct to the best of my knowledge and belief and shows all the information required by law and the regulations issued and prescribed by the Office of Oil and Gas.


Signature

PS# 2180
Title

11/6/18
Date

47-103-02433P

04/19/2019

Office of Oil and Gas

Topo Quad: Pine Grove 7.5'

Scale: 1" = 2000'

County: Wetzel

Date: November 6, 2018

DEC 26 2018


District: Grant

Project No: 40-34-00-09

WV Department of Environmental Protection

47-103-02433 WV 519051 (Lantz #9)

Topo

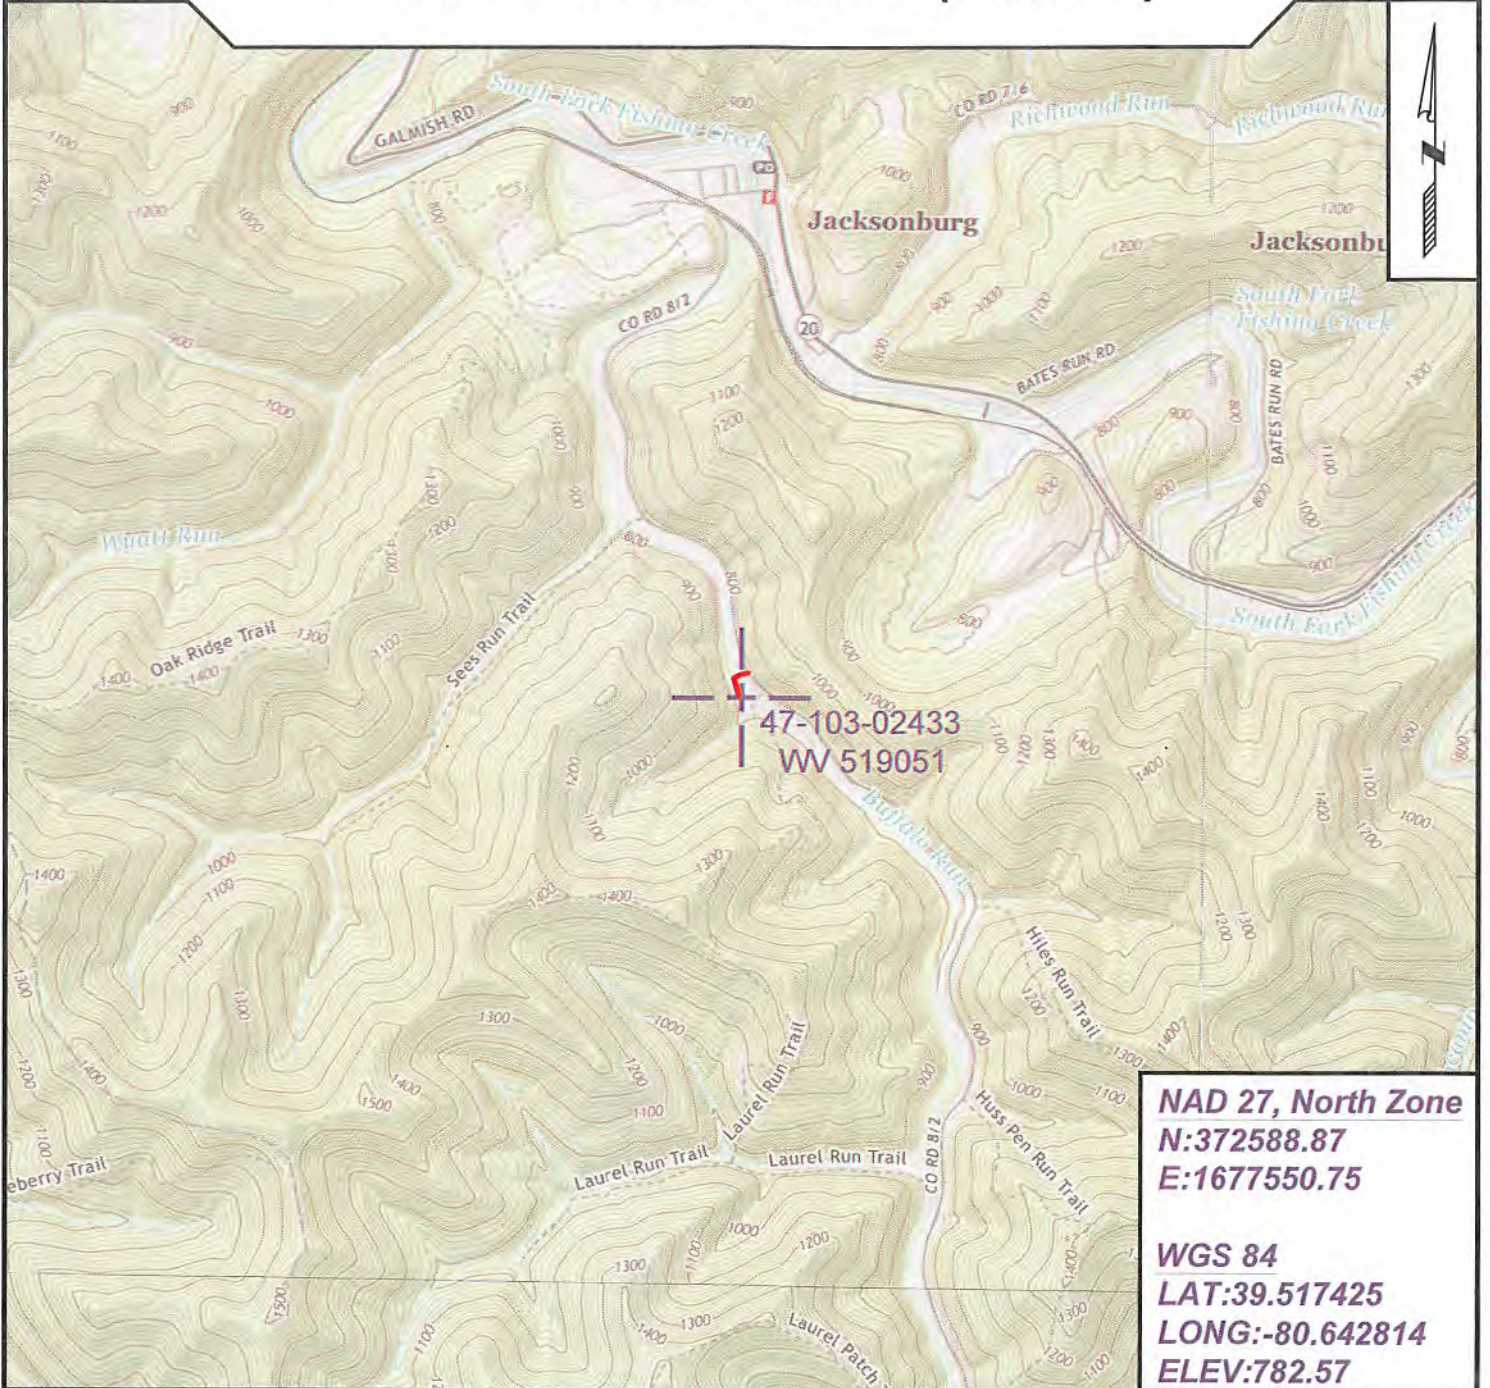

NAD 27, North Zone
N:372588.87
E:1677550.75

WGS 84
LAT:39.517425
LONG:-80.642814
ELEV:782.57



SURVEYING AND MAPPING SERVICES PERFORMED BY:

ALLEGHENY SURVEYS, INC.

1-800-482-8606
 237 Birch River Road
 Birch River, WV 26610
 PH: (304) 649-8606
 FAX: (304) 649-8608

PREPARED FOR:

EQT Production Company

2400 Ansys Drive
 Canonsburg, PA 15317