

WW-7
8-30-06



West Virginia Department of Environmental Protection
Office of Oil and Gas
WELL LOCATION FORM: GPS

API: 47-103-02525 WELL NO.: Willey #1

FARM NAME: Willey

RESPONSIBLE PARTY NAME: EQT Production Company RECEIVED
Office of Oil and Gas

COUNTY: Wetzel DISTRICT: Green APR 25 2024

QUADRANGLE: Porters Falls 7.5' WV Department of
Environmental Protection

SURFACE OWNER: Bernard Ely & Carolyn S. Willey

ROYALTY OWNER: _____

UTM GPS NORTHING: 4382140

UTM GPS EASTING: 519210 GPS ELEVATION: 208 m (682 ft)

The Responsible Party named above has chosen to submit GPS coordinates in lieu of preparing a new well location plat for a plugging permit or assigned API number on the above well. The Office of Oil and Gas will not accept GPS coordinates that do not meet the following requirements:

- Datum: NAD 1983, Zone: 17 North, Coordinate Units: meters, Altitude: height above mean sea level (MSL) – meters.
- Accuracy to Datum – 3.05 meters
- Data Collection Method:
Survey grade GPS _____ : Post Processed Differential _____
Real-Time Differential _____
Mapping Grade GPS X : Post Processed Differential X
Real-Time Differential _____

4. Letter size copy of the topography map showing the well location.

I the undersigned, hereby certify this data is correct to the best of my knowledge and belief and shows all the information required by law and the regulations issued and prescribed by the Office of Oil and Gas.

Ben R. Syta
Signature

P.S. 2092
Title

2-15-24
Date


06/07/2024

Topo Quad: Porters Falls 7.5' RECEIVED
Office of Oil and Gas
County: Wetzel APR 25 2024
District: Green WV Department of
Environmental Protection

Scale: 1" = 2000'
Date: January 19, 2024
Project No: 305-34-G-23

47-103-02525 Willey #1

Topo

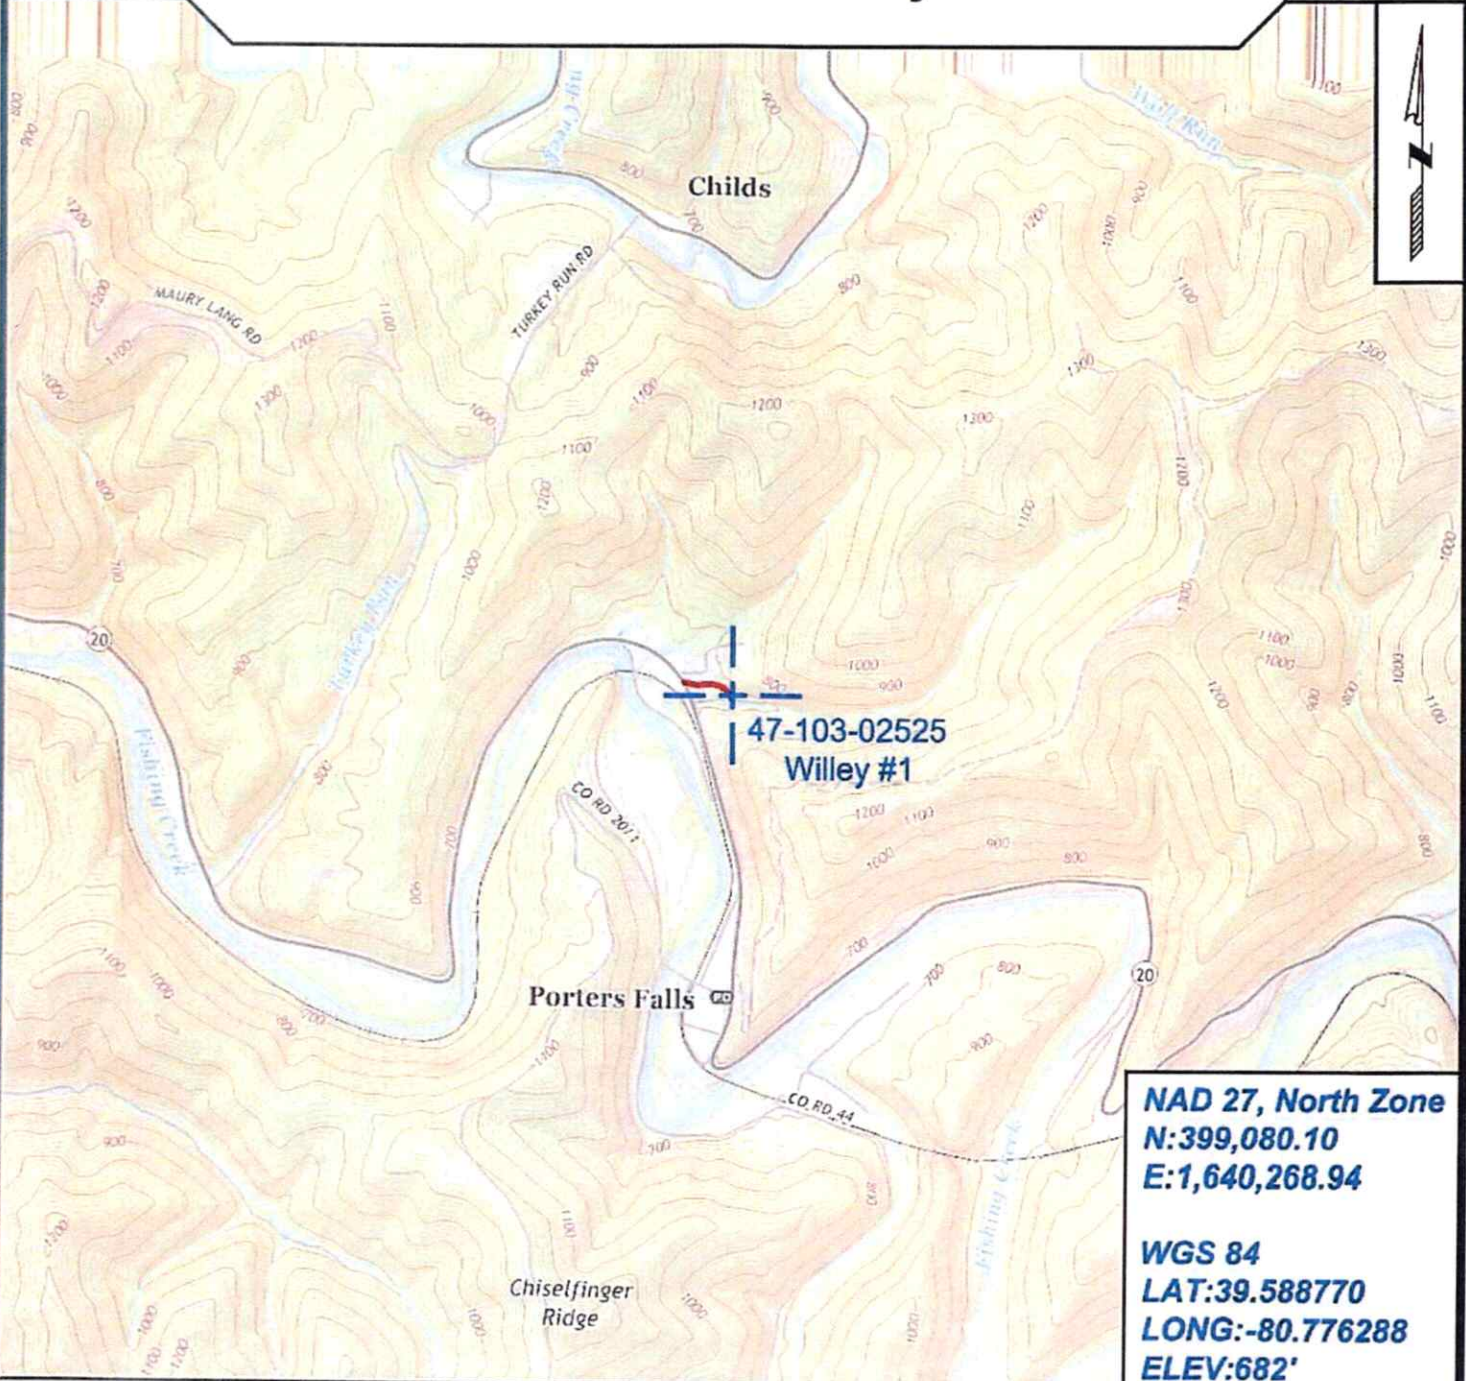

NAD 27, North Zone
N:399,080.10
E:1,640,268.94

WGS 84
LAT:39.588770
LONG:-80.776288
ELEV:682'



SURVEYING AND MAPPING SERVICES PERFORMED BY:
ALLEGHENY SURVEYS, INC.
1-800-482-8606
237 Birch River Road
Birch River, WV 26610
PH: (304) 649-8606
FAX: (304) 649-8608

PREPARED FOR:
EQT Production Company
400 Woodcliff Drive
Canonsburg, PA 15317

06/07/2024