



West Virginia Department of Environmental Protection  
Office of Oil and Gas  
**WELL LOCATION FORM: GPS**

API: 47-103-02534 WELL NO.: WV 519056 (Mason #1)

FARM NAME: Mason

RESPONSIBLE PARTY NAME: EQT Production Company

COUNTY: Wetzel DISTRICT: Proctor

QUADRANGLE: Wileyville 7.5'

SURFACE OWNER: Donna Joan Long Greathouse

ROYALTY OWNER: Genelda and Wells Mason

UTM GPS NORTHING: 4386309

UTM GPS EASTING: 523477 GPS ELEVATION: 365 m (1198 ft)

The Responsible Party named above has chosen to submit GPS coordinates in lieu of preparing a new well location plat for a plugging permit or assigned API number on the above well. The Office of Oil and Gas will not accept GPS coordinates that do not meet the following requirements:

- Datum: NAD 1983, Zone: 17 North, Coordinate Units: meters, Altitude: height above mean sea level (MSL) – meters.
- Accuracy to Datum – 3.05 meters
- Data Collection Method:
 

Survey grade GPS _____	: Post Processed Differential _____	RECEIVED Office of Oil and Gas MAR 30 2021
	Real-Time Differential _____	WV Department of Environmental Protection
Mapping Grade GPS <u>X</u>	: Post Processed Differential <u>X</u>	
	Real-Time Differential _____	

4. **Letter size copy of the topography map showing the well location.**  
I the undersigned, hereby certify this data is correct to the best of my knowledge and belief and shows all the information required by law and the regulations issued and prescribed by the Office of Oil and Gas.

[Signature]  
Signature

PS# 2180  
Title

3/24/2021  
Date

Topo Quad: Wileyville 7.5'

Scale: 1" = 2000'

4710302534P

County: Wetzel


Date: March 24, 2021

District: Proctor

Project No: 40-34-00-09

# 47-103-02534 WV 519056 (Mason #1)

Topo

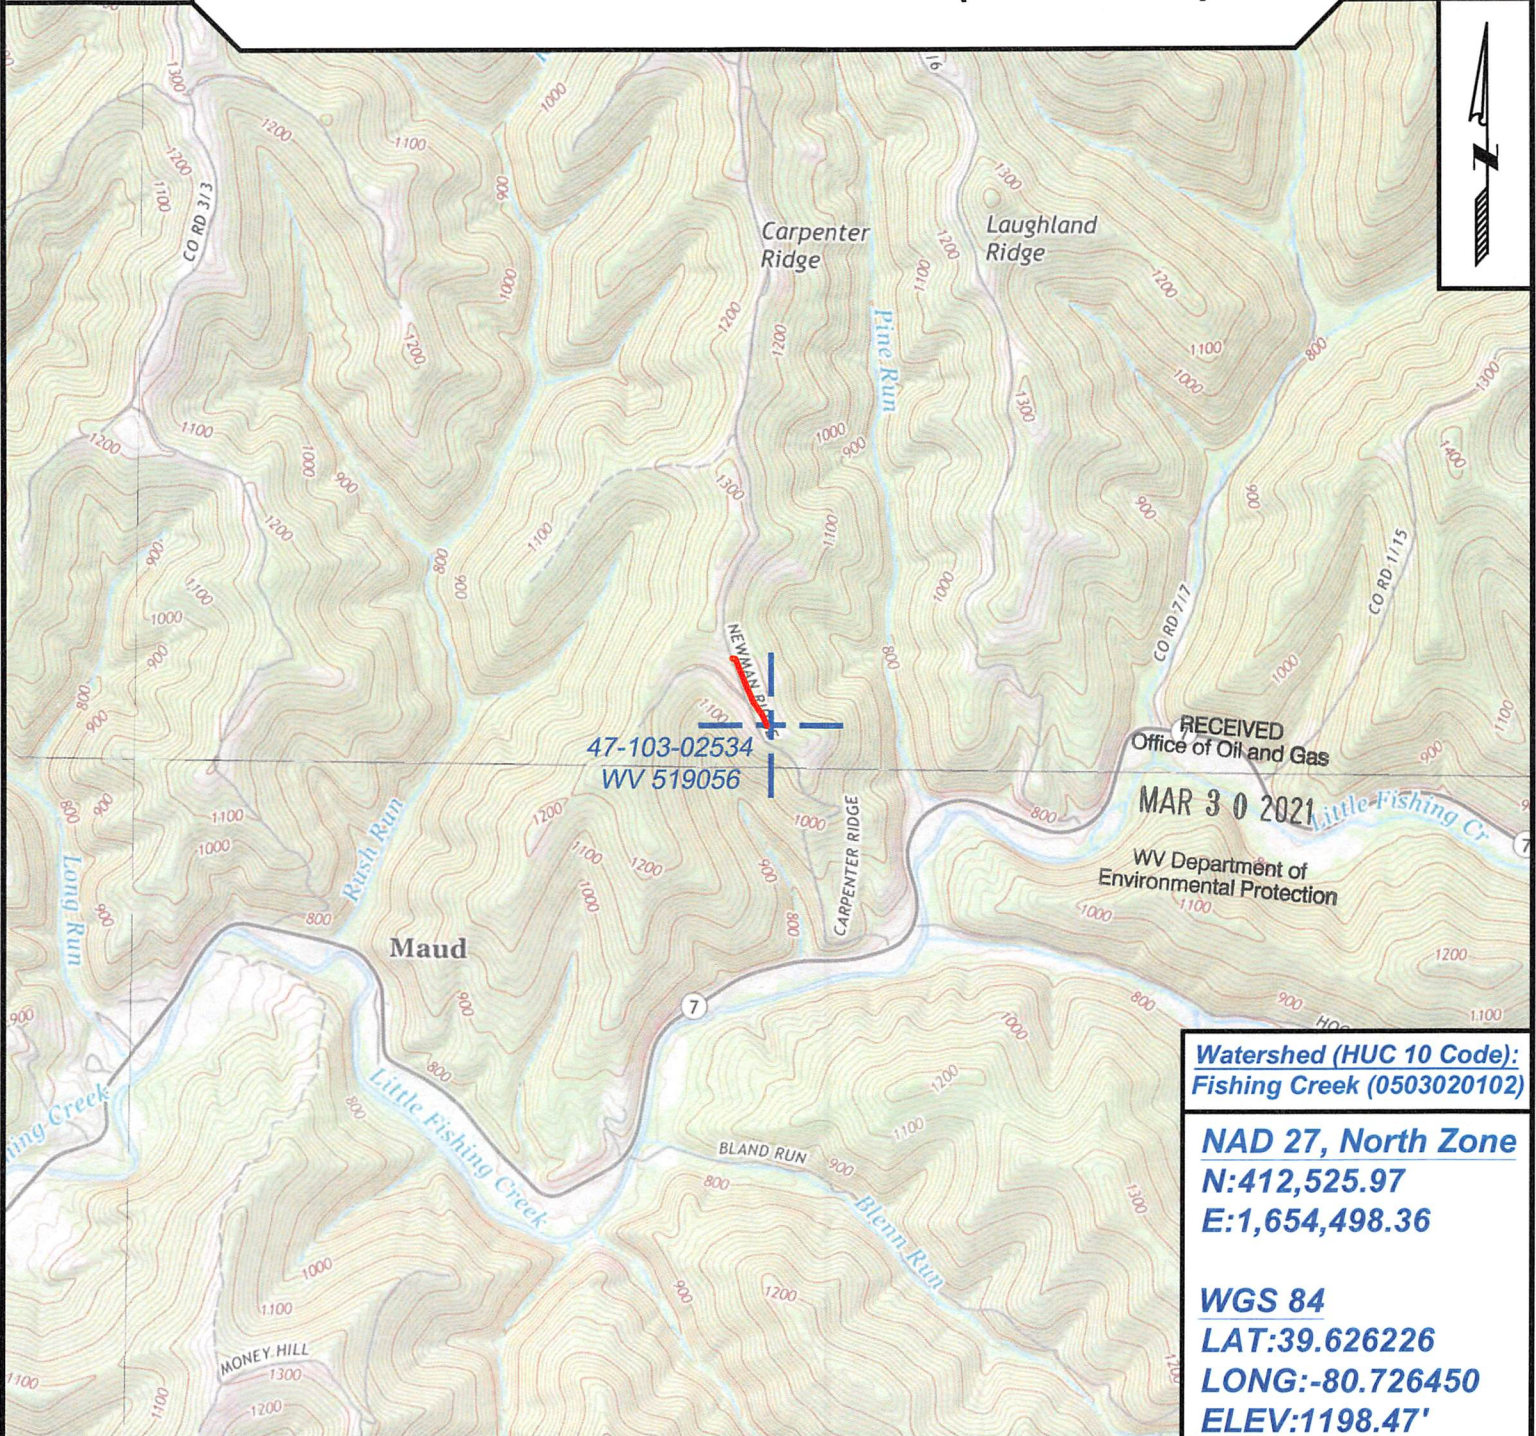

Watershed (HUC 10 Code):  
Fishing Creek (0503020102)

NAD 27, North Zone  
N:412,525.97  
E:1,654,498.36

WGS 84  
LAT:39.626226  
LONG:-80.726450  
ELEV:1198.47'



SURVEYING AND MAPPING SERVICES PERFORMED BY:

## ALLEGHENY SURVEYS, INC.

1-800-482-8606  
237 Birch River Road  
Birch River, WV 26610  
PH: (304) 649-8606  
FAX: (304) 649-8608

PREPARED FOR:

## EQT Production Company

400 Woodcliff Drive  
Canonsburg, PA 15317

06/18/2021