



West Virginia Department of Environmental Protection
Office of Oil and Gas
WELL LOCATION FORM: GPS

API: 47-103-02534 WELL NO.: WV 519056 (Mason #1)

FARM NAME: Mason

RESPONSIBLE PARTY NAME: EQT Production Company

COUNTY: Wetzel DISTRICT: Proctor

QUADRANGLE: Wileyville 7.5'

SURFACE OWNER: Donna Joan Long Greathouse

ROYALTY OWNER: Genelda and Wells Mason

UTM GPS NORTHING: 4386309

UTM GPS EASTING: 523477 GPS ELEVATION: 365 m (1198 ft)

The Responsible Party named above has chosen to submit GPS coordinates in lieu of preparing a new well location plat for a plugging permit or assigned API number on the above well. The Office of Oil and Gas will not accept GPS coordinates that do not meet the following requirements:

1. Datum: NAD 1983, Zone: 17 North, Coordinate Units: meters, Altitude: height above mean sea level (MSL) – meters.
2. Accuracy to Datum – 3.05 meters
3. Data Collection Method:

Survey grade GPS _____ : Post Processed Differential _____
 Real-Time Differential _____
 Mapping Grade GPS X : Post Processed Differential X
 Real-Time Differential _____

4. Letter size copy of the topography map showing the well location.

I the undersigned, hereby certify this data is correct to the best of my knowledge and belief and shows all the information required by law and the regulations issued and prescribed by the Office of Oil and Gas.

RECEIVED
Office of Oil and Gas

AUG 04 2022

WV Department of
Environmental Protection


Signature

PS# 2180
Title

3/24/2021
Date

47 103 02534 P

Topo Quad: Wileyville 7.5'

Scale: 1" = 2000'

County: Wetzel


Date: March 24, 2021

District: Proctor

Project No: 40-34-00-09

47-103-02534 WV 519056 (Mason #1)

Topo

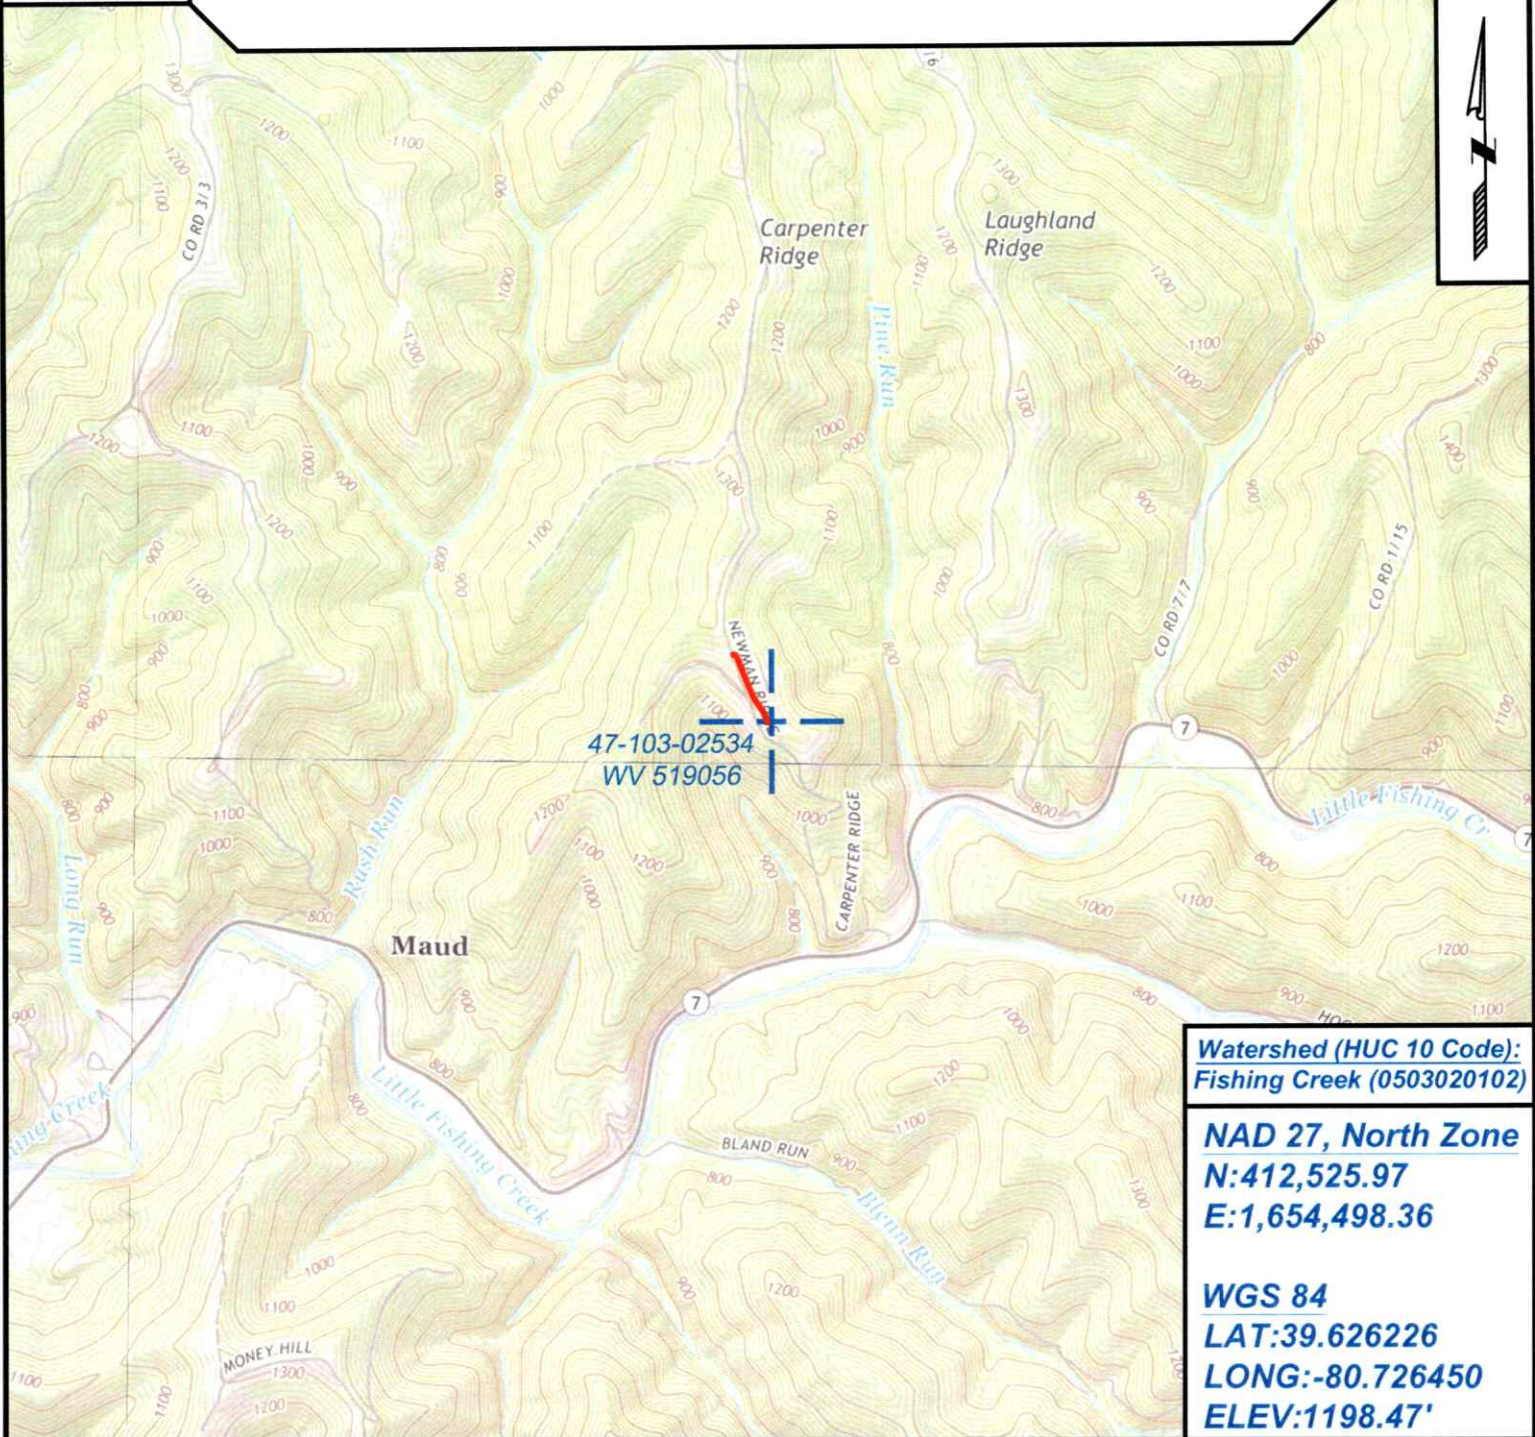

47-103-02534
WV 519056

Watershed (HUC 10 Code):
Fishing Creek (0503020102)

NAD 27, North Zone
N:412,525.97
E:1,654,498.36

WGS 84
LAT:39.626226
LONG:-80.726450
ELEV:1198.47'



SURVEYING AND MAPPING SERVICES PERFORMED BY:

ALLEGHENY SURVEYS, INC.

1-800-482-8606
237 Birch River Road
Birch River, WV 26610
PH: (304) 649-8606
FAX: (304) 649-8608

PREPARED FOR:

EQT Production Company

400 Woodcliff Drive
Canonsburg, PA 15317

08/19/2022