



West Virginia Department of Environmental Protection
Office of Oil and Gas
WELL LOCATION FORM: GPS

API: 47-103-02537 WELL NO.: WV 516119 (Shreve Watson Unit #1V)

FARM NAME: Ernest Watson

RESPONSIBLE PARTY NAME: EQT Production Company

COUNTY: Wetzel DISTRICT: Clay

QUADRANGLE: Littleton 7.5'

SURFACE OWNER: Ernest Jack & Nancy Lee Watson

ROYALTY OWNER: Western Pocahontas Properties LP & CBC Holdings LLC

UTM GPS NORTHING: 4391280

UTM GPS EASTING: 538529 GPS ELEVATION: 422 m (1385 ft)

The Responsible Party named above has chosen to submit GPS coordinates in lieu of preparing a new well location plat for a plugging permit or assigned API number on the above well. The Office of Oil and Gas will not accept GPS coordinates that do not meet the following requirements:

- Datum: NAD 1983, Zone: 17 North, Coordinate Units: meters, Altitude: height above mean sea level (MSL) – meters.
- Accuracy to Datum – 3.05 meters
- Data Collection Method:

Survey grade GPS _____ : Post Processed Differential _____
 Real-Time Differential _____
 Mapping Grade GPS X : Post Processed Differential X
 Real-Time Differential _____

- Letter size copy of the topography map showing the well location**

I the undersigned, hereby certify this data is correct to the best of my knowledge and belief and shows all the information required by law and the regulations issued and prescribed by the Office of Oil and Gas.

[Signature]
Signature

PS # 2180
Title

1/15/2021
Date

RECEIVED
Office of Oil and Gas
MAR 30 2021
WV Department of Environmental Protection

Topo Quad: Littleton 7.5'

Scale: 1" = 2000'

4710302537P

County: Wetzel


Date: January 11, 2021

District: Clay

Project No: 40-34-00-09

WV 516119 47-103-02537 Shreve Watson Unit #1V

Topo

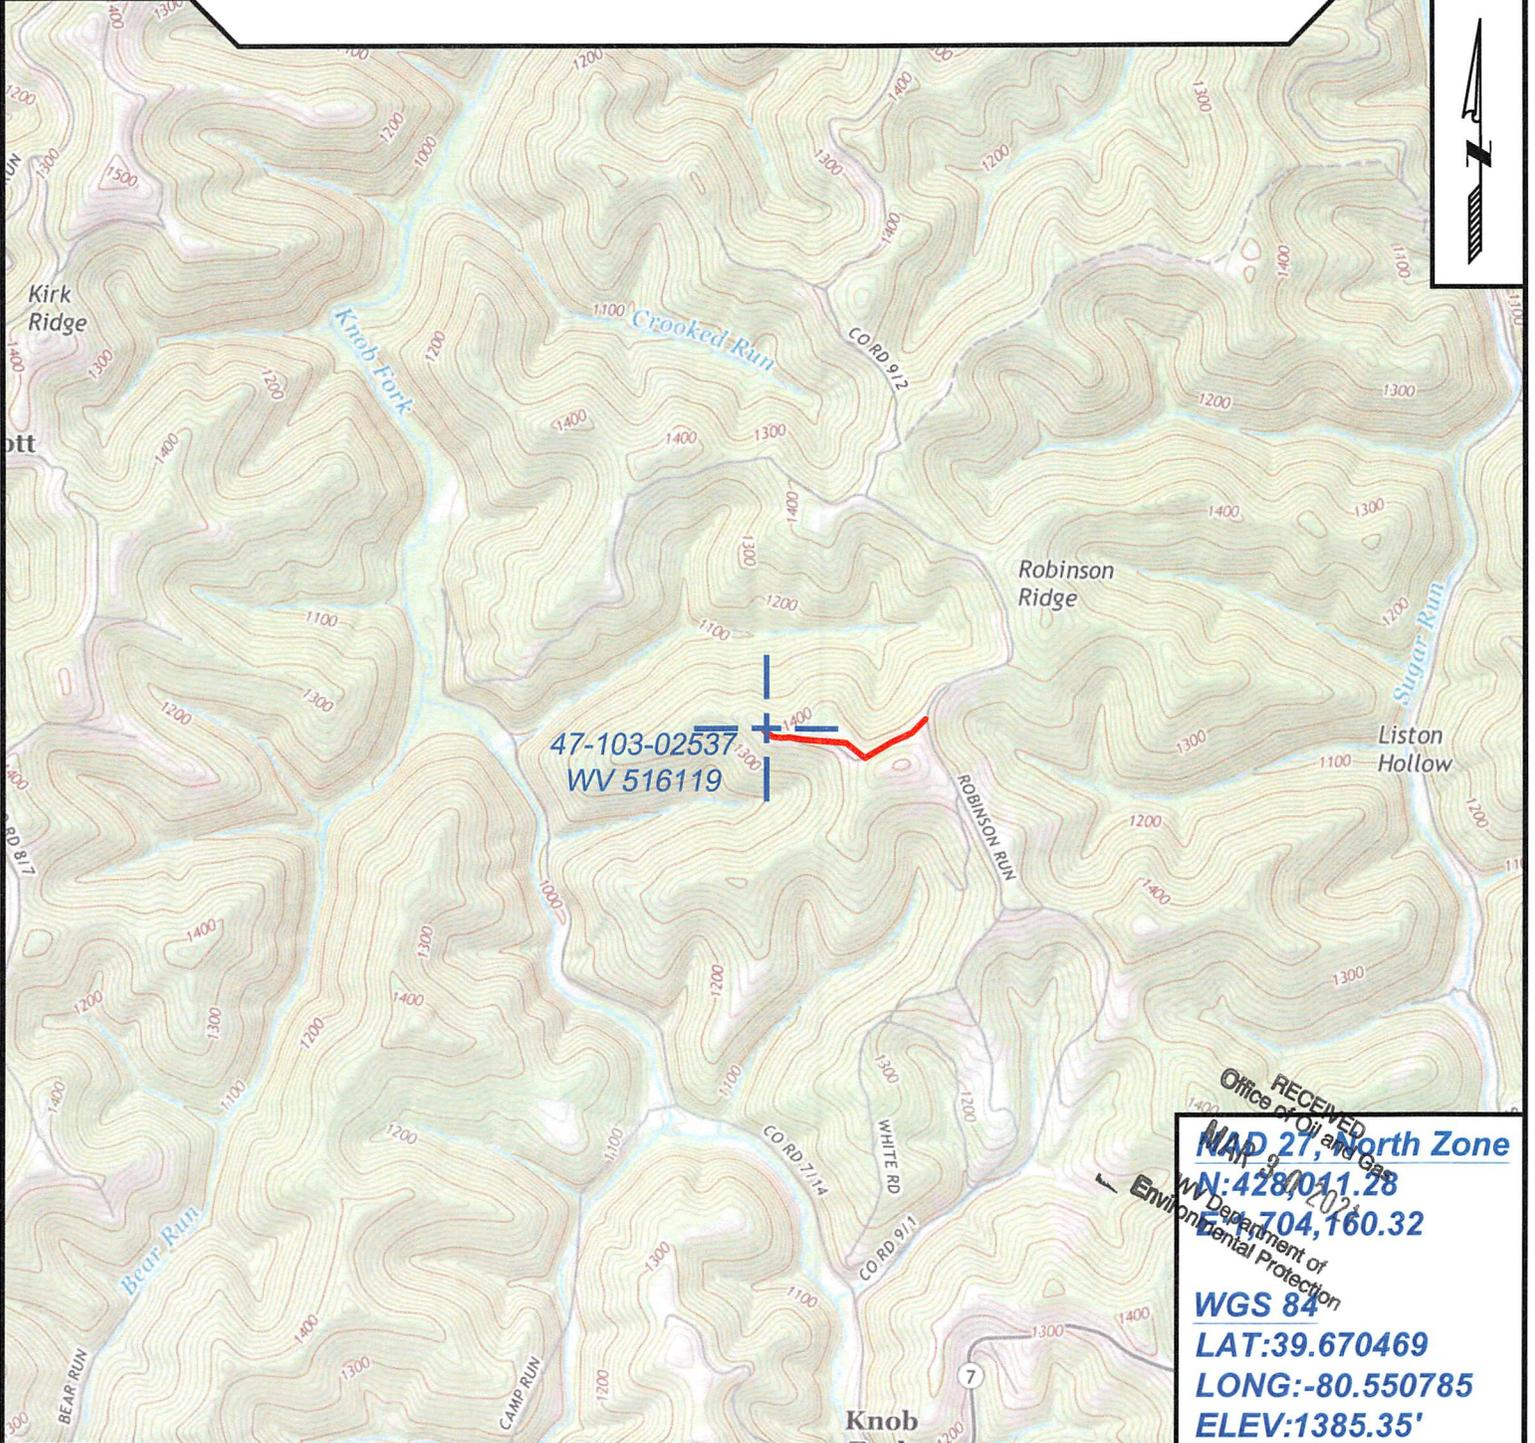

RECEIVED
Office of Oil and Gas
WV Department of Environmental Protection
MAP 27, North Zone
WV: 428,041.28
704,160.32
WGS 84
LAT: 39.670469
LONG: -80.550785
ELEV: 1385.35'



SURVEYING AND MAPPING SERVICES PERFORMED BY:
ALLEGHENY SURVEYS, INC.

1-800-482-8606
237 Birch River Road
Birch River, WV 26610
PH: (304) 649-8606
FAX: (304) 649-8608

PREPARED FOR:
EQT Production Company

400 Woodcliff Drive
Canonsburg, PA 15317

06/18/2021