

# J.M. ALLEN ET AL LEASE 858 ACRES ± WELL NO. 513726



**WELL NO. WV 513726**  
STATE PLANE COORDINATES  
(NORTH ZONE) NAD 27  
N. 385,078.8  
E. 1,710,279.8  
LAT=(N) 39.552718  
LONG=(W) 80.527497  
UTM (NAD83)(METERS)  
N. 4,378,231.2  
E. 540,610.9

**LANDING POINT**  
WELL NO. WV 513726  
STATE PLANE COORDINATES  
(NORTH ZONE) NAD 27  
N. 384,332.5  
E. 1,710,601.8  
LAT=(N) 39.550679  
LONG=(W) 80.526324  
UTM (NAD83)(METERS)  
N. 4,378,005.4  
E. 540,712.8

**BOTTOM HOLE**  
WELL NO. WV 513726  
STATE PLANE COORDINATES  
(NORTH ZONE) NAD 27  
N. 380,447.5  
E. 1,712,667.5  
LAT=(N) 39.540078  
LONG=(W) 80.518843  
UTM (NAD83)(METERS)  
N. 4,376,832.3  
E. 541,361.8

**NOTES ON SURVEY**

1. TIES TO WELLS, CORNERS AND REFERENCES ARE BASED ON GRID NORTH FOR THE WV STATE PLANE COORDINATE SYSTEM NORTH ZONE NAD '27.
2. LEASE BOUNDARY SHOWN HEREON TAKEN FROM DEED BOOK 14 PAGE 302.
3. SURFACE OWNER AND ADJOINER INFORMATION TAKEN FROM THE ASSESSOR AND COUNTY CLERK RECORDS OF WETZEL COUNTY IN JULY, 2012.
4. WELL LAT./LONG. (NAD'27) ESTABLISHED BY DGPS(SURVEY GRADE TIE TO CORS NETWORK).
7. PLAT UPDATED ON 07/14/14 TO SHOW THE AS DRILLED PATH COORDINATES FROM INFORMATION PROVIDED BY EQT ON 12/03/13.

**LEGEND**

AS DRILLED ———  
PROPOSED - - - - -


**AS DRILLED INFORMATION**

<b>BOTTOM HOLE</b> WELL NO. WV 513726 STATE PLANE COORDINATES (NORTH ZONE) NAD 27 N. 380,436.5 E. 1,712,644.9 LAT=(N) 39.540047 LONG=(W) 80.518923 UTM (NAD83)(METERS) N. 4,376,828.8 E. 541,355.0	<b>WELL NO. WV 513726</b> STATE PLANE COORDINATES (NORTH ZONE) NAD 27 N. 385,078.8 E. 1,710,279.8 LAT=(N) 39.552718 LONG=(W) 80.527497 UTM (NAD83)(METERS) N. 4,378,231.2 E. 540,610.9
--	---



I THE UNDERSIGNED, HEREBY CERTIFY THAT THIS PLAT IS CORRECT TO THE BEST OF MY KNOWLEDGE AND BELIEF AND SHOWS ALL THE INFORMATION REQUIRED BY LAW AND THE REGULATIONS ISSUED AND PRESCRIBED BY THE DIVISION OF ENVIRONMENTAL PROTECTION.

P.S. 849 *C. Victor Moyers*

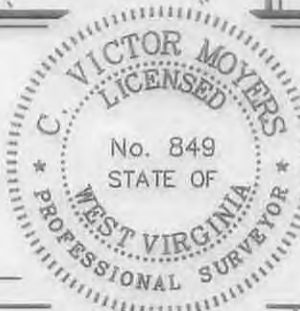

(\*) DENOTES LOCATION OF WELL ON UNITED STATES TOPOGRAPHIC MAPS.  
DATE APRIL 3, 20 13  
REVISED DATE JULY 14, 20 14  
OPERATORS WELL NO. WV 513726  
API WELL NO. 47 - 103 - 02902  
STATE COUNTY PERMIT

MINIMUM DEGREE OF ACCURACY 1/200 FILE NO. 6242ASDRILLED513726  
PROVEN SOURCE OF ELEVATION DGPS (SURVEY GRADE TIE TO CORS NETWORK) SCALE 1" = 1000'

STATE OF WEST VIRGINIA  
DIVISION OF ENVIRONMENTAL PROTECTION  
OFFICE OF OIL AND GAS

WELL TYPE: OIL  GAS  LIQUID INJECTION  WASTE DISPOSAL  IF "GAS" PRODUCTION  STORAGE  DEEP  SHALLOW

LOCATION: ELEVATION 919' (PAD ELEVATION) WATERSHED NORTH FORK FISHING CREEK DISTRICT GRANT COUNTY WETZEL QUADRANGLE BIG RUN 7.5

SURFACE OWNER EQT PRODUCTION COMPANY ACREAGE 53± ROYALTY OWNER J.M. ALLEN ESTATE ET AL LEASE ACREAGE 858± LEASE NO. 300645

PROPOSED WORK: DRILL  CONVERT  DRILL DEEPER  REDRILL  FRACTURE OR STIMULATE  PLUG OFF OLD FORMATION  PERFORATE NEW FORMATION  PLUG AND ABANDON  CLEAN OUT AND REPLUG  OTHER

PHYSICAL CHANGE IN WELL (SPECIFY) TARGET FORMATION GENESECO ESTIMATED DEPTH

WELL OPERATOR EQT PRODUCTION COMPANY DESIGNATED AGENT REX C. RAY  
ADDRESS 115 PROFESSIONAL PLACE BRIDGEPORT, WV 26330 P.O. BOX 280 ADDRESS 115 PROFESSIONAL BRIDGEPORT, WV 26330 P.O. BOX 280

10/31/2014

LONGITUDE 80°00'00" COUNTY TIME PERMIT