



PLAN AND PROFILE VIEW FOR GREEN DOT UNIT II 5H

PROFILE VIEW
1"=2000'

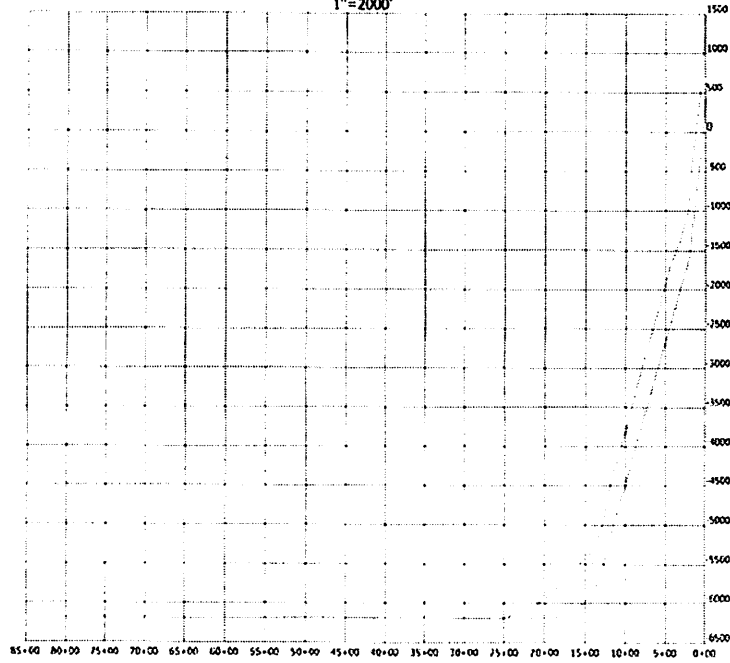

PLAN VIEW
1"=1000'

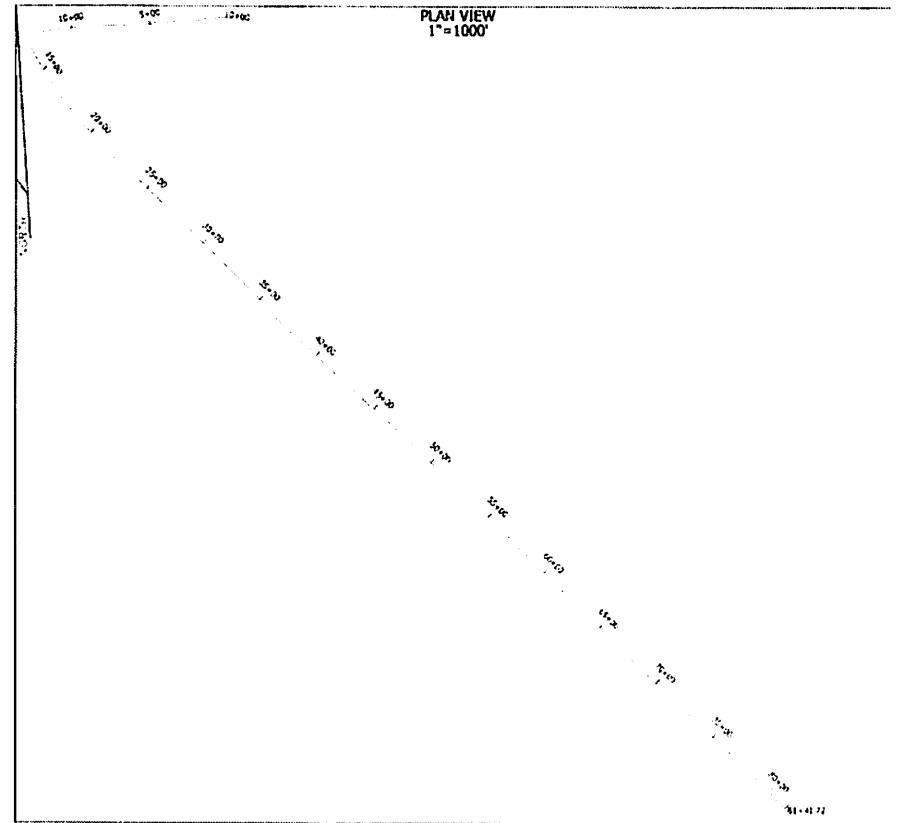

NOTES

1. AS DRILLED DATA WAS PROVIDED BY STATE OF USA ON-SHORE PROPERTIES INC.
2. HSM IS NOT VERIFYING THIS DATA AND IS BY NO MEANS RESPONSIBLE FOR ANY ERRORS OR INACCURACIES WITH THE DATA THAT HAS BEEN PROVIDED.

HUPP Surveying & Mapping
P.O. Box 647 Grantsville, WV 26147
(204) 364-7635 E-Mail: hupp@frontiernet.net

PL. DATE: 08/20/08
PROJECT: 08/08