

top hole 80°35' 30.42"
(80.591783) 2480'

LATITUDE 39°30' 00"

80°35' 00"

LONGITUDE


7690'

top hole 39°28' 43.90" (39.478861)

BLACKSHERE HEIRS, ET AL
+/- 6900 ACRE LEASE

UTM NAD 83
meters
top hole
N: 4369998.02
E: 535108.65

bottom hole
N: 4370618.81
E: 533814.28

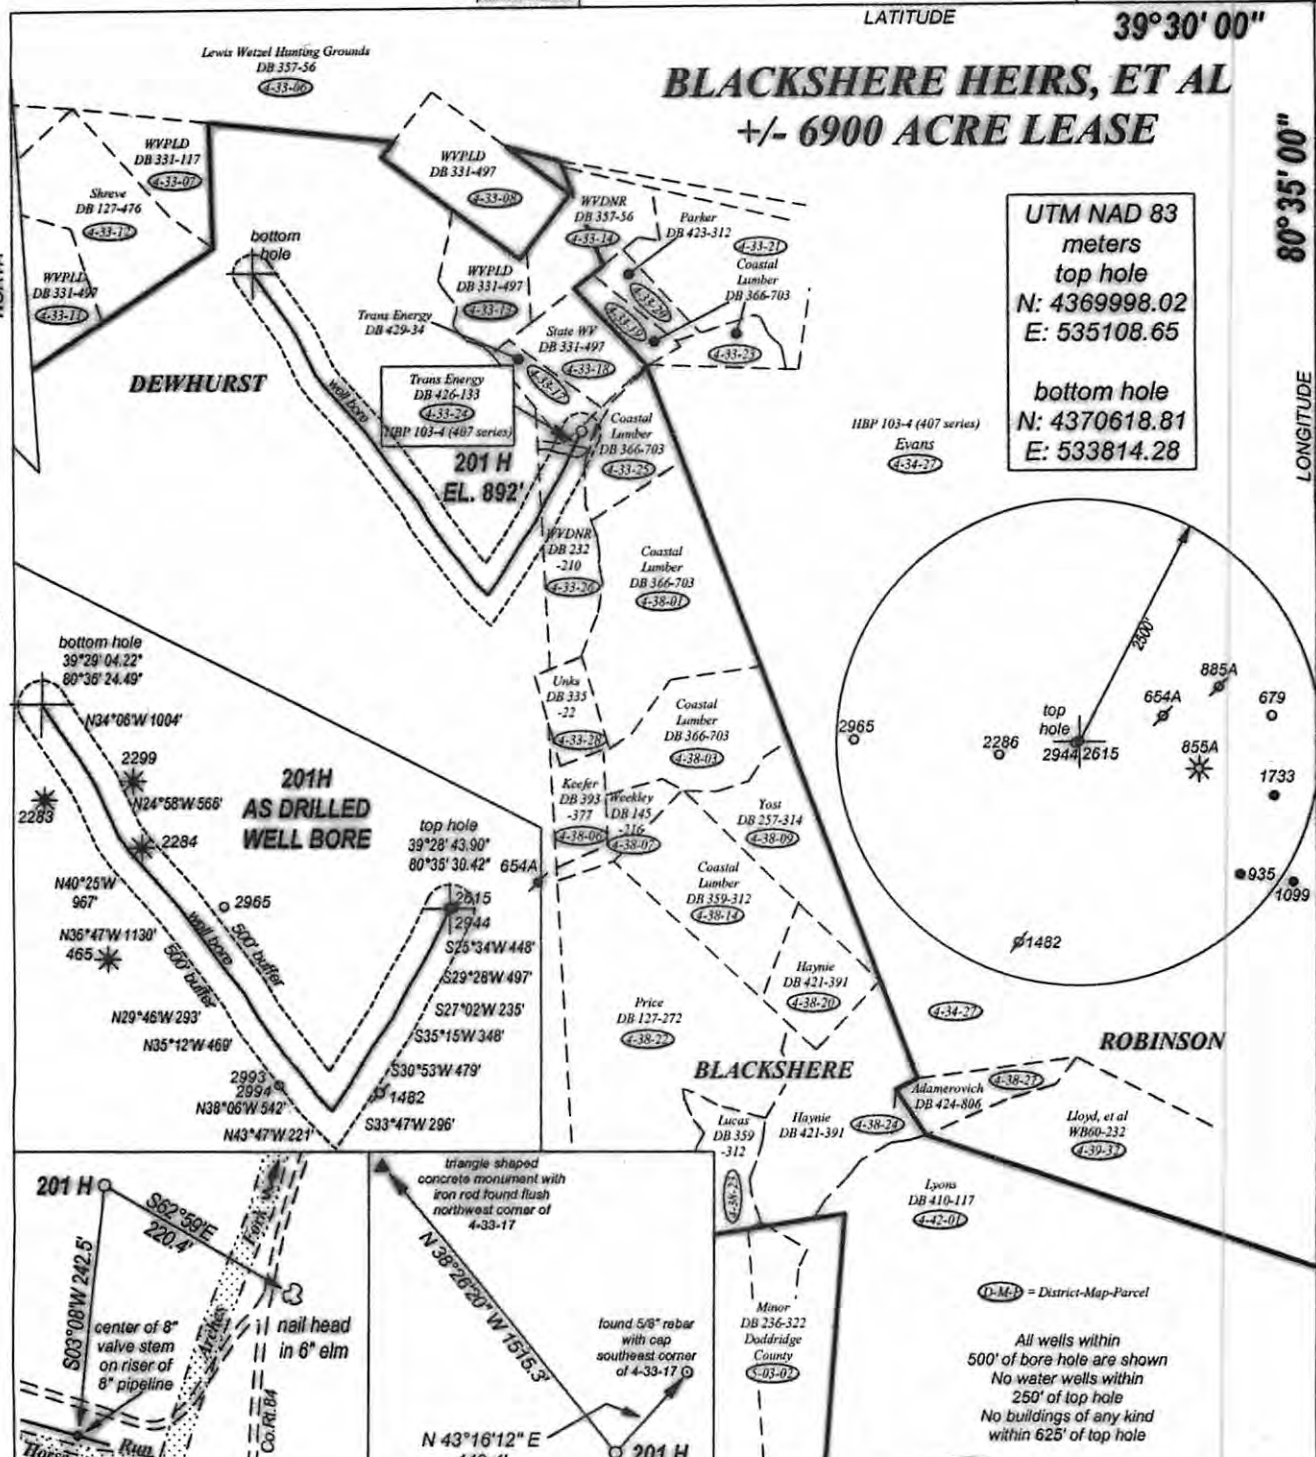

(D-M-P) = District-Map-Parcel

All wells within
500' of bore hole are shown
No water wells within
250' of top hole
No buildings of any kind
within 625' of top hole

FILE NO. _____
DRAWING NO. _____
SCALE 1" = 2500'
MINIMUM DEGREE
OF ACCURACY 1 : 200
PROVEN SOURCE
OF ELEVATION GPS
OBSERVATION

I, THE UNDERSIGNED, HEREBY CERTIFY THAT THE
PLAT IS CORRECT TO THE BEST OF MY KNOWLEDGE
AND BELIEF AND SHOWS ALL THE INFORMATION
REQUIRED BY LAW AND THE REGULATIONS ISSUED
AND PRESCRIBED BY THE DEPARTMENT OF ENERGY.

(SIGNED) _____
SURVEYOR: 551



STATE OF WEST VIRGINIA
DEPARTMENT OF ENERGY
DIVISION OF OIL AND GAS

DATE JANUARY 13TH, 2014
OPERATORS WELL NO. BLACKSHERE 201H

API 47 - 103 -02944
STATE COUNTY PERMIT

WELL TYPE: OIL GAS LIQUID INJECTION ___ WASTE DISPOSAL ___
(IF GAS) PRODUCTION STORAGE ___ DEEP ___ SHALLOW

LOATION: ELEVATION 892' WATER SHED ARCHES FORK
DISTRICT GRANT COUNTY WETZEL QUADRANGLE FOLSOM

SURFACE OWNER TRANS ENERGY, INC ACREAGE 4.675
OIL & GAS ROYALTY BLACKSHERE HEIRS LEASE AC. +/- 6900

PROPOSED WORK: DRILL CONVERT ___ DRILL DEEPER ___ REDRILL ___
FRACTURE OR STIMULATE ___ PLUG OFF OLD FORMATION ___
PERFORATE NEW FORMATION ___
OTHER PHYSICAL CHANGE IN WELL ___
PLUG AND ABANDON ___ CLEAN OUT AND REPLUG ___

TARGET FORMATION MARCELLUS SHALE ESTIMATED DEPTH 7022'

WELL OPERATOR TRANS ENERGY, INC. DESIGNATED AGENT LOREN BAGLEY
ADDRESS P. O. BOX 393 ADDRESS P. O. BOX 393
ST. MARYS, WV 26170 ST. MARYS, WV 26170

02/06/2015

FORM MW - 6

COUNTY NAME

PREMIT