



**Erlewine 5H**  
**Erlewine**  
**EQT Production Company**

Tract ID.	Tax Map No.	Parcel No.	County	District	Surface Tract Owner	Acres
1	6	46	Wetzel	Proctor	Richard L. Erlewine	136.18
2	6	30	Wetzel	Proctor	Albert Ray Anderson	102.63
3	6	38	Wetzel	Proctor	Ethyl Anderson EST	12.56
4	6	36	Wetzel	Proctor	Richard L. Erlewine	127.14
5	6	28	Wetzel	Proctor	Ray D. & Heather D. Yoho	2.74
6	6	26.3	Wetzel	Proctor	Michael G. & Kathleen F. Baxter	18.7
7	6	6	Wetzel	Proctor	Baxter Farm LLC	88.5
8	1	32	Wetzel	Proctor	Baxter Farm LLC	76.67
9	6	7.3	Wetzel	Proctor	Austin & Marlene Postlethwait	54.57
10	6	7.2	Wetzel	Proctor	Brian Lyle & Beth Ann Hayes	82.34
11	6	39	Wetzel	Proctor	Ethyl Anderson EST	1.42
12	6	40	Wetzel	Proctor	Kevin S. Goff	19.13
13	6	47	Wetzel	Proctor	Victor Richard Reed ET AL	5.55
14	7	34	Wetzel	Proctor	Kevin Goff	23.31
15	7	37	Wetzel	Proctor	Rost Energy Company	64.56
16	12	1	Wetzel	Proctor	Kevin Goff	28.69
17	11	5	Wetzel	Proctor	Emma L. & John J. Moore	30.34
18	11	3	Wetzel	Proctor	Christy Leek & Mary Wilson EST	52.33
19	6	45	Wetzel	Proctor	Christy Leek	29.51
20	6	45.1	Wetzel	Proctor	Donald F. & Martha J. Arrick	53.9
21	6	35	Wetzel	Proctor	Donald F. & Martha J. Arrick	58.96
22	6	23	Wetzel	Proctor	George Lemoyne Horner & Joseph Lemoyne Horner	156.55
23	6	24	Wetzel	Proctor	George R. Baxter	83.92
24	6	26.4	Wetzel	Proctor	Larry K. Keene	0.44
25	6	26	Wetzel	Proctor	Larry K. Keene	6.26
26	6	27.1	Wetzel	Proctor	Carolyn M. Lloyd	2.13
27	6	27.2	Wetzel	Proctor	Carolyn M. Lloyd	0.1
28	6	26.2	Wetzel	Proctor	Carolyn M. Lloyd	0.09
29	6	27	Wetzel	Proctor	Carolyn M. Lloyd	1.26
30	6	26.1	Wetzel	Proctor	Timothy F. Bridge	1.25
31	6	24	Wetzel	Proctor	George R. Baxter	83.92
32	6A	11.2	Wetzel	Proctor	Robert L. & Mary Ellen Stillwagoner	0.32
33	6A	10	Wetzel	Proctor	Jay Edward & Kathleen S. Smith	3.33
34	6A	9	Wetzel	Proctor	Joyce Kay Morris	3.47
35	6A	8	Wetzel	Proctor	Candis Darlene Clark	3.67
36	6A	7	Wetzel	Proctor	Janice Capobianco	8.42
37	6	5	Wetzel	Proctor	Steven & Susan Louise Hafer	8.68
38	6	4	Wetzel	Proctor	Steven J. Hafer	6.91
39	1	27	Wetzel	Proctor	Steven J. Hafer	79.29
40	1	28	Wetzel	Proctor	Floyd R. & Mitzie Lou Cecil	87.73
41	1	29	Wetzel	Proctor	Baxter Farm LLC	2.11
42	1	33	Wetzel	Proctor	William & Christina Wilkinson	0.99
43	1	N/A	Wetzel	Proctor	N/A	1.45
44	1	31	Wetzel	Proctor	Steven Jack & Susan Hafer	19.08
45	1	30	Wetzel	Proctor	Proctor Creek School	0.66
46	1	20	Wetzel	Proctor	Charles E. Frohnappel	124.67
47	1	34.1	Wetzel	Proctor	Herbert & Virginia Parsons	2.42
48	1	34	Wetzel	Proctor	Ronald J. Linda Petrecca	29.06
49	6	52	Wetzel	Proctor	Ronald J. Linda Petrecca	11.23

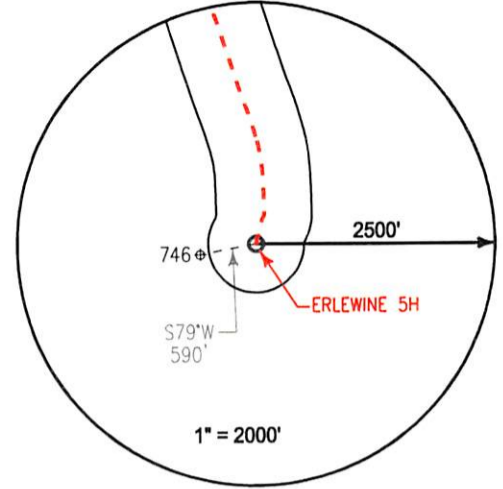

**Notes:**  
**ERLEWINE 5H As-Drilled coordinates are**  
 NAD 27 N: 433,710.000 E: 1,634,896.000  
 NAD 27 Lat: 39.683545 Long: -80.797303  
 NAD 83 UTM N: 4,392,663.079 E: 517,397.393  
**ERLEWINE 5H As-Drilled Landing Point coordinates are**  
 NAD 27 N: 434,821.153 E: 1,634,895.860  
 NAD 27 Lat: 39.686595 Long: -80.797361  
 NAD 83 UTM N: 4,393,001.600 E: 517,391.709  
**ERLEWINE 5H As-Drilled Bottom Hole coordinates are**  
 NAD 27 N: 438,658.563 E: 1,633,611.170  
 NAD 27 Lat: 39.697079 Long: -80.802123  
 NAD 83 UTM N: 4,394,164.149 E: 516,980.833  
 West Virginia Coordinates system of 1927 (North Zone)  
 based upon Differential GPS Measurements  
 Plat orientation, Corner and well ties are based upon  
 the grid north meridian  
 Well location references are based upon the grid north  
 meridian.  
 UTM coordinates are NAD83, Zone 17, Meters.

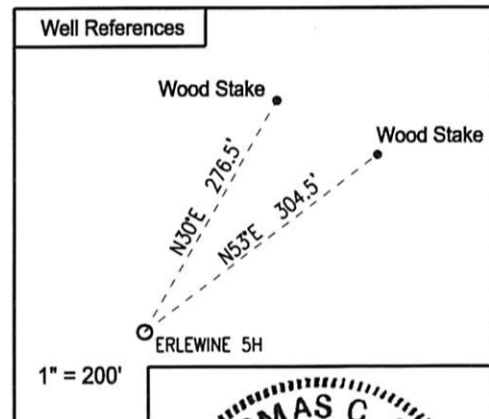

**LEGEND**

- ⊕ Active Well Location
- Proposed Gas Well
- Located Corner, as noted
- Surface Tract Lines
- - - Reference Line
- Lease Boundary
- Creek or Drain
- ⊙ WV County Route
- ⊠ WV State Route


**ERLEWINE PAD**

- ERLEWINE 5H
- ERLEWINE 3H
- ERLEWINE 1H
- ERLEWINE 2H
- ERLEWINE 4H
- ERLEWINE 7H
- ERLEWINE 10H
- ERLEWINE 8H
- ERLEWINE 6H



I, the undersigned, hereby certify that this plat is correct to the best of my knowledge and belief and shows all the information required by law and the regulations issued and prescribed by the Department of Environmental Protection.

*L. L. S.*  
**L. L. S. 687**

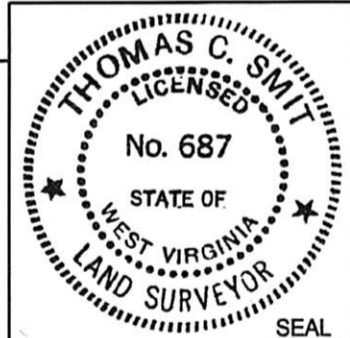


FILE NO: W2192 (BK 65-61)  
 DRAWING NO: \_\_\_\_\_  
 SCALE: 1" = 1000'  
 MINIMUM DEGREE OF ACCURACY:  
1:2500  
 PROVEN SOURCE OF ELEVATION:  
NGS CORS Station

**STATE OF WEST VIRGINIA**  
 DEPARTMENT OF ENVIRONMENTAL PROTECTION  
**OIL AND GAS DIVISION**

DATE: JUNE 25 20 19  
 OPERATORS WELL NO: ERLEWINE 5H  
**API WELL NO**  
47 - 103 - 02999  
 STATE COUNTY PERMIT

WELL TYPE:  OIL  GAS  LIQUID INJECTION  WASTE DISPOSAL  
 (IF GAS) PRODUCTION:  STORAGE  DEEP  SHALLOW  
 LOCATION ELEVATION: 1,212' (As-Built) WATERSHED: TRIBUTARY OF PROCTOR CREEK QUADRANGLE: NEW MARTINSVILLE 7.5'  
 DISTRICT: Proctor COUNTY: Wetzel  
 SURFACE OWNER: Richard Erlewine ACREAGE: 135 ±  
 ROYALTY OWNER: Ronald Carney, et ux LEASE NO: 873753 ACREAGE: 130.20 ±  
 PROPOSED WORK:  DRILL  CONVERT  DRILL DEEPER  FRACTURE OR STIMULATE  PLUG OFF OLD FORMATION  
 PERFORATE NEW FORMATION  OTHER PHYSICAL CHANGE IN WELL (SPECIFY) \_\_\_\_\_  
 PLUG AND ABANDON  CLEAN OUT AND REPLUG TARGET FORMATION: Marcellus ESTIMATED DEPTH: 6,532' (As-Drilled)  
 WELL OPERATOR: EQT Production Company DESIGNATED AGENT: Jason Ranson  
 ADDRESS: 2400 Ansys Drive, Suite 200 ADDRESS: 115 Professional Place PO Box 280  
Canonsburg, PA 15317 Bridgeport, WV 26330

**ERLEWINE 5H  
ERLEWINE  
EQT Production Company**

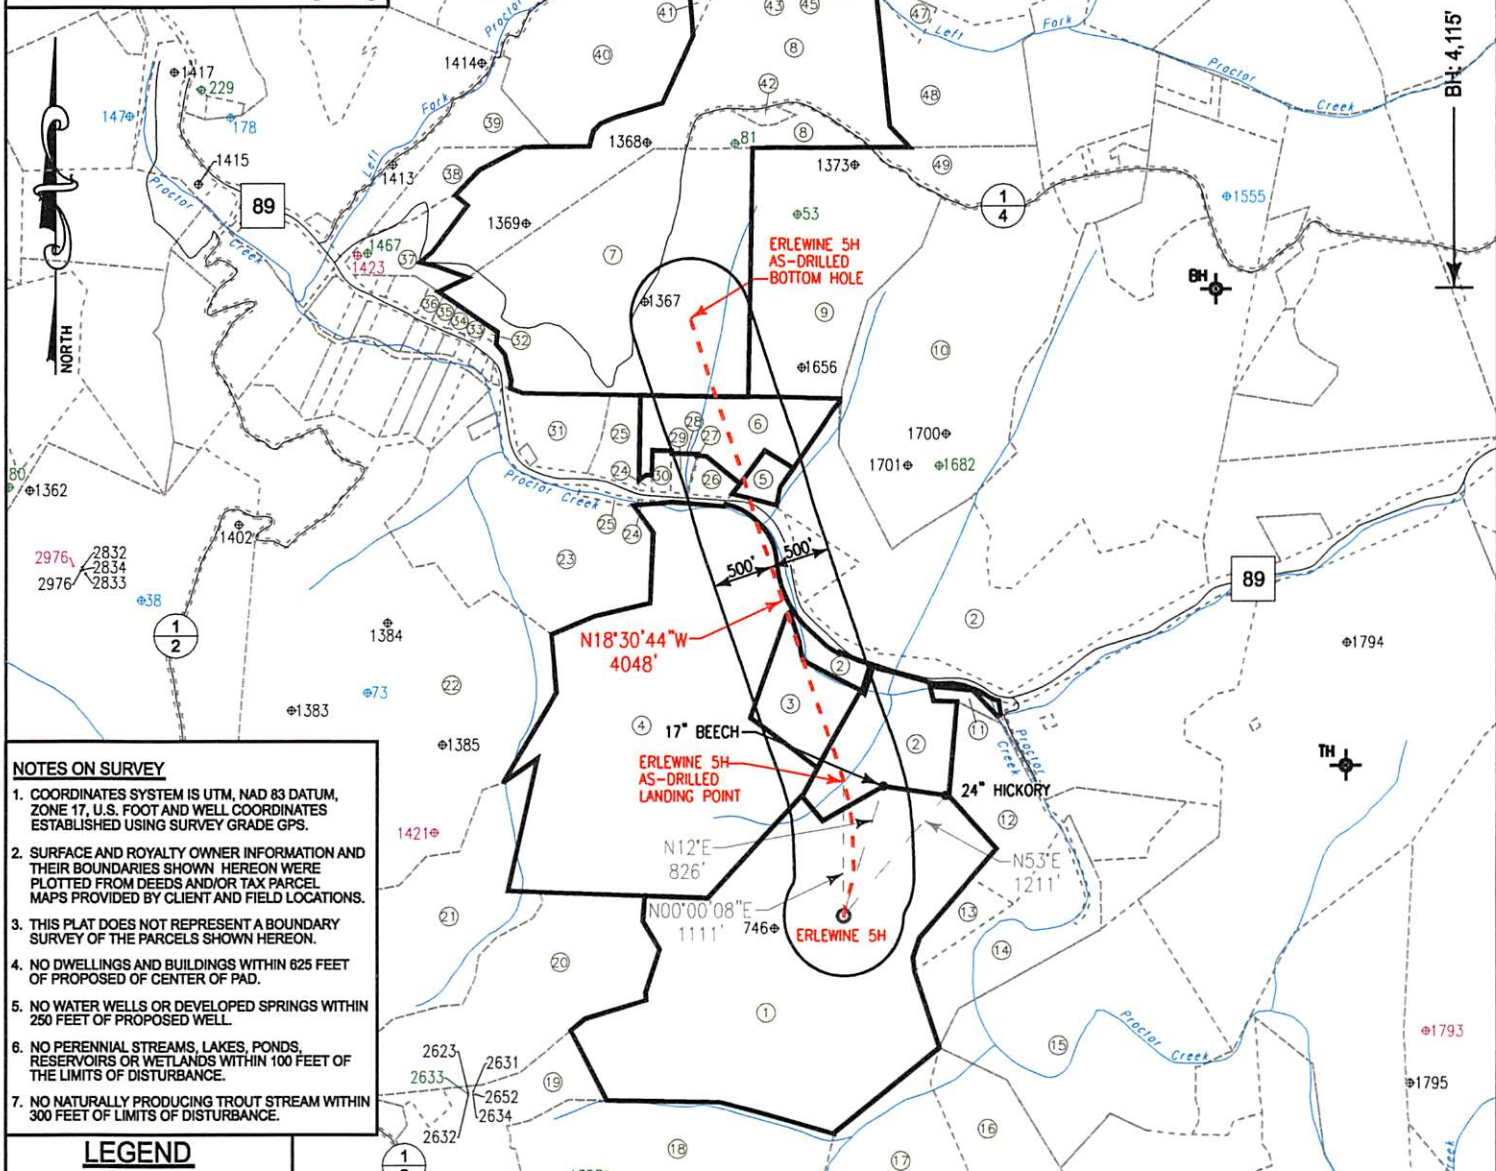

**NOTES ON SURVEY**

- COORDINATES SYSTEM IS UTM, NAD 83 DATUM, ZONE 17, U.S. FOOT AND WELL COORDINATES ESTABLISHED USING SURVEY GRADE GPS.
- SURFACE AND ROYALTY OWNER INFORMATION AND THEIR BOUNDARIES SHOWN HEREON WERE PLOTTED FROM DEEDS AND/OR TAX PARCEL MAPS PROVIDED BY CLIENT AND FIELD LOCATIONS.
- THIS PLAT DOES NOT REPRESENT A BOUNDARY SURVEY OF THE PARCELS SHOWN HEREON.
- NO DWELLINGS AND BUILDINGS WITHIN 625 FEET OF PROPOSED OF CENTER OF PAD.
- NO WATER WELLS OR DEVELOPED SPRINGS WITHIN 250 FEET OF PROPOSED WELL.
- NO PERENNIAL STREAMS, LAKES, PONDS, RESERVOIRS OR WETLANDS WITHIN 100 FEET OF THE LIMITS OF DISTURBANCE.
- NO NATURALLY PRODUCING TROUT STREAM WITHIN 300 FEET OF LIMITS OF DISTURBANCE.

**LEGEND**

- ⊕ Active Well Location
- ⊕ Plugged Well Location
- ⊕ Never Drilled
- ⊕ Abandoned Well
- ① Tract Identification
- Proposed Gas Well
- Located Corner, as noted
- Surface Tract Lines
- - - Reference Line
- Lease Boundary
- Creek or Drain
- Ⓢ WV County Route
- Ⓡ WV State Route

Tract ID.	Lease No.	Acres	Owner
1	873753	130.201343	Ronald Carney, et ux, et al
2	873427 & 873811	223.653484 OR 114.325057	Shiben Estates, Inc, et al
3	873728	11.654079	Albert R. Anderson, et al
4	873438	126.755241	Piney Holdings, Inc
5	873964	3.75426	Ray D. Yoho, et ux
6	873941	14.719421	Micheal G. Baxter, et ux
7	873671	187.739475	Clarence W. Baxter, et ux

(⊕) Denotes Location of Well on United States Topographic Maps

**KEYSTONE**  
CONSULTANTS, INC.

I, the undersigned, hereby certify that this plat is correct to the best of my knowledge and belief and shows all the information required by law and the regulations issued and prescribed by the Department of Environmental Protection.

*L. L. S. 687*

**L. L. S. 687**

**THOMAS C. SMIT**  
LICENSED  
No. 687  
STATE OF  
WEST VIRGINIA  
LAND SURVEYOR  
SEAL

FILE NO: W2192 (BK 65-61)  
DRAWING NO: \_\_\_\_\_  
SCALE: 1" = 1600'  
MINIMUM DEGREE OF ACCURACY: 1:2500  
PROVEN SOURCE OF ELEVATION: NGS CORS Station

**STATE OF WEST VIRGINIA**  
DEPARTMENT OF ENVIRONMENTAL PROTECTION  
**OIL AND GAS DIVISION**

DATE: JUNE 25 20 19  
OPERATORS WELL NO: ERLEWINE 5H  
API WELL NO  
47 - 103 - 02999  
STATE COUNTY PERMIT

WELL TYPE:  OIL  GAS  LIQUID INJECTION  WASTE DISPOSAL  
(IF GAS) PRODUCTION:  STORAGE  DEEP  SHALLOW

LOCATION ELEVATION: 1,212' (As-Built) WATERSHED: TRIBUTARY OF PROCTOR CREEK QUADRANGLE: NEW MARTINSVILLE 7.5'  
DISTRICT: Proctor COUNTY: Wetzel

SURFACE OWNER: Richard Erlewine ACREAGE: 135 ±  
ROYALTY OWNER: Ronald Carney, et ux LEASE NO: 873753 ACREAGE: 130.20 ±

PROPOSED WORK:  DRILL  CONVERT  DRILL DEEPER  FRACTURE OR STIMULATE  PLUG OFF OLD FORMATION  
 PERFORATE NEW FORMATION  OTHER PHYSICAL CHANGE IN WELL (SPECIFY) \_\_\_\_\_  
 PLUG AND ABANDON  CLEAN OUT AND REPLUG TARGET FORMATION: Marcellus ESTIMATED DEPTH: 6,532' (As-Drilled)

WELL OPERATOR: EQT Production Company DESIGNATED AGENT: Jason Ranson  
ADDRESS: 2400 Ansys Drive, Suite 200 ADDRESS: 115 Professional Place PO Box 280  
Canonsburg, PA 15317 Bridgeport, WV 26330