


API # & DISTANCE TO WELL
 103-01688 - N 82°07'05" W 279'
 103-01738 - N 24°59'01" W 662'
 103-01645 - S 35°26'32" W 704'
 103-71815 - N 71°05'16" E 815'
 103-01937 - N 88°02'51" W 915'
 103-71811 - N 57°26'39" E 1173'
 103-70041 - N 46°19'10" E 1223'
 103-01086 - S 83°43'00" W 1393'
 103-02663 - N 67°38'53" W 1458'

REFERENCE NOTE
 Boundaries as shown taken from deeds, tax maps and field locations. A full boundary survey is not expressed nor implied. All bearings are based on true north. Ownership taken from public records. WEIZEL County, West Virginia JANUARY 2022. State Plane Coordinates & NAD 83 Lat/Long by differential submeter mapping grade GPS. Drafted by: EAH.

FILE #: TRB1
 DRAWING #: 3054
 SCALE: PLAT: 1" = 2000'
TICK: 1" = 2000'
 PROVEN SOURCE OF ELEVATION: SUBMETER MAPPING GRADE GPS

I, THE UNDERSIGNED, HEREBY CERTIFY THAT THIS PLAT IS CORRECT TO THE BEST OF MY KNOWLEDGE AND BELIEF AND SHOWS ALL THE INFORMATION REQUIRED BY LAW AND THE REGULATIONS ISSUED AND PRESCRIBED BY

Signed: [Signature]
 L.L.S. #2124: Ernest J. Benchek III

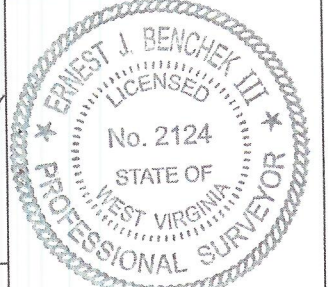

(+) DENOTES LOCATION OF WELL ON UNITED STATES TOPOGRAPHIC MAPS WVDEP
 OFFICE OF OIL & GAS
 601 57TH STREET
 CHARLESTON, WV 25304
 Well Type: Oil Waste Disposal Production Deep
 Gas Liquid Injection Storage Shallow
 WATERSHED: FISHING CREEK
 COUNTY/DISTRICT: WETZEL / GREENE
 SURFACE OWNER: J.S. BOOTH ESTATE AND DALLISON LUMBER
 OIL & GAS ROYALTY OWNER: JAMES K. BOOTH & JERRY MARTIN BOOTH
 LEASE NUMBERS: _____
 TARGET FORMATION: MARCELLUS
 WELL OPERATOR: TRIBUNE RESOURCES, LLC
 ADDRESS: 3861 AMBASSADOR CAFFERY PARKWAY SUITE 600
 CITY: LAFAYETTE STATE: LA ZIP CODE: 70503

DATE: NOVEMBER 10, 2023
 OPERATOR'S WELL #: Reilly N GRN WZ 3H
 API WELL #: 47 103 03090
 STATE COUNTY PERMIT
 AS-BUILT ELEVATION: 1,474'
 QUADRANGLE: CENTER POINT
 ACREAGE: 21.00 +/-
 ACREAGE: 1,462.144 +/-
 DRILL CONVERT DRILL DEEPER REDRILL FRACTURE OR STIMULATE
 PLUG OFF FORMATION PERFORATE NEW FORMATION PLUG & ABANDON
 CLEAN OUT & REPLUG OTHER CHANGE (SPECIFY): _____
 DRILLED DEPTH: TVD: 7,500' TMD: 24,257'
 DESIGNATED AGENT: HARMAN BROWN
 ADDRESS: 18396 MOUNTAINEER HIGHWAY
 CITY: WILEYVILLE STATE: WV ZIP CODE: 26581

04/19/2024

[Signature]

PROPERTY OWNER INDEX	
5-23-38	J S BOOTH ESTATE
5-23-33	J S BOOTH ESTATE
5-23-37	BERYL FLUHARTY ET AL
5-26-1	STATE OF WEST VIRGINIA
5-26-2	STATE OF WEST VIRGINIA
5-26-4	STATE OF WEST VIRGINIA
5-26-15	STATE OF WEST VIRGINIA
5-8-11	DONALD L. MCCOY
5-8-12	DONALD L. MCCOY
5-27-1	STATE OF WEST VIRGINIA
5-8-25	CHARLES AND LISA CRAMER
5-8-25.1	STEPHEN & KAREN JASKO
5-8-46	CHARLES AND LISA CRAMER
5-8-41	CHESTER C. YEATER TRUST
5-8-42	HERBERT & PERCILLA EFAW

LEASE INDEX			
A	MARC00702-000	I	MARC00780-001
B	MARC01113-001	J	MARC001136-000
C	MARC01045-000	K	MARC00860-001
D	MARC00746-000	L	MARC00864-001
E	MARC00741-000	M	MARC00860-001
F	MARC00751-000	N	MARC00860-001
G	MARC013212-50	O	MARC00855-001
H	MARC00716-000		

04/19/2024

FILE #: TRB1
 DRAWING #: 3054
 SCALE: N/A

DATE: NOVEMBER 10, 2023
 OPERATOR'S WELL #: REILLY N GRN WZ 3H
 API WELL #: 47 103 03090
 STATE COUNTY PERMIT