


FILE #: TRB1  
 DRAWING #: 3071  
 SCALE: PLAT: 1" = 1800'  
 TICK: 1" = 2000'  
 MINIMUM DEGREE OF ACCURACY: 1/200  
 PROVEN SOURCE OF ELEVATION: SUBMETER MAPPING GRADE GPS

I, THE UNDERSIGNED, HEREBY CERTIFY THAT THIS PLAT IS CORRECT TO THE BEST OF MY KNOWLEDGE AND BELIEF AND SHOWS ALL THE INFORMATION REQUIRED BY LAW AND THE REGULATIONS ISSUED AND PRESCRIBED BY THE DEPARTMENT OF ENVIRONMENTAL PROTECTION.  
 Signed: *[Signature]*  
 L.L.S. #2124 : Ernest J. Benchek III

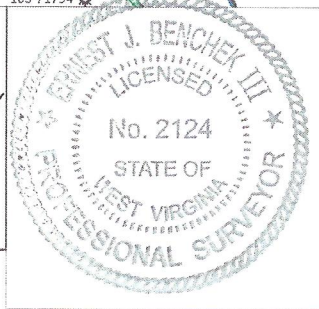

(+) DENOTES LOCATION OF WELL ON UNITED STATES TOPOGRAPHIC MAPS WVDEP  
 OFFICE OF OIL & GAS  
 601 57TH STREET  
 CHARLESTON, WV 25304  
 Well Type:  Oil  Waste Diposal  Production  Deep  Gas  Liquid Injection  Storage  Shallow  
 WATERSHED: FISHING CREEK  
 COUNTY/DISTRICT: WETZEL / GREEN  
 SURFACE OWNER: J.S. BOOTH ESTATE AND DALLISON LUMBER  
 OIL & GAS ROYALTY OWNER: JERRY MARTIN BOOTH AND TRIBUNE RESOURCES, LLC  
 LEASE NUMBERS: \_\_\_\_\_

DATE: NOVEMBER 10, 2023  
 OPERATOR'S WELL #: Reilly S GRN WZ 6H  
 API WELL #: 47 103 03093  
 STATE COUNTY PERMIT  
 AS-BUILT ELEVATION: 1,474'  
 QUADRANGLE: CENTER POINT  
 ACREAGE: 21.00 +/-  
 ACREAGE: 1,281.2 +/-

DRILL  CONVERT  DRILL DEEPER  REDRILL  FRACTURE OR STIMULATE   
 PLUG OFF FORMATION  PERFORATE NEW FORMATION  PLUG & ABANDON   
 CLEAN OUT & REPLUG  OTHER CHANGE  (SPECIFY): \_\_\_\_\_  
 TARGET FORMATION: MARCELLUS  
 WELL OPERATOR: TRIBUNE RESOURCES, LLC  
 ADDRESS: 3861 AMBASSADOR CAFFERY PARKWAY SUITE 600  
 CITY: LAFAYETTE STATE: LA ZIP CODE: 70503  
 DRILLED DEPTH: TVD: 7,363' TMD: 17,967'  
 DESIGNATED AGENT: HARMAN BROWN  
 ADDRESS: 18396 MOUNTAINEER HIGHWAY  
 CITY: WILEYVILLE STATE: WV ZIP CODE: 26581

04/19/2024

*[Handwritten mark]*

| PROPERTY OWNER INDEX |                            |
|----------------------|----------------------------|
| 5-23-38              | J S BOOTH ESTATE           |
| 5-23-33              | J S BOOTH ESTATE           |
| 5-26-1               | STATE OF WEST VIRGINIA     |
| 5-26-2               | STATE OF WEST VIRGINIA     |
| 5-23-37              | BERYL FLUHARTY ET AL       |
| 5-23-32              | JOHN S. KNIGHT             |
| 5-23-25.1            | ASCENT RESOURCES MARCELLUS |
| 5-23-21.1            | ASCENT RESOURCES MARCELLUS |
| 5-23-16              | ANDERSON W. WILEY          |
| 5-23-10              | FRANCISE L. FLUHARTY       |
| 5-23-11              | WILEY CEMETERY             |
| 5-23-6               | PATSY HALL                 |
| 5-23-2               | ELIZABETH MILLER ESTATE    |
| 5-23-1               | GERALD E. BOGGS ET AL      |
| 5-23-17              | GERALD W. DULANEY          |
| 5-22-9               | COASTAL FOREST RESOURCES   |
| 5-20-37              | COASTAL FOREST RESOURCES   |
| 5-22-17              | GERALD W. DULANEY          |

| LEASE INDEX |               |   |               |
|-------------|---------------|---|---------------|
| A           | MARC00702-000 | H | MARC03101-004 |
| B           | MARC01045-000 | I | MARC03104-193 |
| C           | MARC00746-000 | J | MARC00735-001 |
| D           | MARC01113-001 | K | MARC00983-001 |
| E           | MARC02997-000 | L | MARC00756-000 |
| F           | MARC03094-000 | M | MARC00782-001 |
| G           | MARC03104-118 | N | MARC05000-003 |
|             |               | O | MARC04099-000 |

04/19/2024

FILE #: TRB1

DRAWING #: 3071

SCALE: N/A

DATE: NOVEMBER 10, 2023

OPERATOR'S WELL #: REILLY S GRN WZ 6H

API WELL #: 47 103 03093  
STATE COUNTY PERMIT