

WW-7
8-30-06



West Virginia Department of Environmental Protection
Office of Oil and Gas

WELL LOCATION FORM: GPS

API: 47-103-03264 WELL NO.: 6344
 FARM NAME: BRAME HIGGINS
 RESPONSIBLE PARTY NAME: WEST VIRGINIA LAND RESOURCES INC.
 COUNTY: WETZEL DISTRICT: GRANT
 QUADRANGLE: WALLACE W.VA
 SURFACE OWNER: ROBERT P. & RANDALL B. NICHOLS
 ROYALTY OWNER: _____
 UTM GPS NORTHING: 4,371,921 m (997')
 UTM GPS EASTING: 543,496 m GPS ELEVATION: 304 m

The Responsible Party named above has chosen to submit GPS coordinates in lieu of preparing a new well location plat for a plugging permit or assigned API number on the above well. The Office of Oil and Gas will not accept GPS coordinates that do not meet the following requirements:

- Datum: NAD 1983, Zone: 17 North, Coordinate Units: meters, Altitude: height above mean sea level (MSL) – meters.
- Accuracy to Datum – 3.05 meters
- Data Collection Method:

Survey grade GPS : Post Processed Differential _____
 Real-Time Differential

Mapping Grade GPS _____ : Post Processed Differential _____
 Real-Time Differential _____

- Letter size copy of the topography map showing the well location.

I the undersigned, hereby certify this data is correct to the best of my knowledge and belief and shows all the information required by law and the regulations issued and prescribed by the Office of Oil and Gas.

Signature

Professional Surveyor

Title

NOVEMBER 9, 2022

Date

01/13/2023
Stephen McCoy

RECEIVED
Office of Oil and Gas


DEC 3 2022

WV Department of
Environmental Protection

4883 1/2 SE
(BIG RUN)

UNITED STATES
DEPARTMENT OF THE INTERIOR
GEOLOGICAL SURVEY

4710303264 P

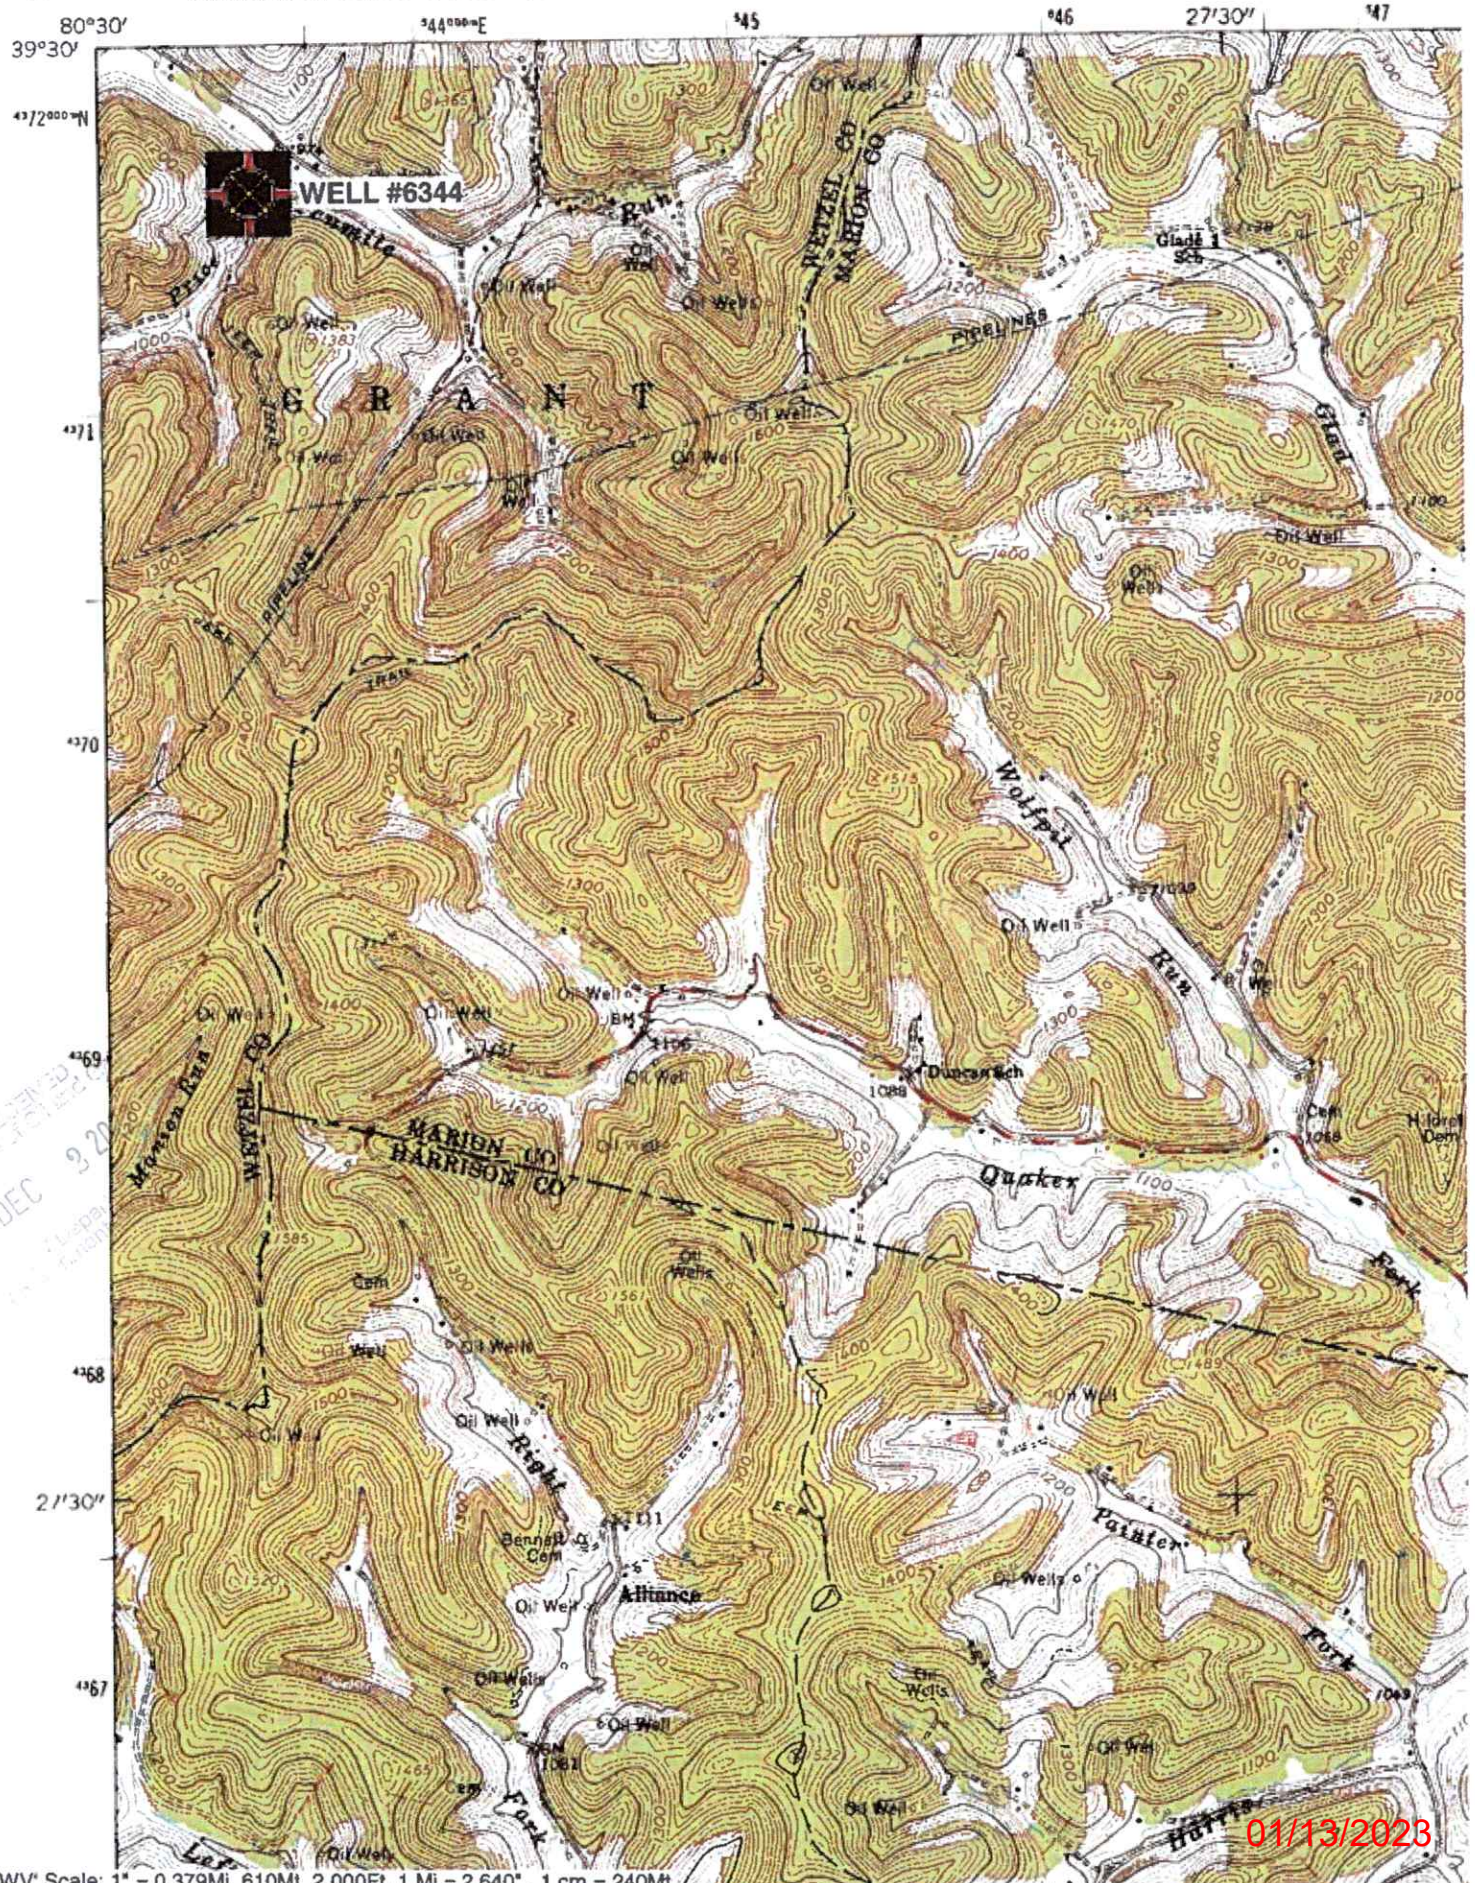

RECEIVED
DEC 9 2011
ALABAMA
GEOLOGICAL SURVEY

01/13/2023