

Pittsburgh Coal: state of W.Va.
 Mapletown Coal: W.T. Price
 R.D.#1, Smithfield, W.Va.
 Surface: D.O. Talkington
 R.D.#1, Smithfield, W.Va.

4.04 411 W
 0.28 ~~SA~~ Q

NOV 18 1941

New Location...
 Drill Deeper...
 Abandonment...


N3+4 E7+8 Map N59

Company South Penn Natural Gas Co.
 Address Parkersburg, W.Va.
 Farm Peterson - Price
 Tract _____ Acres 165 Lease No. 38878
 Well (Farm) No. 2 Serial No. _____
 Elevation (Spirit Level) 1156.56
 Quadrangle Clarksburg
 County Wetzel District Grant
 Engineer Emmon Haines
 Engineer's Registration No. _____
 File No. _____ Drawing No. _____
 Date Sept. 25, 1941 Scale 1" = 400'

STATE OF WEST VIRGINIA
 DEPARTMENT OF MINES
 OIL AND GAS DIVISION
 CHARLESTON

WELL LOCATION MAP
 FILE NO. WET-399A

+ Denotes location of well on United States Topographic Maps, scale 1 to 62 500, latitude and longitude lines being represented by border lines as shown.
 - Denotes one inch spaces on border line of original tracing.

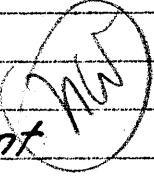

STATE OF WEST VIRGINIA
DEPARTMENT OF MINES
OIL AND GAS DIVISION

870

WELL RECORD

Ad 399-A
Permit No. 399-A


Oil or Gas Well **OIL**
(KIND)

Company **South Penn Natural Gas Company**
Address **Union Trust Bldg. Parkersburg, W. Va.**
Farm **Peterson-Price** Acres **165**
Location (waters) **Price Fork**
Well No. **2** Elev. **1156.56**
District **Grant** County **Wetzel**
The surface of tract is owned in fee by **D.C. Talkington**
Address **Smithfield, W. Va.**
Mineral rights are owned by **Hampden Corporation et al**
605 Why. Bkg. & Tr. Bldg. Wheeling, W. Va.
Drilling commenced **July 15, 1903**
Drilling completed **October 10, 1903**
Date shot **Aug. 28-1903, 16 ft.** Depth of shot **---**
Aug. 11-1903, 30 ft. **Feb. 14-1911 9- ft.**
Open Flow **---** /10ths Water in **---** Inch
--- /10ths Merc. in **---** Inch
Volume **---** Cu. Ft.
Rock Pressure **25** lbs **---** hrs.
Oil **---** bbls., 1st 24 hrs.
Fresh water **---** feet **---** feet
Salt water **---** feet **---** feet

Casing and Tubing	Used in Drilling	Left in Well	Packers
Size			Kind of Packer
16.			---
13.			---
10.	258' (Pulled)		Size of
8 1/4.	1615' (Pulled)		---
6.	2344'		Depth set
5 3/16.	2466'		---
3.			Perf. top
2.			Perf. bottom
Liners Used			Perf. top
Cond.	16'		Perf. bottom

CASING CEMENTED **---** SIZE **---** No. Ft. **---** Date **---**
COAL WAS ENCOUNTERED AT **1044** FEET **72** INCHES
--- FEET **---** INCHES **---** FEET **---** INCHES
--- FEET **---** INCHES **---** FEET **---** INCHES

Formation	Color	Hard or Soft	Top	Bottom	Oil, Gas or Water	Depth Found	Remarks
Pittsburgh Coal			1044	1050			
Dunkard Sand			1555	1615			
Salt Sand			1795	2000			
Little Lime			2235	2250			
Pencil Cave			2250	2250			
Big Lime			2260	2340			
Big Injun Sand			2340	2455			
Fifty Foot			2960	3005			
Red Rock			3020	3045			
Gordon Stray			3099	3137			
Gordon Sand			3140	3167	Oil	3134	
Total Depth				3170			

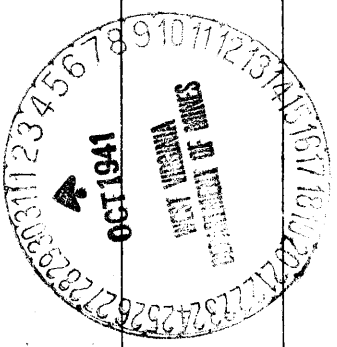

Formation	Color	Hard or Soft	Top	Bottom	Oil, Gas or Water	Depth Found	Remarks

SOUTH PENN. NATURAL GAS COMPANY
88888 30, 1941.

Date....., 194.....

APPROVED *Alvin E. ...* Agent, Owner

By..... (Title)