

COAL: ROBINSON IMPROVEMENT CO.
THE PLAINS, VA.

SURFACE: HUGH MARTIN
WYATT, W. VA.

NEW LOCATION
DRILL DEEPER
ABANDONMENT X

✓ APR - 5 1946
N 3 E 7

0.17 W
1.38 A

MAP N 59

<p>COMPANY ROAD SUPPLY COMPANY</p> <p>ADDRESS SALEM, W. VA.</p> <p>FARM GENINE • ROBINSON</p> <p>TRACT ACRES 300 LEASE NO.</p> <p>WELL (FARM) NO. 58 SERIAL NO.</p> <p>ELEVATION (SPIRIT LEVEL) 1385.87</p> <p>QUADRANGLE CENTERPOINT</p> <p>COUNTY WETZEL DIST. GRANT</p> <p>ENGINEER E. C. TALLER</p> <p>ENGINEER'S REGISTRATION NO.</p> <p>FILE NO. DRAWING NO.</p> <p>DATE 7/18/41 SCALE 1" = 800'</p>	<p>STATE OF WEST VIRGINIA</p> <p>DEPARTMENT OF MINES OIL AND GAS DIVISION</p> <p>CHARLESTON</p> <p>WELL LOCATION MAP</p> <p>FILE NO. WET 520 A</p> <p>+ DENOTES LOCATION OF WELL ON UNITED STATES TOPOGRAPHIC MAPS, SCALE 1 TO 62,500 LATITUDE AND LONGITUDE LINES BEING REPRESENTED BY BORDER LINES AS SHOWN.</p> <p>- DENOTES ONE INCH SPACES ON BORDER LINE OF ORIGINAL TRACING.</p>
--	---

GENINE ROBINSON TR. 58 - ROAD SUPPLY CO. - WET-520-A



989

STATE OF WEST VIRGINIA
DEPARTMENT OF MINES
OIL AND GAS DIVISION

WELL RECORD

Permit No. 570-A

Oil or Gas Well Oil
(KIND)


Company Raad Supply Company
Address 184 E. Main St., Salem, W. Va.
Farm Genine Robinson Acres 300
Location (waters) _____
Well No. 58 Elev. 1385.87
District Grant County Wetzel
The surface of tract is owned in fee by Mr. Hugh Martin
Address Wyatt, W. Va.
Mineral rights are owned by Robinson Improvement Co.
Address The Plains, Va.

Casing and Tubing	Used in Drilling	Left in Well	Packers
Size			
16			Kind of Packer
13			
10	380'	None	Size of
8 1/4	1740'	1740'	<u>586</u>
6 5/8	2686'	2686'	Depth set <u>586</u>
5 3/16			
3			Perf. top
2	3378	3378	Perf. bottom
Liners Used			Perf. top
			Perf. bottom

Drilling commenced _____
Drilling completed March 26, 1906
Date Shot 1/16/07 From 3323 To _____
With 11/18/09 3314
Open Flow 10/29/15 3312 Inch
3/12/41 3314 Inch
/10ths Merc. in _____
Volume _____ Cu. Ft.
Rock Pressure _____ lbs. _____ hrs.
Oil _____ bbls., 1st 24 hrs.
Fresh water _____ feet _____ feet
Salt water _____ feet _____ feet

CASING CEMENTED No SIZE _____ No. Ft. _____ Date _____
COAL WAS ENCOUNTERED AT 1265 FEET 60 INCHES
_____ FEET _____ INCHES FEET _____ INCHES
_____ FEET _____ INCHES FEET _____ INCHES

Formation	Color	Hard or Soft	Top	Bottom	Oil, Gas or Water	Depth Found	Remarks
Conductor			16'				
Pittsburgh Coal			1260	1265			
Little Dunkard Sand			1590	1720			
Big Dunkard Sand			1740	1785			
Salt Sand			2135	2225			
Gas			1935				
Little Lime			2460	2475			
Pencil Cave			2475	2480			
Big Lime			2480	2560			
Big Injun Sand			2560	2640			
Fifty Foot Sand			3145	3165			
Thirty Foot Sand			3234	3270			
Stray Sand			3282	3342			
Gordon Sand			3354	3373			
1st Pay			3314	3324			
2nd Pay			3362				
Total Depth			3378				

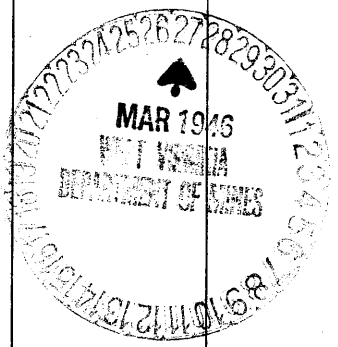

Formation	Color	Hard or Soft	Top	Bottom	Oil, Gas or Water	Depth Found	Remarks

Date March 26, 1946

APPROVED Road Supply Co., Owner

By J. M. Road, manager, owner
(Title)