

47-103 - 03318P

WW-7
8-30-06



RECEIVED
Office of Oil and Gas

MAY 20 2019

WV Department of
Environmental Protection

West Virginia Department of Environmental Protection
Office of Oil and Gas

WELL LOCATION FORM: GPS

API: 47-103-31007 WELL NO.: 8276

FARM NAME: GEO. N. STOCKDALE

RESPONSIBLE PARTY NAME: CONSOLIDATION COAL COMPANY

COUNTY: WETZEL DISTRICT: CHURCH

QUADRANGLE: HUNDRED WV, PA 7.5'

SURFACE OWNER: ALBERT E. & BRENDA S. REYNOLDS

ROYALTY OWNER: _____

UTM GPS NORTHING: 4,389,198 m

UTM GPS EASTING: 549,973 m GPS ELEVATION: 409 m (1341')

The Responsible Party named above has chosen to submit GPS coordinates in lieu of preparing a new well location plat for a plugging permit or assigned API number on the above well. The Office of Oil and Gas will not accept GPS coordinates that do not meet the following requirements:

1. Datum: NAD 1983, Zone: 17 North, Coordinate Units: meters, Altitude: height above mean sea level (MSL) – meters.
2. Accuracy to Datum – 3.05 meters
3. Data Collection Method:

Survey grade GPS _____ : Post Processed Differential _____

Real-Time Differential _____

Mapping Grade GPS X : Post Processed Differential X

Real-Time Differential _____


4. Letter size copy of the topography map showing the well location.

I the undersigned, hereby certify this data is correct to the best of my knowledge and belief and shows all the information required by law and the regulations issued and prescribed by the Office of Oil and Gas.

[Signature]
Signature

Professional Surveyor
Title

MAY 7, 2019
Date

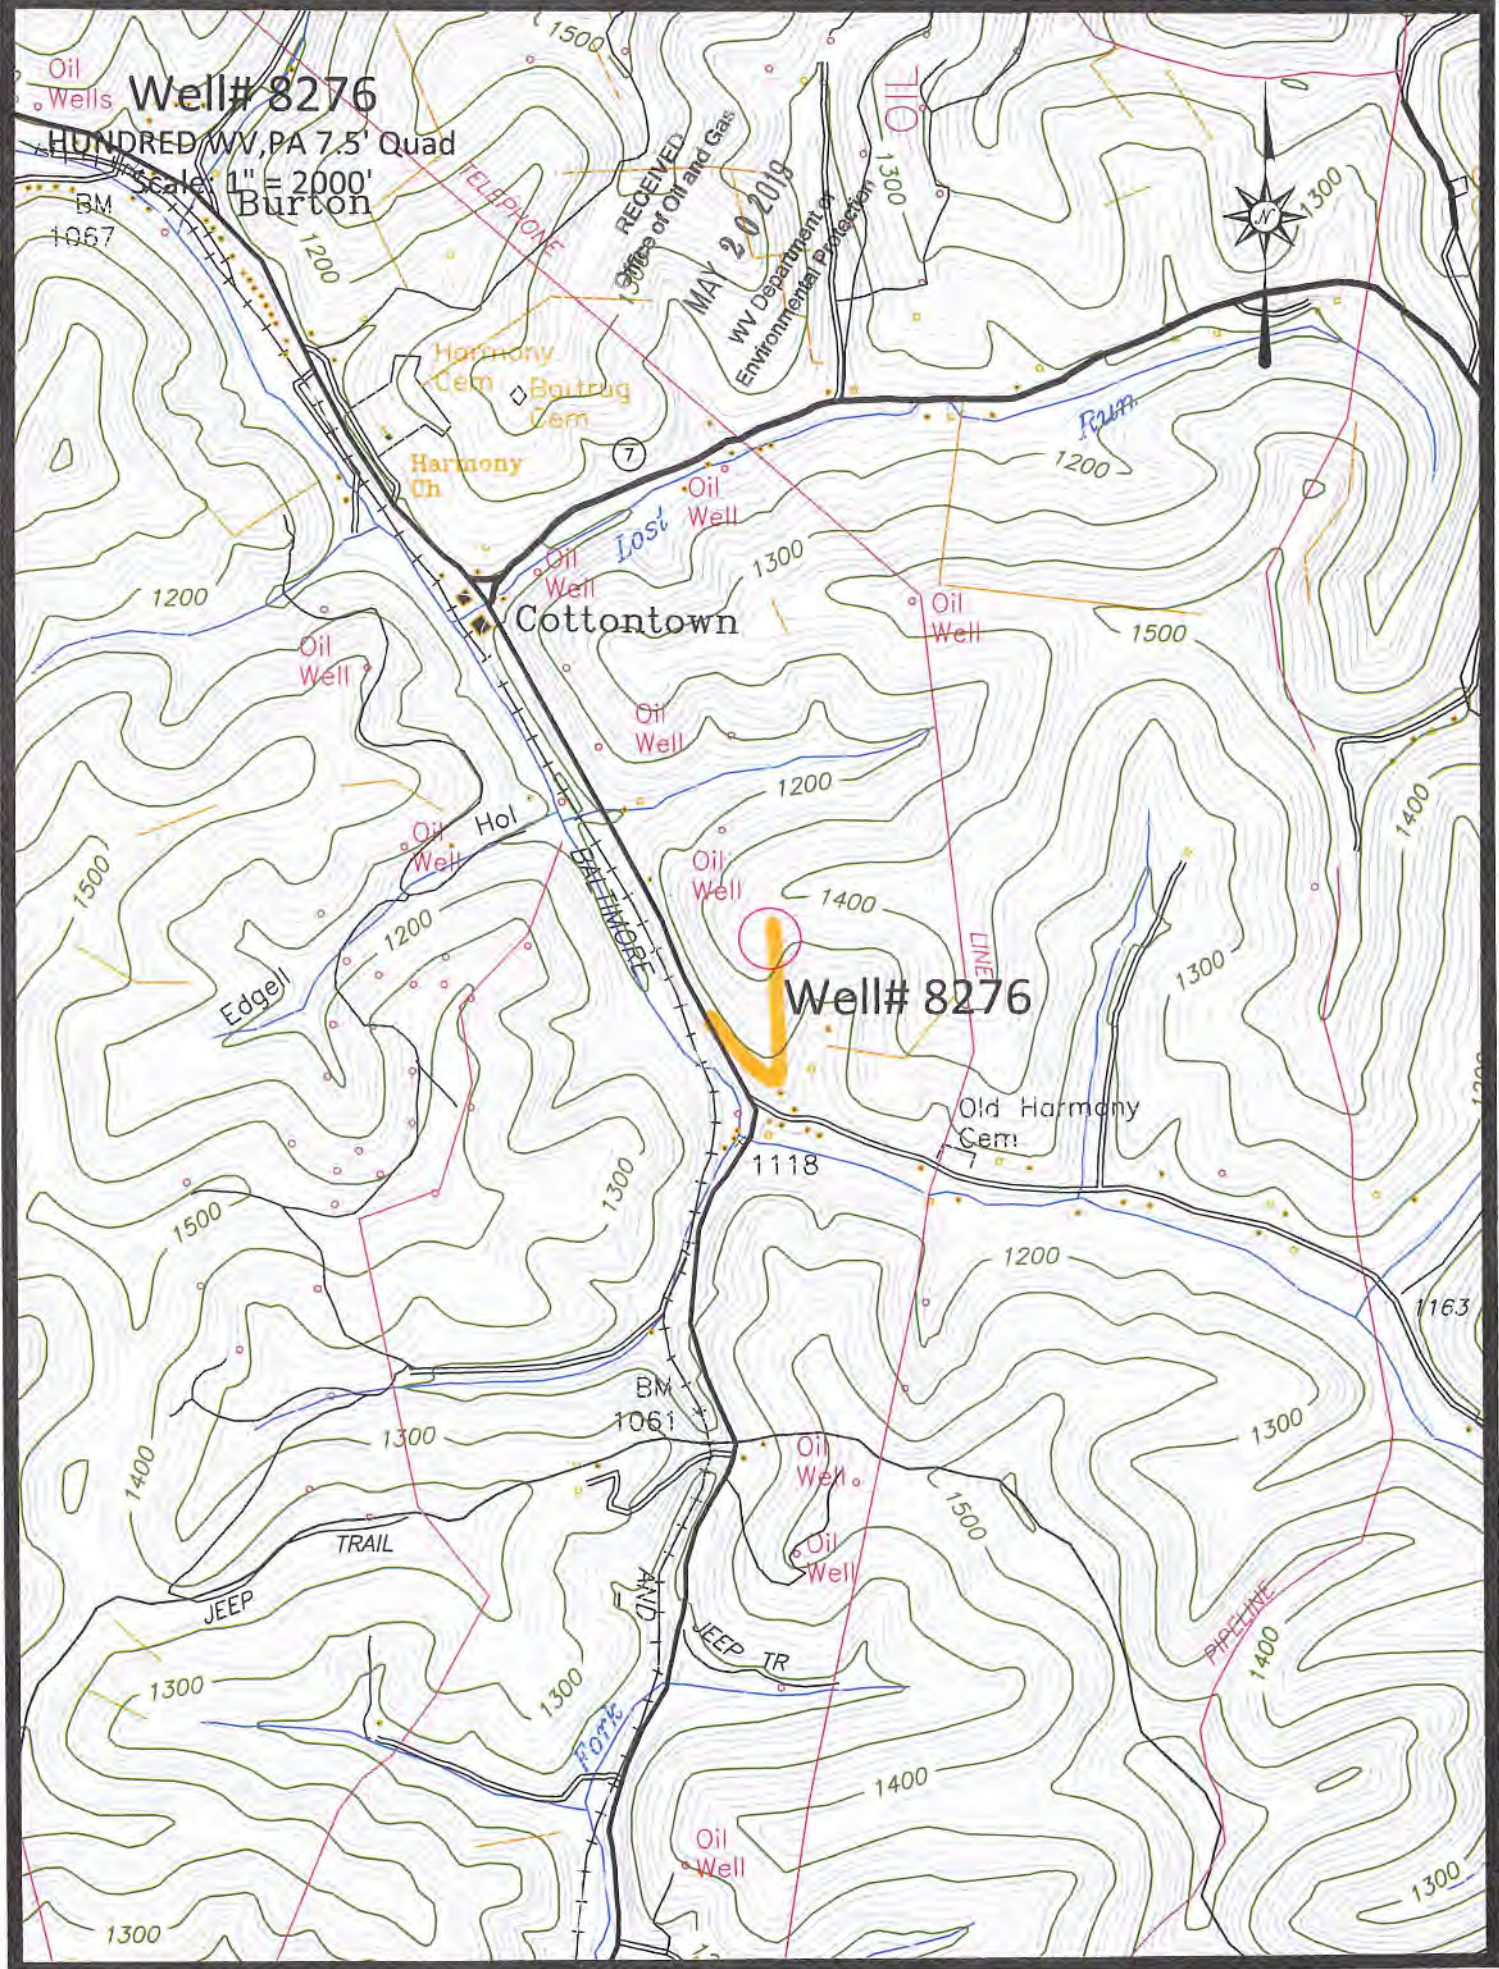

47-103-03318P

Well

Well# 8276

HUNDRED WV, PA 7.5 Quad

Scale: 1" = 500'

RECEIVED
Office of Oil and Gas
MAY 20 2019
WV Department of
Environmental Protection

Oil Well



Oil Well

Oil Well

Well# 8276

LINE

Old Ha
Cem

1118

1300

1200

1400

1200

Hol

BALTIMORE

Area D. 1

