

WW-7
8-30-06



West Virginia Department of Environmental Protection
Office of Oil and Gas

WELL LOCATION FORM: GPS

API: 47-103-70284 WELL NO.: 7192

FARM NAME: J.S. STOUT

RESPONSIBLE PARTY NAME: CONSOLIDATION COAL COMPANY

COUNTY: WETZEL DISTRICT: GRANT

QUADRANGLE: FOLSOM WV 7.5'

SURFACE OWNER: EVERETT & EDITH HAUGHT

ROYALTY OWNER: _____

UTM GPS NORTHING: 4,371,320 m

UTM GPS EASTING: 540,601 m GPS ELEVATION: 355 m (1166')

The Responsible Party named above has chosen to submit GPS coordinates in lieu of preparing a new well location plat for a plugging permit or assigned API number on the above well. The Office of Oil and Gas will not accept GPS coordinates that do not meet the following requirements:

1. Datum: NAD 1983, Zone: 17 North, Coordinate Units: meters, Altitude: height above mean sea level (MSL) – meters.
2. Accuracy to Datum – 3.05 meters
3. Data Collection Method:

Survey grade GPS _____ : Post Processed Differential _____

Real-Time Differential _____

Mapping Grade GPS X : Post Processed Differential X

Real-Time Differential _____

4. **Letter size copy of the topography map showing the well location.**

I the undersigned, hereby certify this data is correct to the best of my knowledge and belief and shows all the information required by law and the regulations issued and prescribed by the Office of Oil and Gas.

[Signature]
Signature

Professional Surveyor
Title

SEPTEMBER 10, 2019
Date

RECEIVED
Office of Oil and Gas

SEP 21 2019

WV Department of
Environmental Protection

47-103-0332P

FOLSOM QUADRANGLE
WEST VIRGINIA
7.5 MINUTE SERIES (TOPOGRAPHIC)
NE/4 CENTER POINT 15' QUADRANGLE

1963 II SW
(GLOVER GAP)

39 32'30" 40 1 710 000 FEET 42 80°30' 39°30'



WELL #7192


RECEIVED
Office of Oil and Gas
4367
SEP 21 2019
WV Department of
Environmental Protection

'Folsom; WV' Scale: 1" = 0.379Mi 610Mt 2,000Ft, 1 Mi = 2.640" , 1 cm = 240Mt

Well# 7192

FOLSOM WV 7.5' Quad

Scale: 1" = 500'

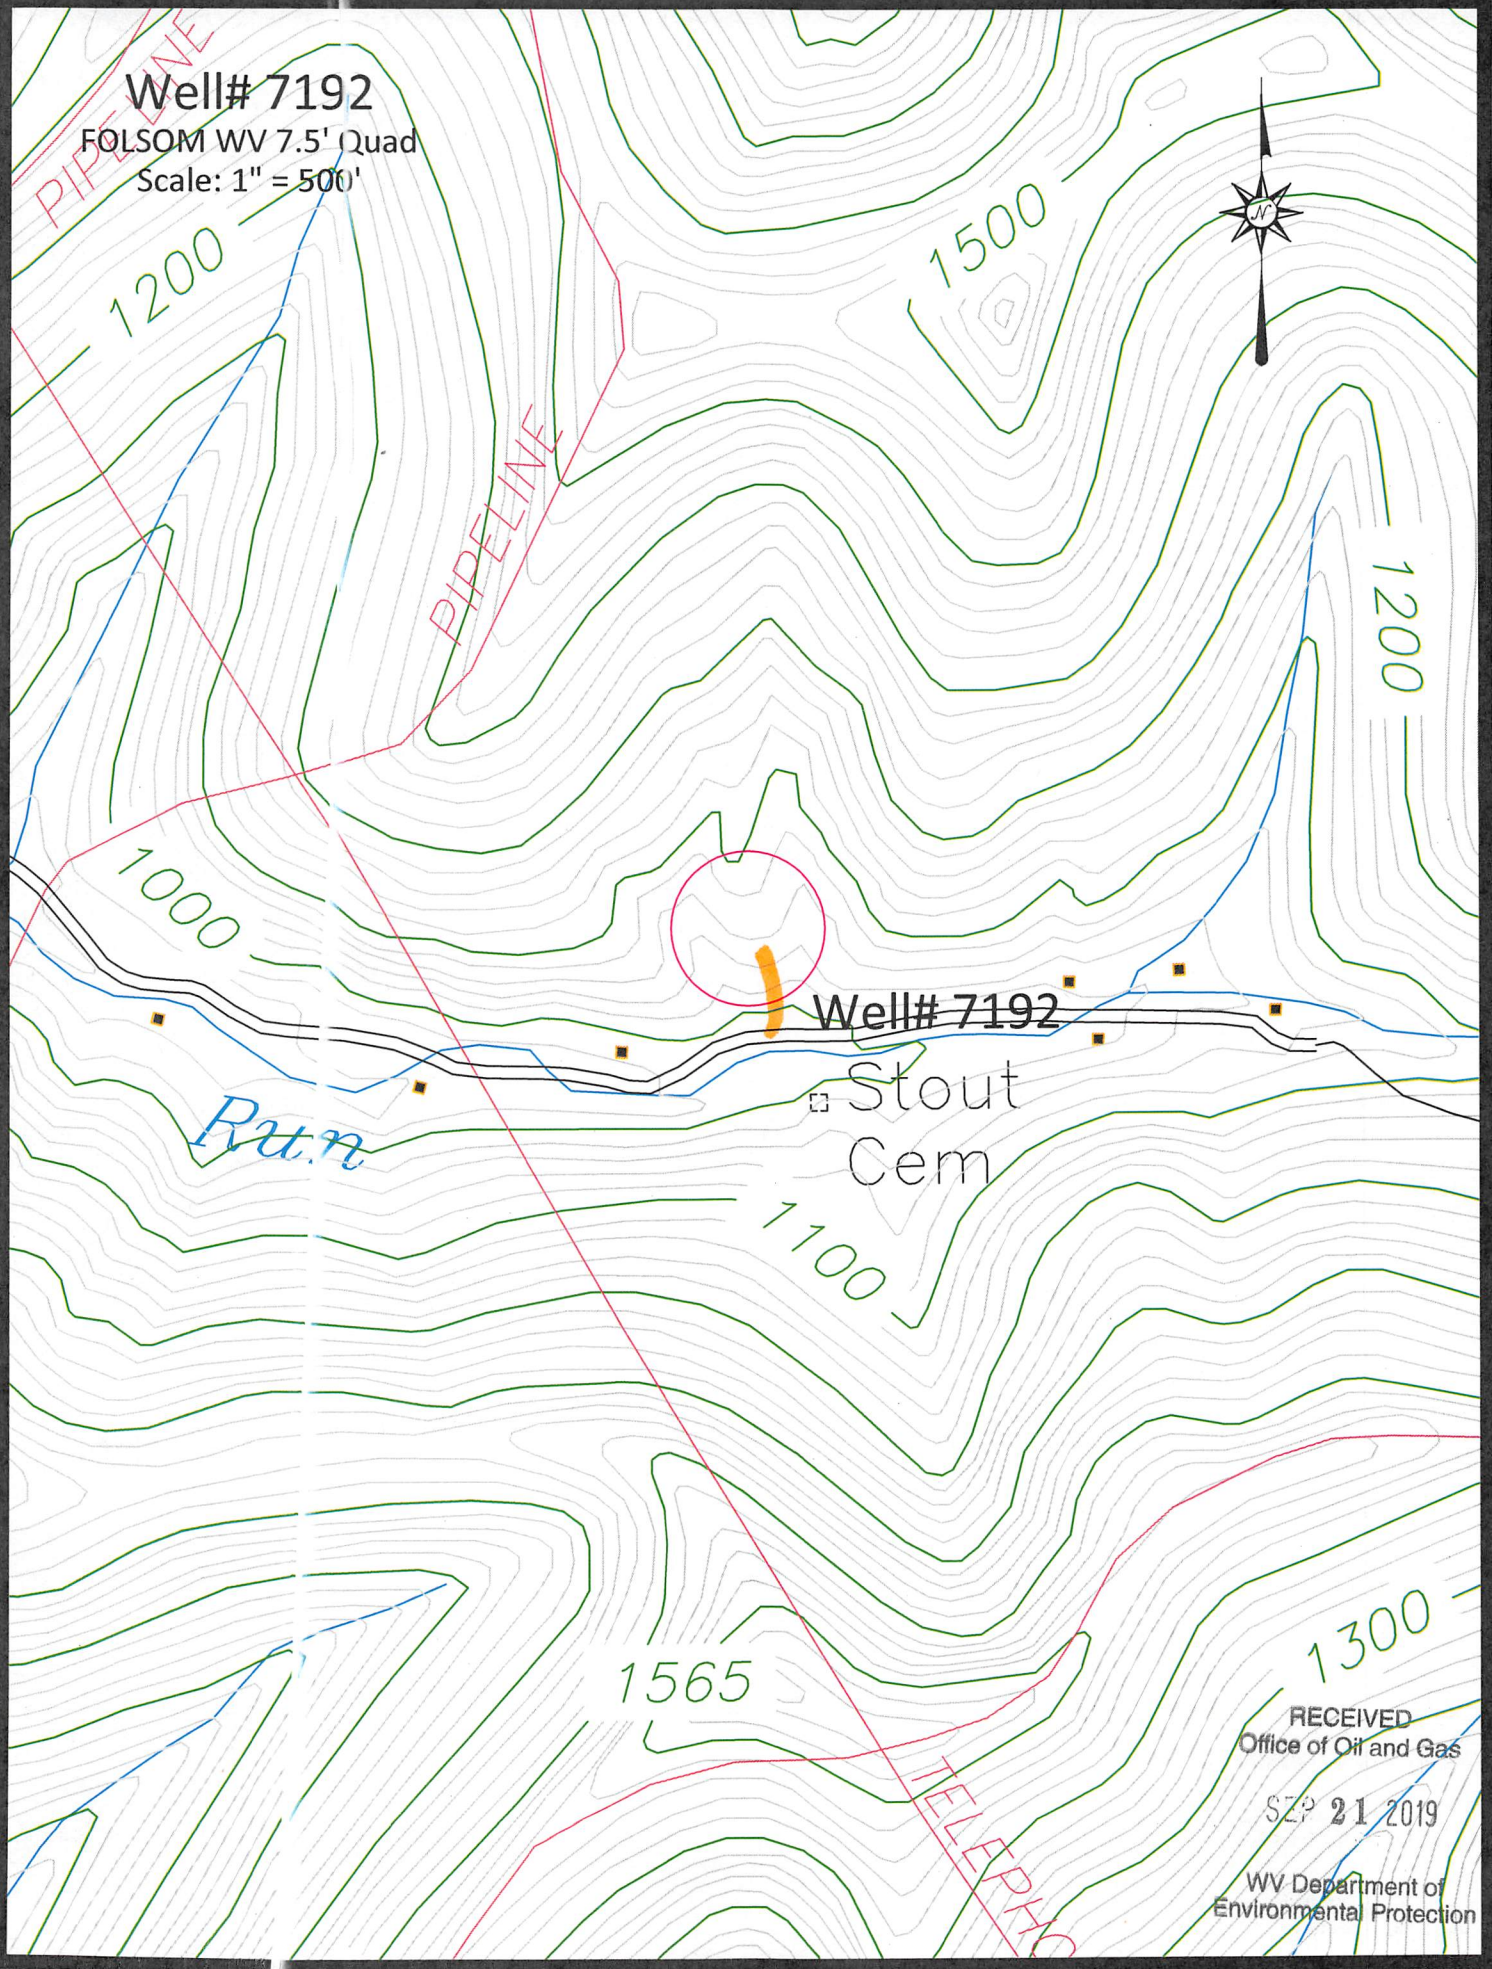


Well# 7192

Stout Cem

Run

Access Road

RECEIVED
Office of Oil and Gas
SEP 21 2019
WV Department of
Environmental Protection

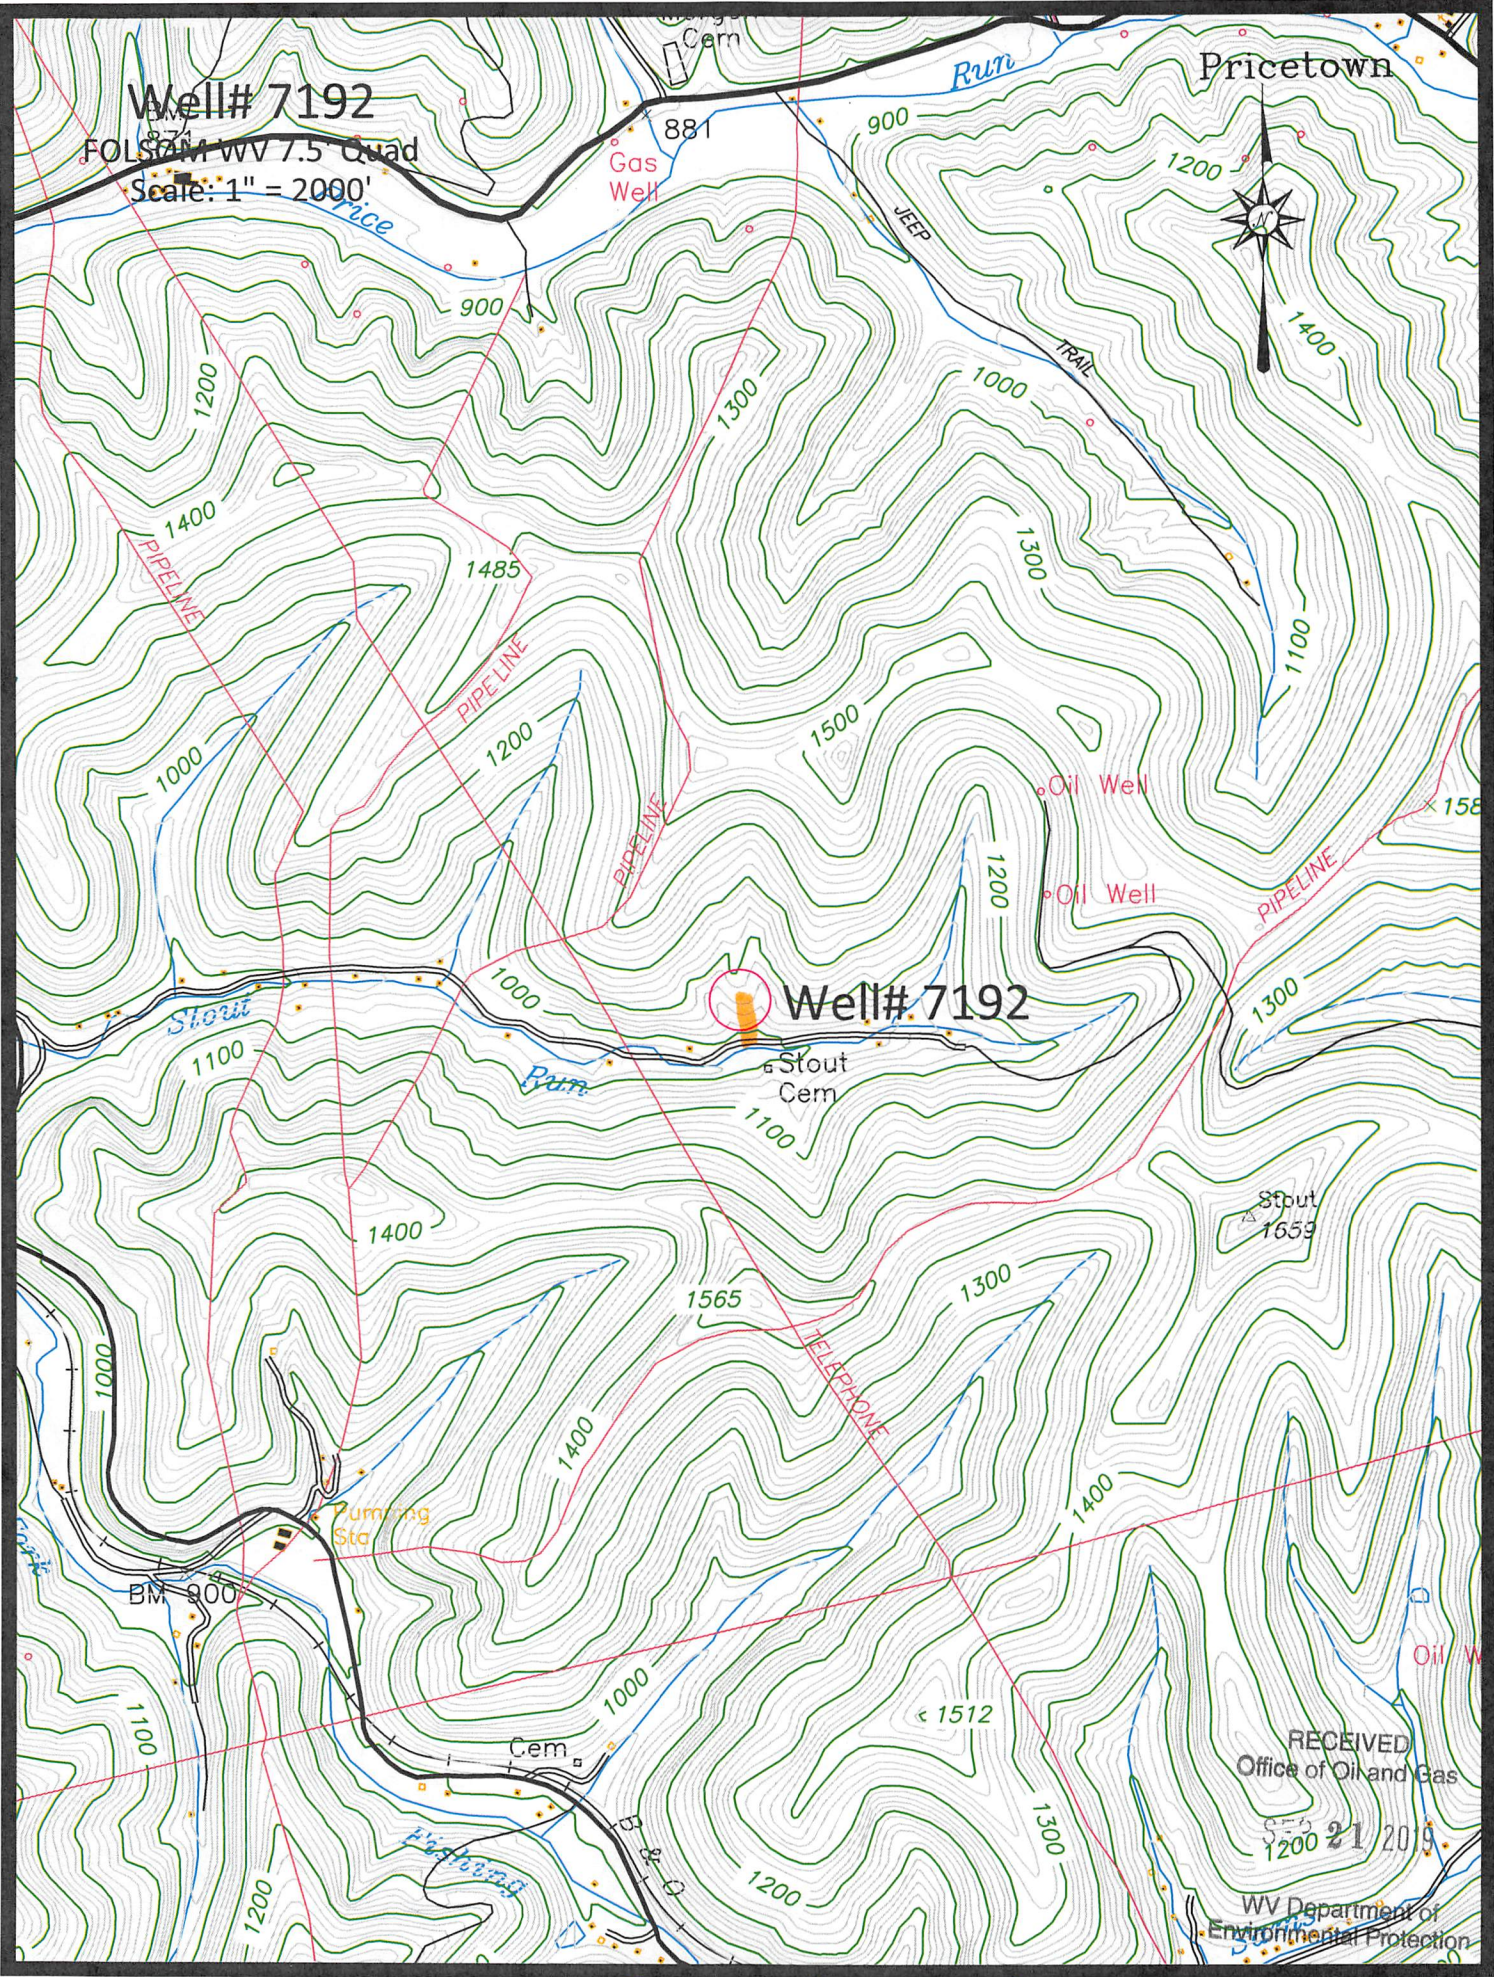

Well# 7192

FOLSOM WV 7.5 Quad

Scale: 1" = 2000'

Pricetown

Gas Well

Well# 7192

Stout Cem

RECEIVED
Office of Oil and Gas

SEP 21 2019

WV Department of
Environmental Protection

Access Road