

4710303464

WW-7
8-30-06



West Virginia Department of Environmental Protection
Office of Oil and Gas

WELL LOCATION FORM: GPS

API: 47-103-73498 WELL NO.: 8195

FARM NAME: E. LITMAN

RESPONSIBLE PARTY NAME: WEST VIRGINIA LAND RESOURCES INC.

COUNTY: WETZEL DISTRICT: CHURCH

QUADRANGLE: HUNDRED W.VA, PA

SURFACE OWNER: WILLIAM E. LEMLEY

ROYALTY OWNER: _____

UTM GPS NORTHING: 4,389,308 m

(1466')

UTM GPS EASTING: 551,055 m GPS ELEVATION: 447 m

The Responsible Party named above has chosen to submit GPS coordinates in lieu of preparing a new well location plat for a plugging permit or assigned API number on the above well. The Office of Oil and Gas will not accept GPS coordinates that do not meet the following requirements:

1. Datum: NAD 1983, Zone: 17 North, Coordinate Units: meters, Altitude: height above mean sea level (MSL) – meters.
2. Accuracy to Datum – 3.05 meters
3. Data Collection Method:

Survey grade GPS _____ : Post Processed Differential _____
 _____ Real-Time Differential _____
 Mapping Grade GPS : Post Processed Differential
 _____ Real-Time Differential _____

RECEIVED
Office of Oil and Gas
SEP 28 2021
WV Department of
Environmental Protection

4. Letter size copy of the topography map showing the well location.

I the undersigned, hereby certify this data is correct to the best of my knowledge and belief and shows all the information required by law and the regulations issued and prescribed by the Office of Oil and Gas.

Signature

Professional Surveyor

Title

AUGUST 24, 2021

Date

10/29/2021

4710303464P



40
39

38

37

36

35

RECEIVED
Office of Oil and Gas
SEP 28 2021
WV Department of
Environmental Protection

1:250,000 FEET (PA) 151

INTERIOR GEODESIC SURVEY, BOSTON, VIRGINIA - 1977

80°22'30"



ROAD CLASSIFICATION

- Heavy duty ————
- Medium duty ————
- Light-duty ————
- Unimproved dirt ————
- U. S. Route
- State Route

MANNINGTON 35 283 11 SE


HUNDRED, W. VA.—PA. 10/29/2021

NW/4 MANNINGTON 15' QUADRANGLE
N3937.5—W8022.5/7.5

Well# 8195

HUNDRED WV, PA 7.5' Quad

Scale: 1" = 2000'

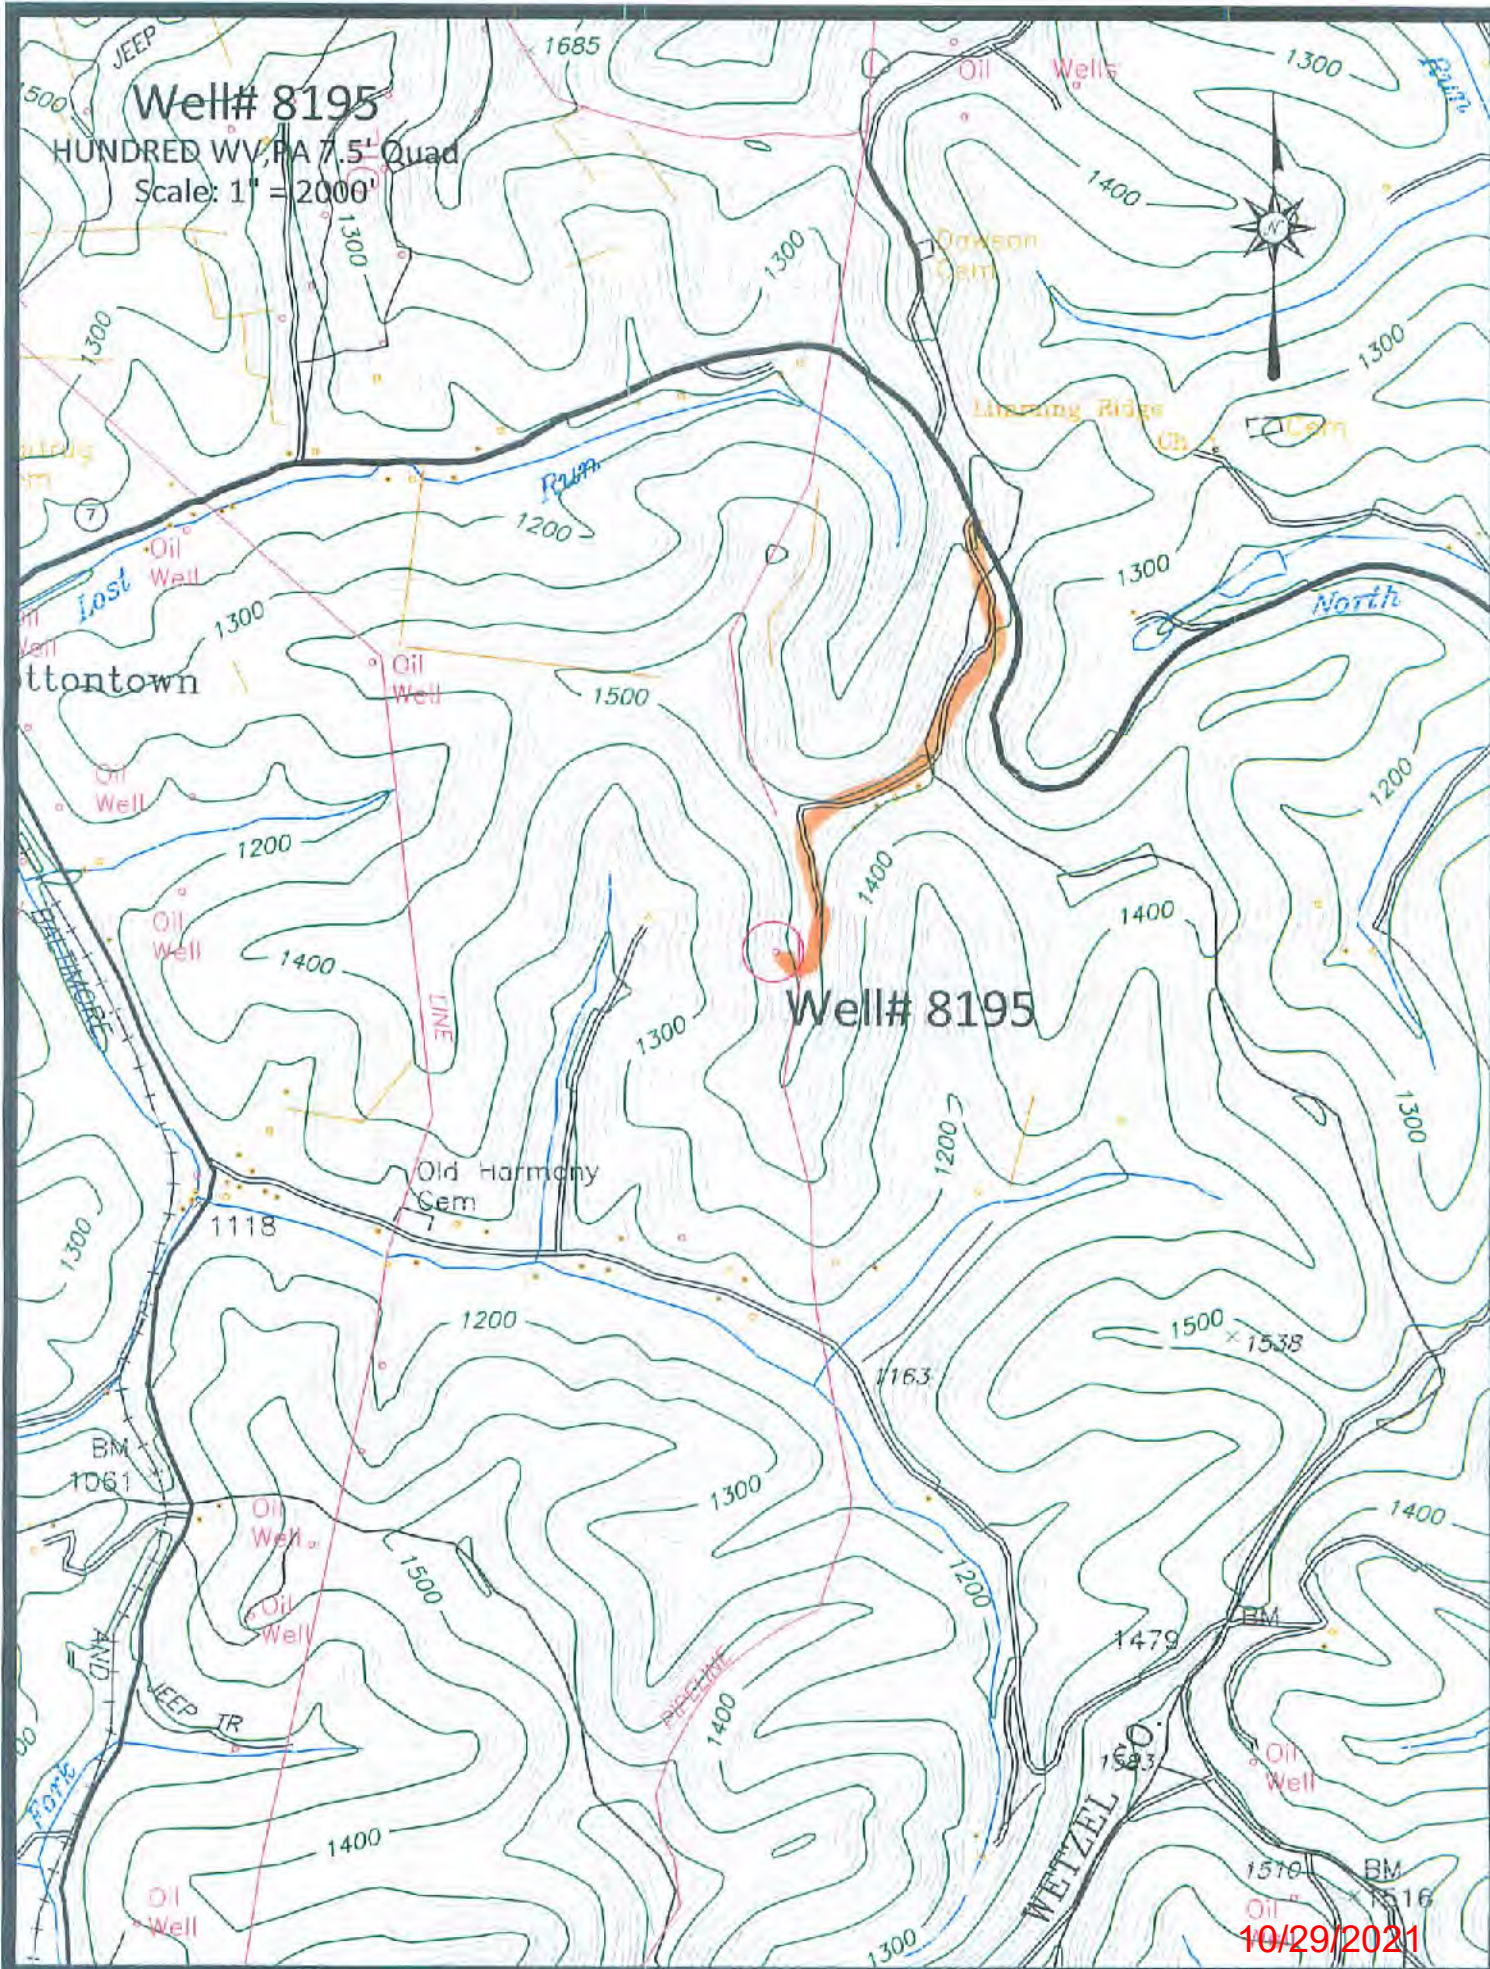

Well# 8195

Access Road

10/29/2021

Well# 8195

HUNDRED WV, PA 7.5' Quad

Scale: 1" = 500'



1500

1400

1300

1200

Well# 8195

Harmony

200

10/29/2021

— Access Road

