



west virginia department of environmental protection

Office of Oil and Gas
601 57th Street, S.E.
Charleston, WV 25304
(304) 926-0450
fax: (304) 926-0452

Harold D. Ward, Cabinet Secretary
www.dep.wv.gov

Wednesday, October 11, 2023
PERMIT MODIFICATION APPROVAL
Horizontal 6A / New Drill

EQT PRODUCTION COMPANY
400 WOODLIFF DR.

CANONSBURG, PA 15317

Re: Permit Modification Approval for Haggard 4H
47-103-03527-00-00

Adding an AST to the pad

EQT PRODUCTION COMPANY

The Office of Oil and Gas has reviewed the attached permit modification for the above referenced permit. The attached modification has been approved and well work may begin. Please be reminded that the oil and gas inspector is to be notified twenty-four (24) hours before permitted well work is commenced.

If there are any questions, please feel free to contact me at (304) 926- 0450.




James A. Martin
Chief

Operator's Well Number: Haggard 4H
Farm Name: Amie Lee Henderson
U.S. WELL NUMBER: 47-103-03527-00-00
Horizontal 6A New Drill
Date Modification Issued: 10/11/2023

Promoting a healthy environment.

10/13/2023

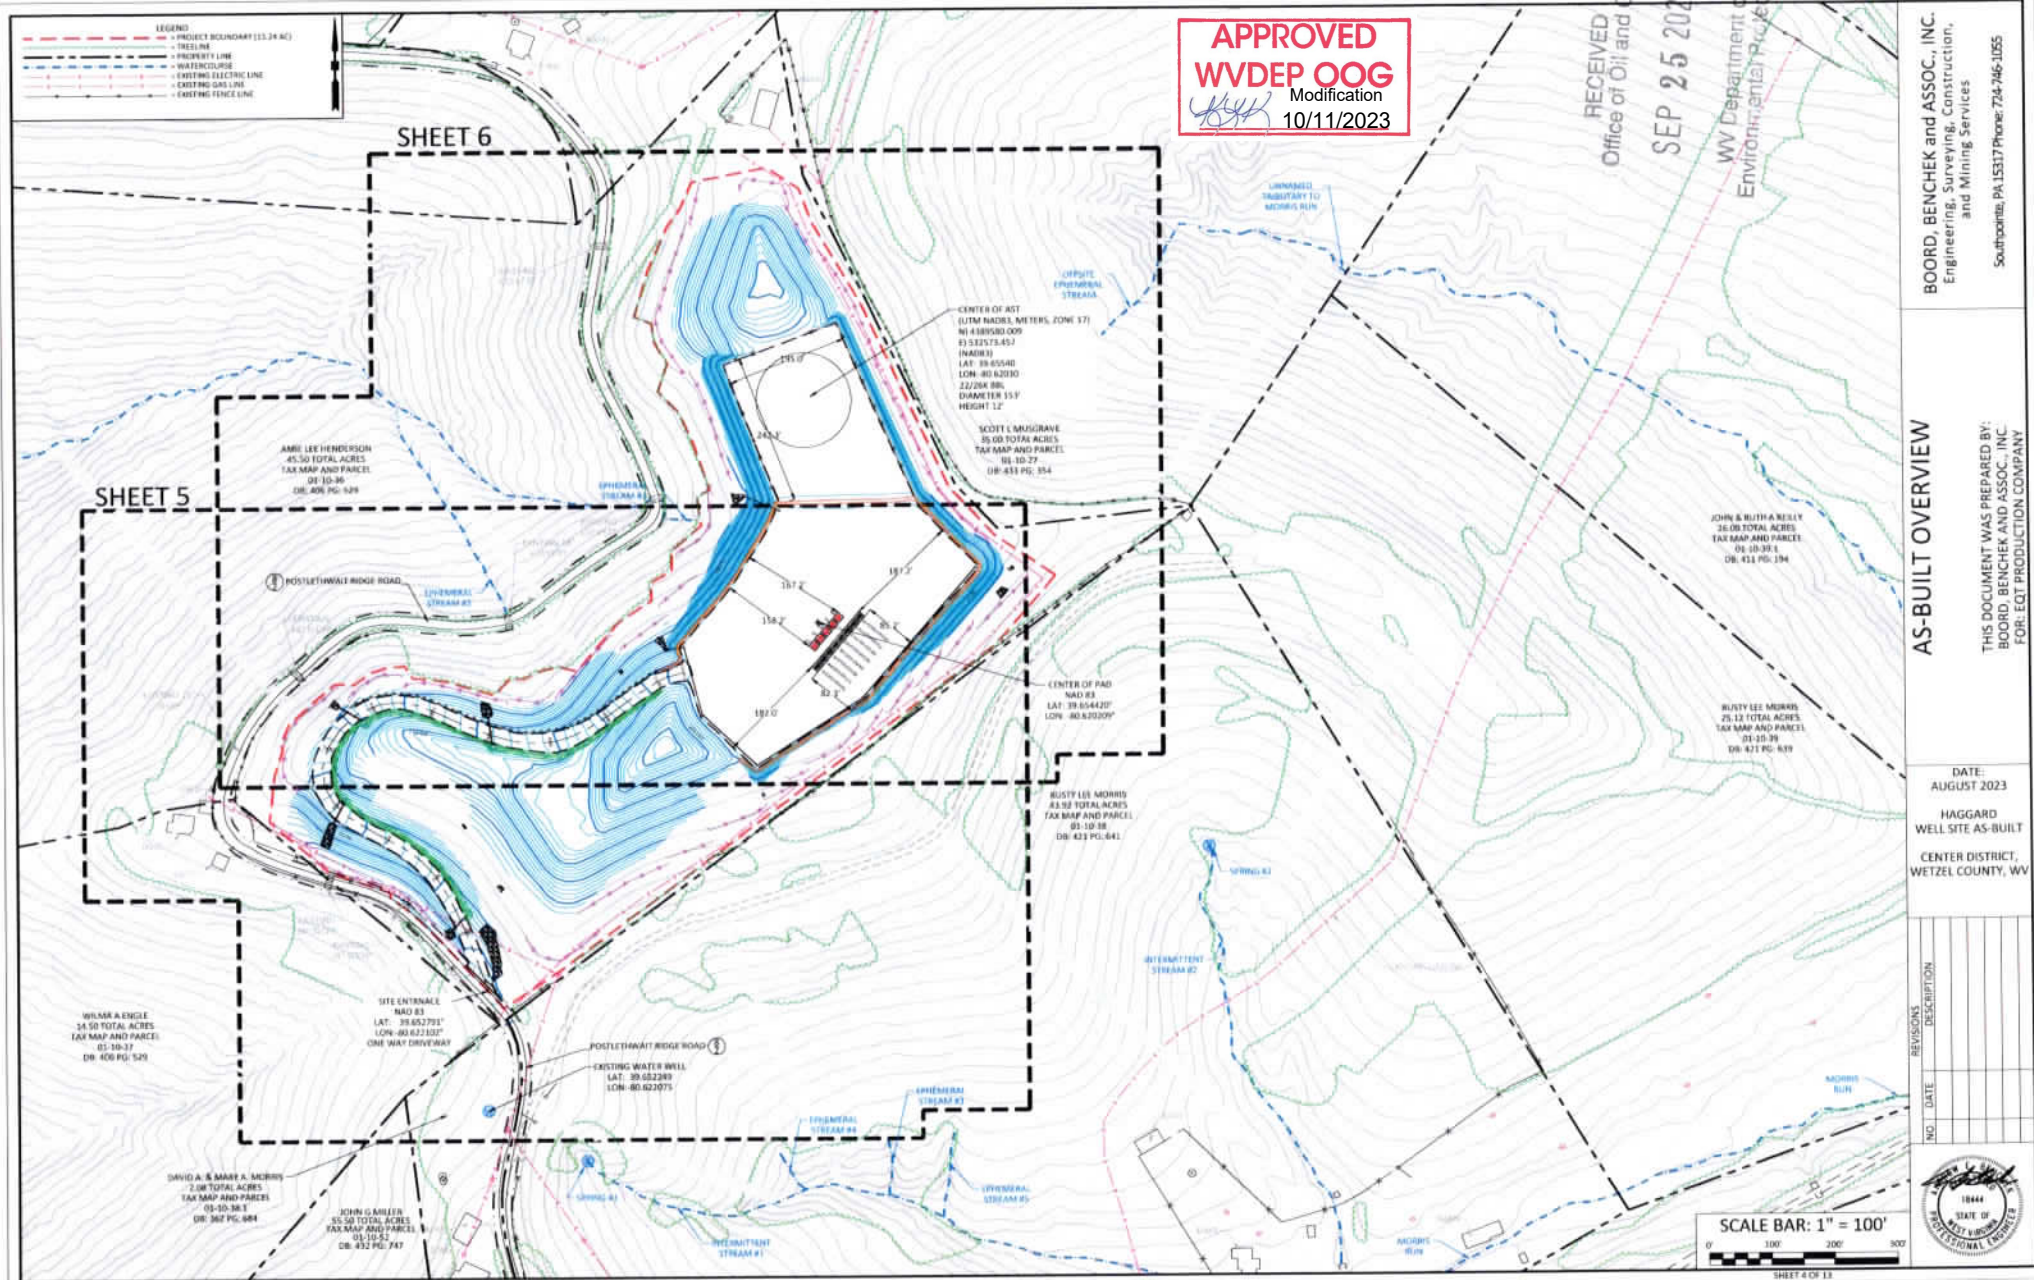

BOORD, BENCHEK and ASSOC., INC.
 Engineering, Surveying, Construction,
 and Mining Services
 Southpointe, PA 15317 Phone: 724-746-1055

AS-BUILT OVERVIEW

THIS DOCUMENT WAS PREPARED BY:
BOORD, BENCHEK and ASSOC., INC.
 FOR: EQT PRODUCTION COMPANY

DATE:
 AUGUST 2023
 HAGGARD
 WELL SITE AS-BUILT
 CENTER DISTRICT,
 WETZEL COUNTY, WV

REVISIONS	
NO.	DESCRIPTION



SCALE BAR: 1" = 100'
 0 100 200 300
 SHEET 4 OF 13

Stephen Mccoy Digitally signed by Stephen Mccoy
 Date: 2023.08.11 14:15:47 -0400