


Haggard 10H
Haggard
EQT Production Company

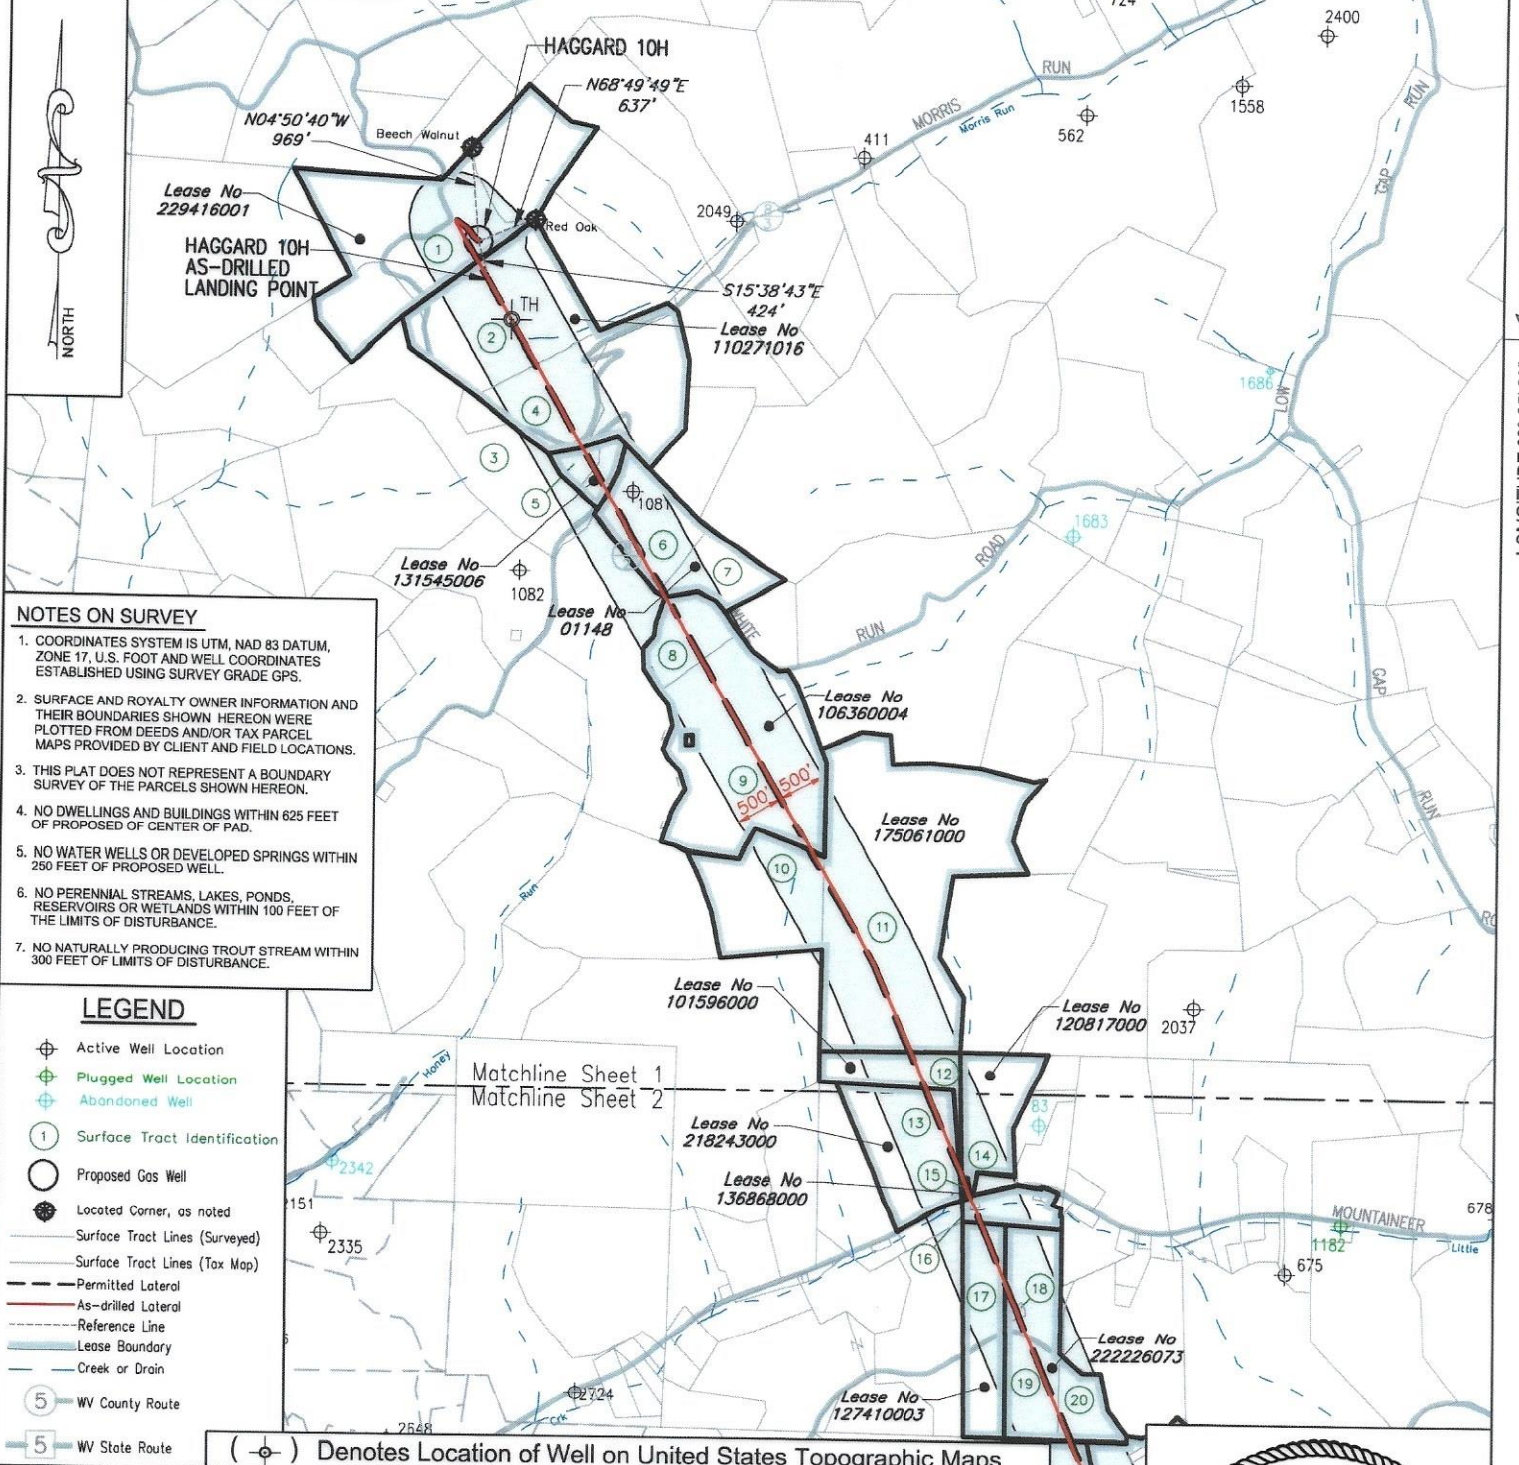

NOTES ON SURVEY

- COORDINATES SYSTEM IS UTM, NAD 83 DATUM, ZONE 17. U.S. FOOT AND WELL COORDINATES ESTABLISHED USING SURVEY GRADE GPS.
- SURFACE AND ROYALTY OWNER INFORMATION AND THEIR BOUNDARIES SHOWN HEREON WERE PLOTTED FROM DEEDS AND/OR TAX PARCEL MAPS PROVIDED BY CLIENT AND FIELD LOCATIONS.
- THIS PLAT DOES NOT REPRESENT A BOUNDARY SURVEY OF THE PARCELS SHOWN HEREON.
- NO DWELLINGS AND BUILDINGS WITHIN 625 FEET OF PROPOSED OF CENTER OF PAD.
- NO WATER WELLS OR DEVELOPED SPRINGS WITHIN 250 FEET OF PROPOSED WELL.
- NO PERENNIAL STREAMS, LAKES, PONDS, RESERVOIRS OR WETLANDS WITHIN 100 FEET OF THE LIMITS OF DISTURBANCE.
- NO NATURALLY PRODUCING TROUT STREAM WITHIN 300 FEET OF LIMITS OF DISTURBANCE.

- LEGEND**
- ⊕ Active Well Location
 - ⊕ Plugged Well Location
 - ⊕ Abandoned Well
 - ① Surface Tract Identification
 - Proposed Gas Well
 - Located Corner, as noted
 - Surface Tract Lines (Surveyed)
 - Surface Tract Lines (Tax Map)
 - - - Permitted Lateral
 - - - As-drilled Lateral
 - - - Reference Line
 - Lease Boundary
 - Creek or Drain
 - ⑤ WV County Route
 - ⑤ WV State Route

Matchline Sheet 1
Matchline Sheet 2

(⊕) Denotes Location of Well on United States Topographic Maps



I, the undersigned, hereby certify that this plat is correct to the best of my knowledge and belief and shows all the information required by law and the regulations issued and prescribed by the Department of Environmental Protection.

L. L. S. 2394
L. L. S. 2394



FILE NO:
DRAWING NO:
SCALE: 1" = 2000'
MINIMUM DEGREE OF ACCURACY: 1:2500
PROVEN SOURCE OF ELEVATION: NGS CORS Station



DATE: NOVEMBER 20 20 23
OPERATORS WELL NO: Haggard 10H
API WELL NO
47 - 103 - 03529
STATE COUNTY PERMIT

WELL TYPE: OIL GAS LIQUID INJECTION WASTE DISPOSAL
(IF GAS) PRODUCTION: STORAGE DEEP SHALLOW
LOCATION ELEVATION: 1519' WATERSHED: LOWER WEST VIRGINIA FORK FISH CREEK QUADRANGLE: LITTLETON
DISTRICT: Center COUNTY: Wetzel
SURFACE OWNER: Amie Lee Henderson ACREAGE: 84.94 ±
ROYALTY OWNER: Blackrock Enterprises LLC, et al. LEASE NO: 229416001 ACREAGE: 84.94 ±
PROPOSED WORK: DRILL CONVERT DRILL DEEPER FRACTURE OR STIMULATE PLUG OFF OLD FORMATION
 PERFORATE NEW FORMATION OTHER PHYSICAL CHANGE IN WELL (SPECIFY)
 PLUG AND ABANDON CLEAN OUT AND REPLUG TARGET FORMATION: Marcellus ESTIMATED DEPTH: 7,614'
WELL OPERATOR: EQT Production Company DESIGNATED AGENT: Joseph C Mallow
ADDRESS: 400 Woodcliff Drive ADDRESS: 427 Midstate Drive
Canonsburg, PA 15317 Clarksburg, WV 26301

AS-DRILLED

Haggard 10H
Haggard
EQT Production Company



Lease No 131545006

Lease No 01148

Lease No 106360004

Lease No 175061000

Lease No 101596000

Lease No 120817000

Lease No 218243000

Lease No 136868000

Lease No 222226073

Lease No 127410003

Lease No 102304002

Lease No 102282019

Lease No 127057000

Lease No 126508000

3073
3072
3070

2977
2978
2974

Matchline Sheet 1
Matchline Sheet 2

HAGGARD 10H
AS-DRILLED
BOTTOM HOLE

- NOTES ON SURVEY**
- COORDINATES SYSTEM IS UTM, NAD 83 DATUM, ZONE 17, U.S. FOOT AND WELL COORDINATES ESTABLISHED USING SURVEY GRADE GPS.
 - SURFACE AND ROYALTY OWNER INFORMATION AND THEIR BOUNDARIES SHOWN HEREON WERE PLOTTED FROM DEEDS AND/OR TAX PARCEL MAPS PROVIDED BY CLIENT AND FIELD LOCATIONS.
 - THIS PLAT DOES NOT REPRESENT A BOUNDARY SURVEY OF THE PARCELS SHOWN HEREON.
 - NO DWELLINGS AND BUILDINGS WITHIN 625 FEET OF PROPOSED OF CENTER OF PAD.
 - NO WATER WELLS OR DEVELOPED SPRINGS WITHIN 250 FEET OF PROPOSED WELL.
 - NO PERENNIAL STREAMS, LAKES, PONDS, RESERVOIRS OR WETLANDS WITHIN 100 FEET OF THE LIMITS OF DISTURBANCE.
 - NO NATURALLY PRODUCING TROUT STREAM WITHIN 300 FEET OF LIMITS OF DISTURBANCE.

LEGEND

- Active Well Location
- Plugged Well Location
- Abandoned Well
- Surface Tract Identification
- Proposed Gas Well
- Located Corner, as noted
- Surface Tract Lines (Surveyed)
- Surface Tract Lines (Tax Map)
- Permitted Lateral
- As-drilled Lateral
- Reference Line
- Lease Boundary
- Creek or Drain
- WV County Route
- WV State Route

(-) Denotes Location of Well on United States Topographic Maps



I, the undersigned, hereby certify that this plat is correct to the best of my knowledge and belief and shows all the information required by law and the regulations issued and prescribed by the Department of Environmental Protection.

L. S. Rowe
L. L. S. 2394



FILE NO: _____
 DRAWING NO: _____
 SCALE: 1" = 2000'
 MINIMUM DEGREE OF ACCURACY: 1:2500
 PROVEN SOURCE OF ELEVATION: NGS CORS Station




DATE: NOVEMBER 20 20 23
 OPERATORS WELL NO: Haggard 10H
 API WELL NO
 47 - 103 - 03529
 STATE COUNTY PERMIT

WELL TYPE: OIL GAS LIQUID INJECTION WASTE DISPOSAL
 (IF GAS) PRODUCTION: STORAGE DEEP SHALLOW
 LOCATION ELEVATION: 1519' WATERSHED: LOWER WEST VIRGINIA FORK FISH CREEK QUADRANGLE: LITTLETON
 DISTRICT: Center COUNTY: Wetzel
 SURFACE OWNER: Amie Lee Henderson ACREAGE: 84.94 ±
 ROYALTY OWNER: Blackrock Enterprises LLC, et al. LEASE NO: 229416001 ACREAGE: 84.94 ±
 PROPOSED WORK: DRILL CONVERT DRILL DEEPER FRACTURE OR STIMULATE PLUG OFF OLD FORMATION
 PERFORATE NEW FORMATION OTHER PHYSICAL CHANGE IN WELL (SPECIFY)
 PLUG AND ABANDON CLEAN OUT AND REPLUG TARGET FORMATION: Marcellus ESTIMATED DEPTH: 7,614'
 WELL OPERATOR: EQT Production Company DESIGNATED AGENT: Joseph C Mallow
 ADDRESS: 400 Woodcliff Drive ADDRESS: 427 Midstate Drive
 Canonsburg, PA 15317 Clarksburg, WV 26301


AS-DRILLED

Haggard 10H
Haggard
EQT Production Company


Tract ID	Tax Map No.	Parcel No.	County	District	Surface Tract Owner	Acres
1	10	36.0	Wetzel	Center	Amie Lee Henderson	45.50
2	10	38.0	Wetzel	Center	Rusty Lee Morris	43.92
3	10	52.0	Wetzel	Center	John G. Miller ET AL	55.50
4	10	53.0	Wetzel	Center	Rusty Lee Morris	22.02
5	10	52.1	Wetzel	Center	Rusty Lee Morris	3.48
6	14	8.0	Wetzel	Center	Arthur R. Miller	20.86
7	14	19.1	Wetzel	Center	Bennett & Bradley Postlethwait	22.39
8	14	9.0	Wetzel	Center	Janice L. Whipkey ET AL	12.56
9	14	19.0	Wetzel	Center	Bennett Eugene & Bradley Curtis Postlethwait	132.68
10	14	32.0	Wetzel	Center	Kenneth R. & Jennifer L. Mason	31.19
11	14	33.0	Wetzel	Center	Dennis L. Hickie ET AL	144.00
12	14	43.0	Wetzel	Center	Dennis L. Hickie ET AL	12.63
13	14	52.0	Wetzel	Center	Lonnice H. Kirkpatrick Jr. ET AL	29.52
14	15	52.0	Wetzel	Center	Sharon M. Dulaney ET AL	25.95
15	15	52.4	Wetzel	Center	Joe Ronnie & Sharon Dulaney	0.50
16	15	50.0	Wetzel	Center	Church of Christ	0.39
17	2	1.0	Wetzel	Grant	George HRS. & Robert L. Yoho	47.49
18	19	1.1	Wetzel	Center	Cross Yoho Cemetery	0.43
19	19	1.0	Wetzel	Center	Michael Corey Dulaney	44.57
20	19	11.0	Wetzel	Center	Dale K. & Sherry L. Dulaney	10.00
21	2	4.0	Wetzel	Grant	John C. & Debbie D. Comer	104.00
22	3	5.0	Wetzel	Grant	Coastal Forest Resources Co.	179.00

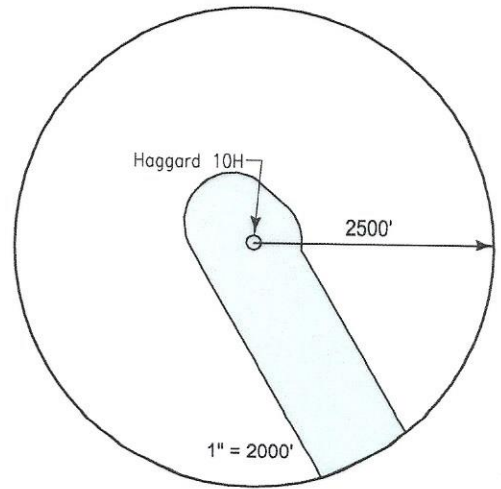

Lease	Owner	Acres
229416001	Blackrock Enterprises LLC, et al.	84.94 ac of 198.1275 ac
110271016	Vivian Rine, aka Vivian L. Rine, et al.	95.7 ac
131545006	Earnest H. Cadle, et al.	10.33 ac
01148	First United Methodist Church of New Martinsville, et al.	41.25 ac
106360004	Shiben Estates, Inc., et al.	80 ac
175061000	OXY USA, Inc., et al.	31.19 ac and 144 ac of 31,151.581 ac
101596000	Piney Holdings, Inc., et al.	12.625 ac
218243000	Hundred Resources, Inc.	29.52 ac
136868000	Ronnie Joe Dulaney and Sharon Maxine Dulaney	0.50156 ac
120817000	Raymond Lee Yoho, et al.	27.075 ac
127410003	The Joseph F. Blake and Gay K. Blake Irrevocable Grantor Trust Dated May 30, 2013, et al.	23 ac
222226073	Verlin Edsel O'Neal and Ida Vaughn O'Neal Living Trust U/A/D April 12, 2000, et al.	38.50 ac
102282019	The Joseph F. Blake and Gay K. Blake Irrevocable Grantor Trust Dated May 30, 2013, et al.	104 ac
102504002	The Joseph F. Blake and Gay K. Blake Irrevocable Grantor Trust Dated May 30, 2013, et al.	60.06 ac
126508000	J&N Management Enterprises, LLC, et al.	332 ac

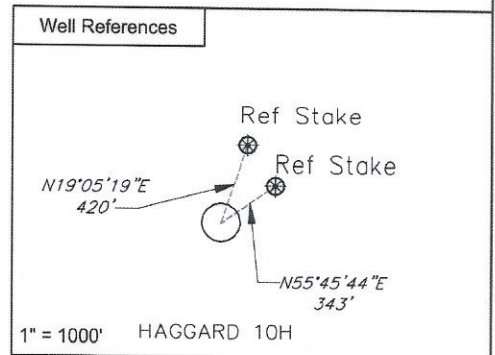

Notes:
HAGGARD 10H coordinates are
 NAD 27 N: 422,377.419 E: 1,684,584.541
 NAD 27 Lat: 39.654270 Long: -80.620265
 NAD 83 UTM N: 4,389,463.724 E: 532,593.162
HAGGARD 10H Landing Point coordinates are
 NAD 27 N: 421,968.660 E: 1,684,699.030
 NAD 27 Lat: 39.653152 Long: -80.619841
 NAD 83 UTM N: 4,389,339.775 E: 532,630.117
HAGGARD 10H Bottom Hole coordinates are
 NAD 27 N: 406,373.660 E: 1,692,414.520
 NAD 27 Lat: 39.610600 Long: -80.591768
 NAD 83 UTM N: 4,384,627.897 E: 535,059.901
 West Virginia Coordinates system of 1927 (North Zone)
 based upon Differential GPS Measurements
 Plat orientation, Corner and well ties are based upon
 the grid north meridian
 Well location references are based upon the grid north
 meridian.
 UTM coordinates are NAD83, Zone 17, Meters.

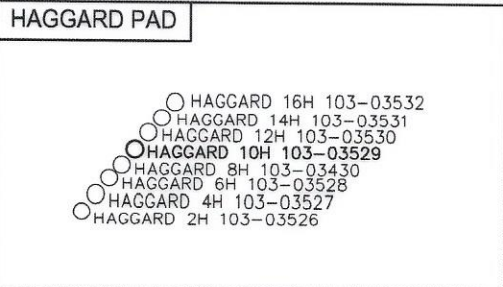

I, the undersigned, hereby certify that this plat is correct to the best of my knowledge and belief and shows all the information required by law and the regulations issued and prescribed by the Department of Environmental Protection.

L. L. S. 2394
 L. L. S. 2394



FILE NO: _____
 DRAWING NO: _____
 SCALE: 1" = 1000'
 MINIMUM DEGREE OF ACCURACY:
 1:2500
 PROVEN SOURCE OF ELEVATION:
 NGS CORS Station



DATE: NOVEMBER 20 20 23
 OPERATORS WELL NO: Haggard 10H
 API WELL NO
 47 - 103 - 03529
 STATE COUNTY PERMIT

WELL TYPE: OIL GAS LIQUID INJECTION WASTE DISPOSAL
 (IF GAS) PRODUCTION: STORAGE DEEP SHALLOW
 LOCATION ELEVATION: 1519' WATERSHED: LOWER WEST VIRGINIA FORK FISH CREEK QUADRANGLE: LITTLETON
 DISTRICT: Center COUNTY: Wetzel
 SURFACE OWNER: Amie Lee Henderson ACREAGE: 45.51
 ROYALTY OWNER: Blackrock Enterprises LLC, et al. LEASE NO: 229416001 ACREAGE: 84.94 ±
 PROPOSED WORK: DRILL CONVERT DRILL DEEPER FRACTURE OR STIMULATE PLUG OFF OLD FORMATION
 PERFORATE NEW FORMATION OTHER PHYSICAL CHANGE IN WELL (SPECIFY)
 PLUG AND ABANDON CLEAN OUT AND REPLUG TARGET FORMATION: Marcellus ESTIMATED DEPTH: 7,614'
 WELL OPERATOR: EQT Production Company DESIGNATED AGENT: Joseph C Mallow
 ADDRESS: 400 Woodcliff Drive ADDRESS: 427 Midstate Drive
 Canonsburg, PA 15317 Clarksburg, WV 26301

08/16/2024