


Orange R 1

SM


2710303560P
02/24/2023

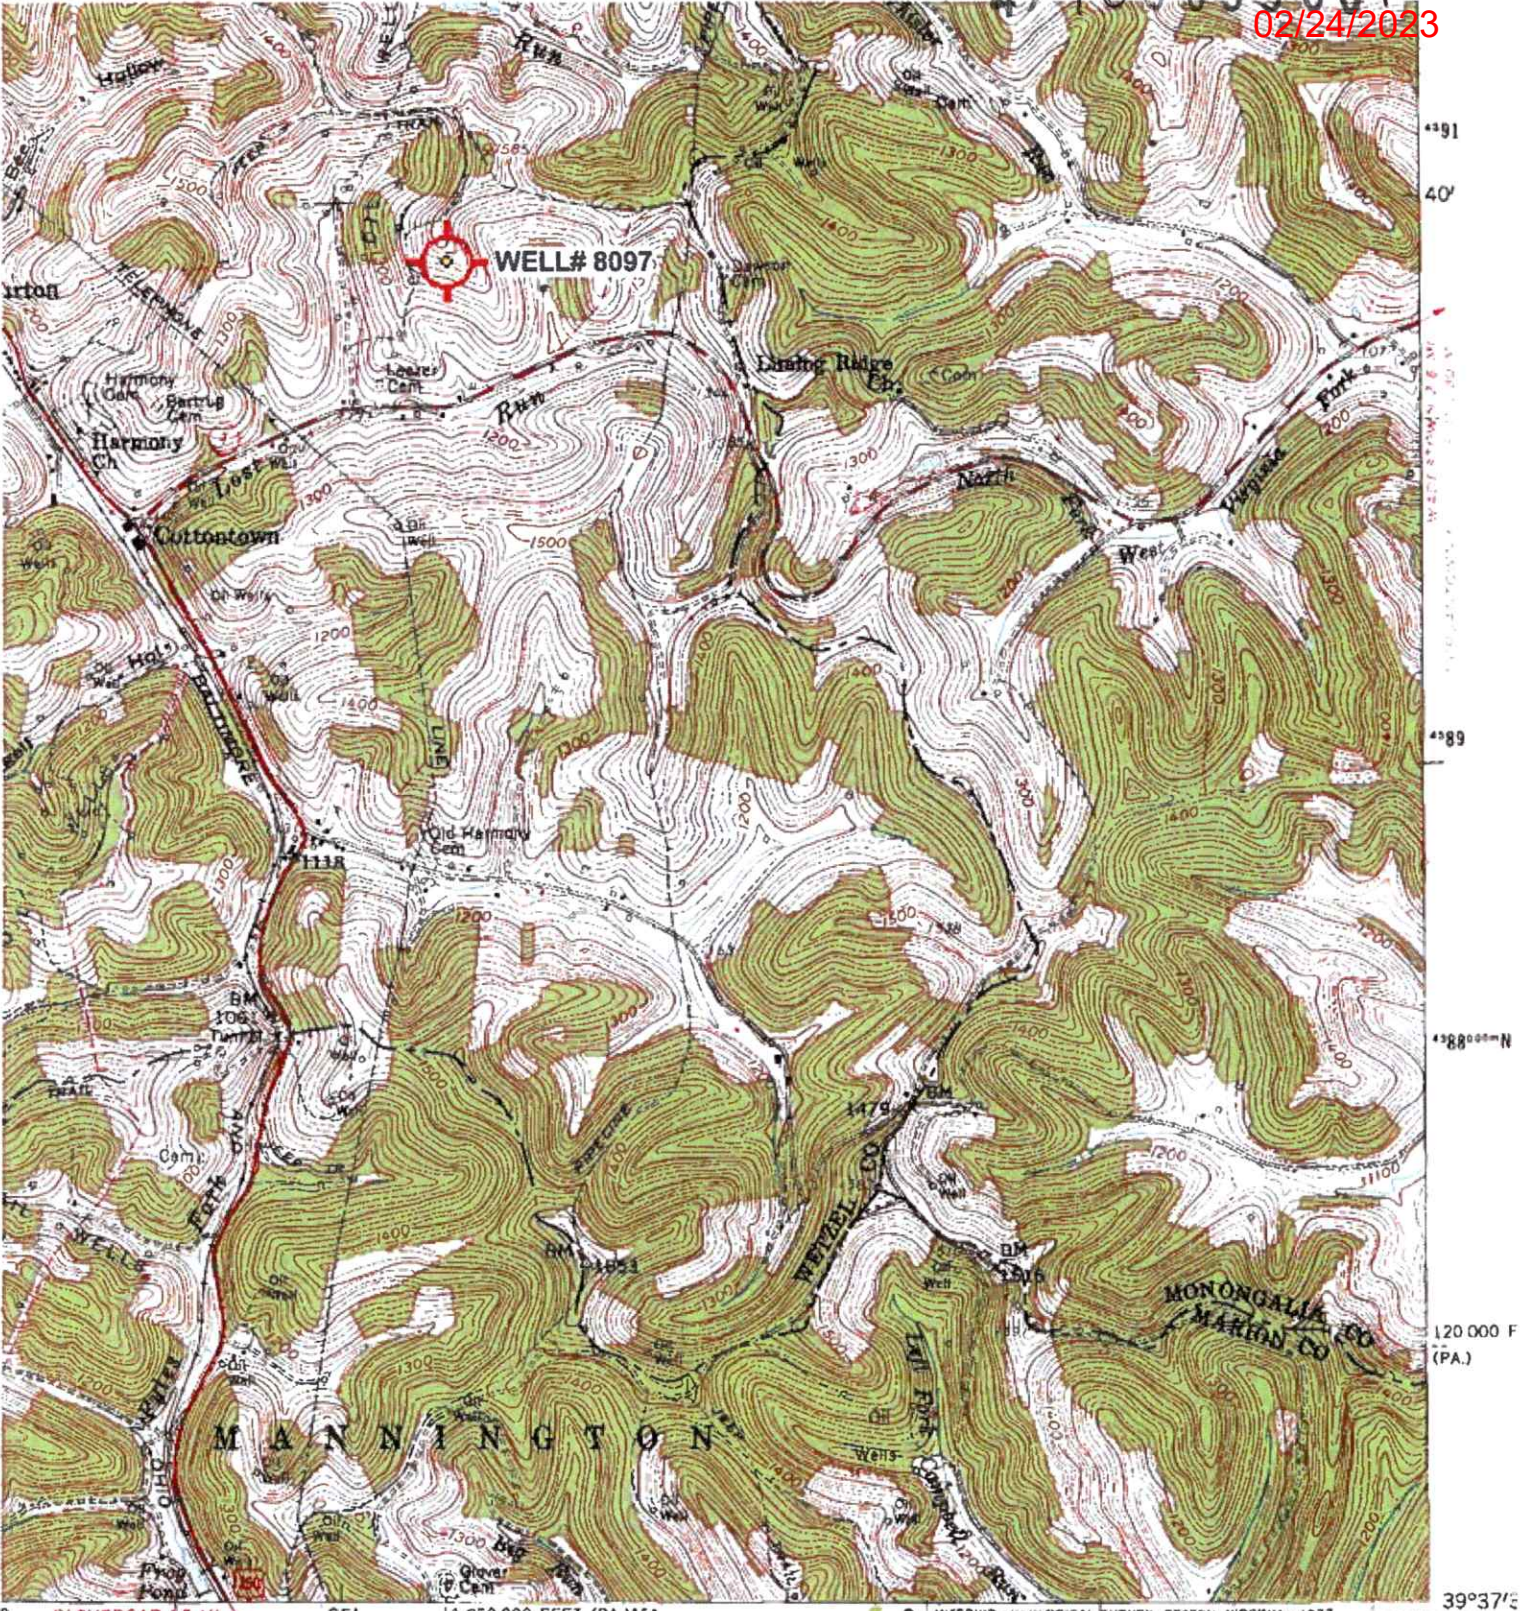

9 GLOVER GAP 15 MI. FAIRMONT 23 MI. 25'

1:250 000 FEET (PA.) 51 INTERIOR GEODETIC SURVEY, RESTON, VIRGINIA-1977 52 53 000' E

39°37'5 80°22'30" (MAN. 200)

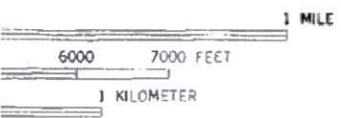

RECEIVED
Office of Oil and Gas

FEB 06 2023
Heavy-duty
Medium-duty
U.S. Route
State Route

ROAD CLASSIFICATION

	Light-duty	
	Unimproved dirt	

WV Department of Environmental Protection

U.S. Route State Route

Stephen McCoy



QUADRANGLE LOCATION

HUNDRED, W. VA.—PA.
NW/4 MANNINGTON 15' QUADRANGLE
N3937.5—W8022.5/7.5

'Hundred; WV, PA' Scale: 1" = 0.379Mi 610Mt 2.000Ft. 1 Mi = 2.640' . 1 cm = 240Mt

WW-7
8-30-06



West Virginia Department of Environmental Protection
Office of Oil and Gas

WELL LOCATION FORM: GPS

API: 47-103-70137 WELL NO.: 8097

FARM NAME: L. STANTON LEEZER

RESPONSIBLE PARTY NAME: WEST VIRGINIA LAND RESOURCES INC.

COUNTY: WETZEL DISTRICT: CHURCH

QUADRANGLE: HUNDRED W.VA, PA

SURFACE OWNER: LEEZER FAMILY IRREVOCABLE TRUST

ROYALTY OWNER: _____

UTM GPS NORTHING: 4,390,738 m (1469')

UTM GPS EASTING: 550,433 m GPS ELEVATION: 448 m

The Responsible Party named above has chosen to submit GPS coordinates in lieu of preparing a new well location plat for a plugging permit or assigned API number on the above well. The Office of Oil and Gas will not accept GPS coordinates that do not meet the following requirements:

1. Datum: NAD 1983, Zone: 17 North, Coordinate Units: meters, Altitude: height above mean sea level (MSL) – meters.
2. Accuracy to Datum – 3.05 meters
3. Data Collection Method:

Survey grade GPS _____ : Post Processed Differential _____

Real-Time Differential _____

Mapping Grade GPS X : Post Processed Differential X

Real-Time Differential _____

4. Letter size copy of the topography map showing the well location.

I the undersigned, hereby certify this data is correct to the best of my knowledge and belief and shows all the information required by law and the regulations issued and prescribed by the Office of Oil and Gas.

Signature

Professional Surveyor
Title

JANUARY 23, 2023
Date

Stephen McCoy

RECEIVED
Office of Oil and Gas
FEB 06 2023
WV Department of
Environmental Protection