


02/24/2023



As per (Pm 1)

Francis McCoy

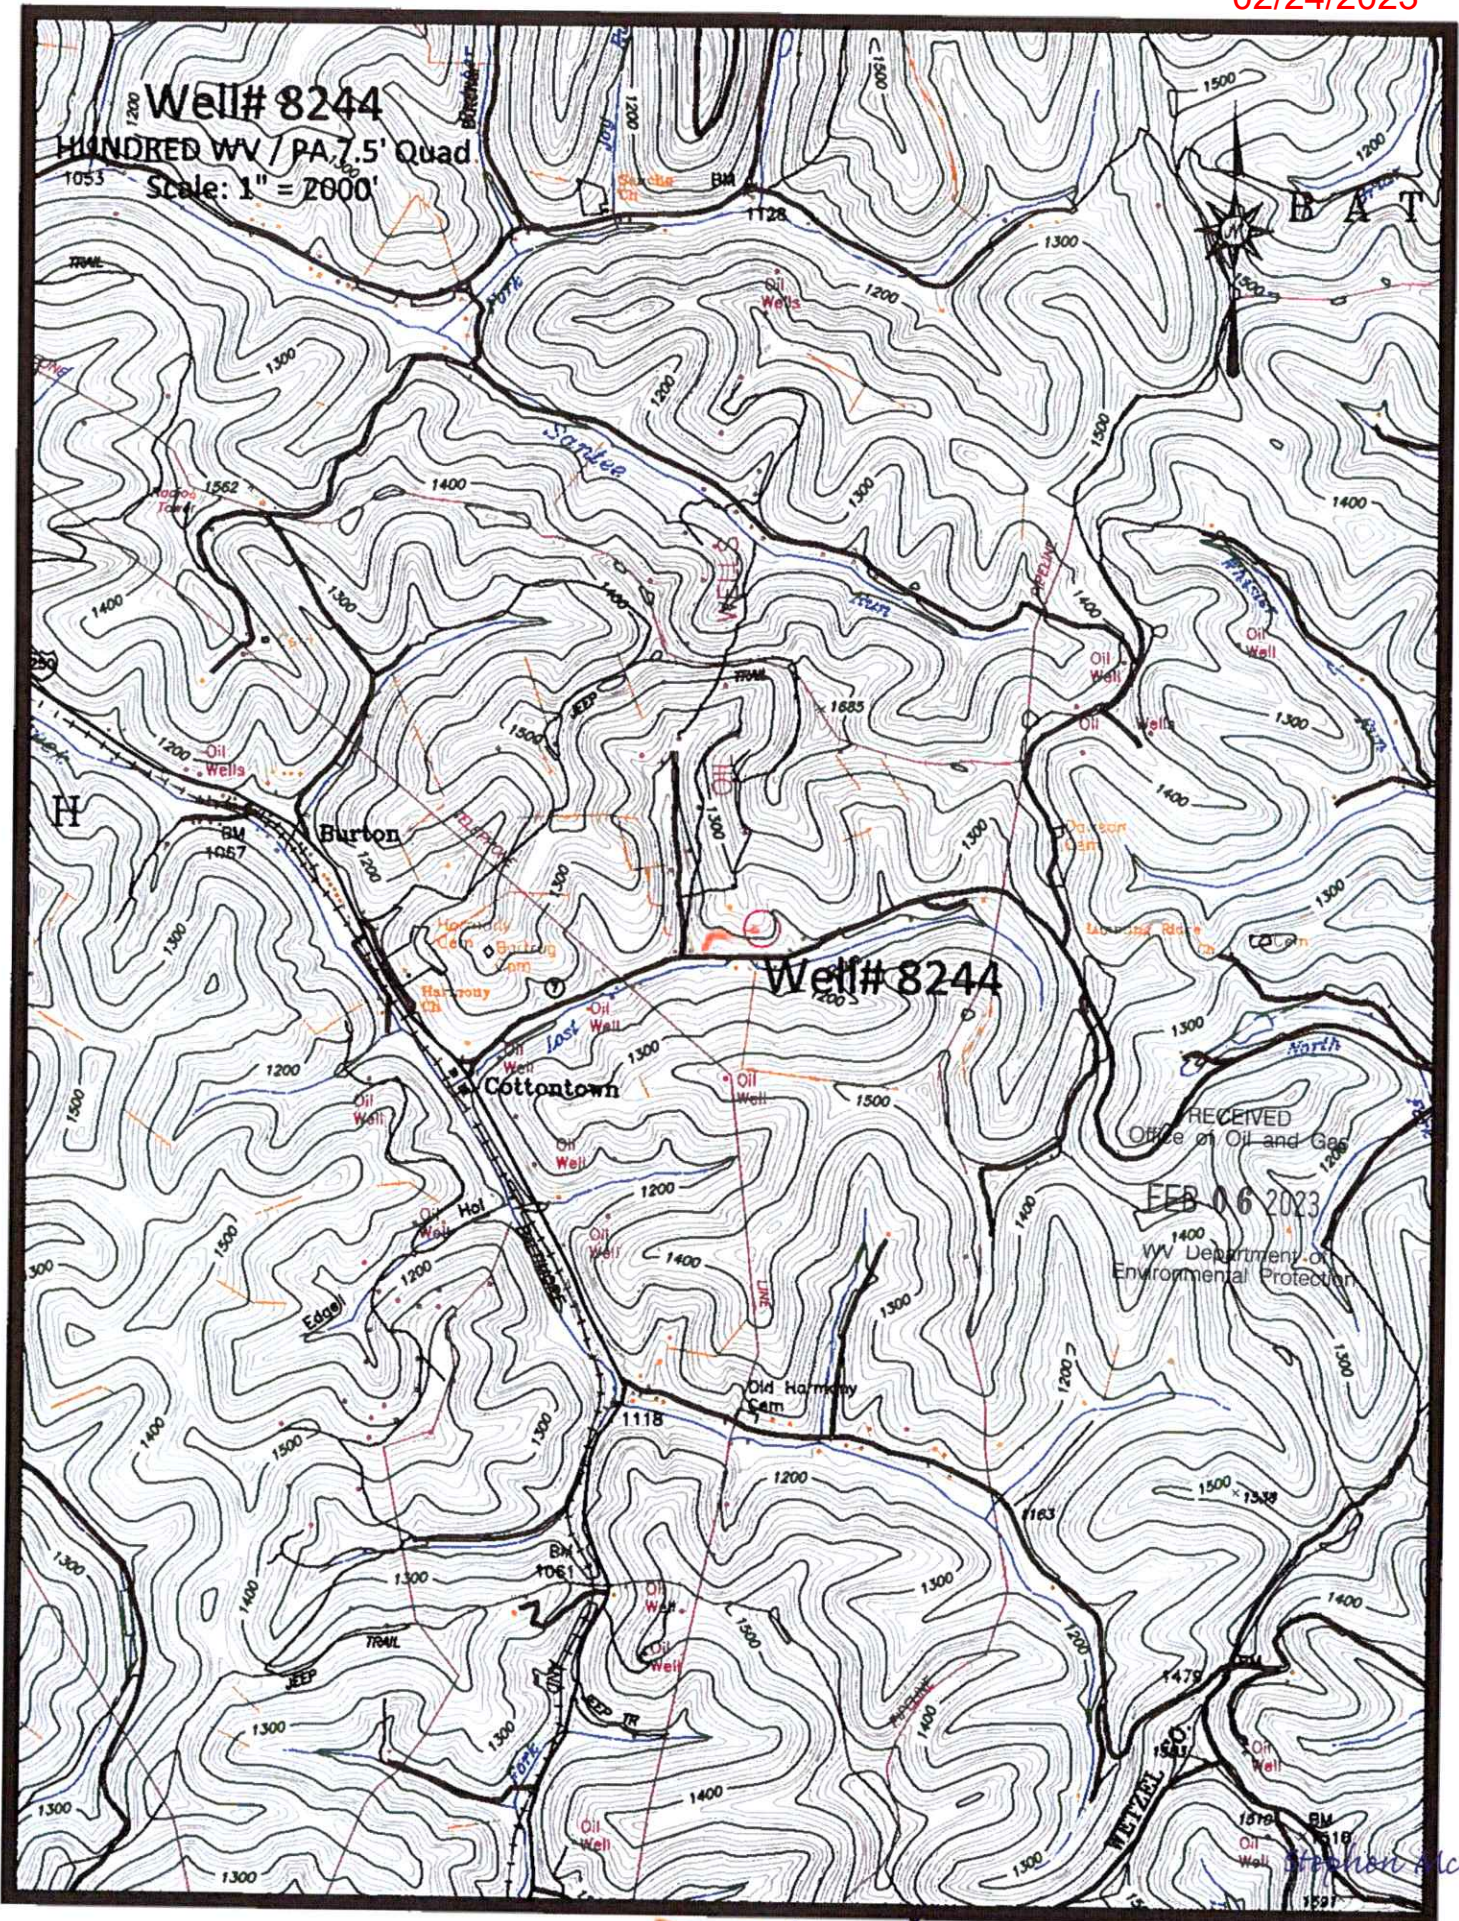

47 103035 61 P  
02/24/2023



491  
40'  
489

RECEIVED  
Office of Oil and Gas  
FEB 06 2023  
WV Department of  
Environmental Protection

120 000 FEET  
(PA.)

39°37'30"  
80°22'30"  
(MANNINGTON)  
4882 III SE

SAP 1/5 MI.  
ONT 23 MI.



INTERIOR GEOLOGICAL SURVEY, RESTON, VIRGINIA—1977  
52 530000E

ROAD CLASSIFICATION

Heavy duty		Light duty	
Medium-duty		Unimproved dirt	
U. S. Route		State Route	

HUNDRED, W. VA.—PA.  
NW/4 MANNINGTON 15' QUADRANGLE  
N 3937.5—W 8022.5/7.5

Stephen McCoy

Hundred: WV D&E Sects: 41-0-27014; 640M; 0-0005; 4-11-0-0018; 0-0111



4710303561P 02/24/2023

WW-7  
8-30-06



West Virginia Department of Environmental Protection  
Office of Oil and Gas

WELL LOCATION FORM: GPS

API: 47-103-70138 WELL NO.: 8244

FARM NAME: L. STANTON LEEZER

RESPONSIBLE PARTY NAME: WEST VIRGINIA LAND RESOURCES INC.

COUNTY: WETZEL DISTRICT: CHURCH

QUADRANGLE: HUNDRED W.VA, PA

SURFACE OWNER: LEEZER FAMILY IRREVOCABLE TRUST

ROYALTY OWNER: \_\_\_\_\_

UTM GPS NORTHING: 4,390,369 m (1246')


UTM GPS EASTING: 550,366 m GPS ELEVATION: 380 m

The Responsible Party named above has chosen to submit GPS coordinates in lieu of preparing a new well location plat for a plugging permit or assigned API number on the above well. The Office of Oil and Gas will not accept GPS coordinates that do not meet the following requirements:

1. Datum: NAD 1983, Zone: 17 North, Coordinate Units: meters, Altitude: height above mean sea level (MSL) – meters.
2. Accuracy to Datum – 3.05 meters
3. Data Collection Method:

Survey grade GPS \_\_\_\_\_: Post Processed Differential \_\_\_\_\_  
 Real-Time Differential \_\_\_\_\_  
 Mapping Grade GPS X: Post Processed Differential X  
 Real-Time Differential \_\_\_\_\_

4. Letter size copy of the topography map showing the well location.  
 I the undersigned, hereby certify this data is correct to the best of my knowledge and belief and shows all the information required by law and the regulations issued and prescribed by the Office of Oil and Gas.

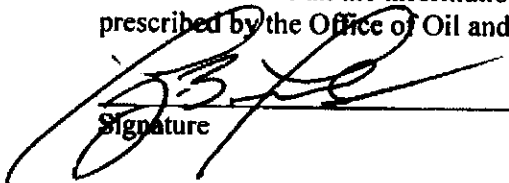  
 Signature

Professional Surveyor  
 Title

JANUARY 13, 2023  
 Date

RECEIVED  
 Office of Oil and Gas  
 FEB 06 2023  
 WV Department of  
 Environmental Protection

Stephen McCoy