
WW-7 8-30-06



West Virginia Department of Environmental Protection Office of Oil and Gas

WELL LOCATION FORM: GPS

API: 47-103-72	2334	WELL NO.:	7306	
FARM NAME: I.D. MOF	RGAN			
RESPONSIBLE PARTY NAME: WEST VIRGINIA LAND RESOURCES INC.				
COUNTY: WETZEL	I	DISTRICT: GR	RANT	
COUNTY: WETZEL DISTRICT: GRANT QUADRANGLE: BIG RUN W.VA				
QUADRANGLE: BIG RUN W.VA SURFACE OWNER: MICHAEL A. BAKER SR.				
ROYALTY OWNER:				
UTM GPS NORTHING: 4,37	73,260	<u>m</u>	(9811)	
UTM GPS NORTHING: 4,373,260 m (981') UTM GPS EASTING: 540,394 m GPS ELEVATION: 299 m				
The Responsible Party named above has chosen to submit GPS coordinates in lieu of preparing a new well location plat for a plugging permit or assigned API number on the above well. The Office of Oil and Gas will not accept GPS coordinates that do not meet the following requirements: 1. Datum: NAD 1983, Zone: 17 North, Coordinate Units: meters, Altitude: height above mean sea level (MSL) – meters. 2. Accuracy to Datum – 3.05 meters 3. Data Collection Method: Survey grade GPS: Post Processed Differential Office of Oil and Gas				
Real-Ti Mapping Grade GPS X: Post				03 2023
	Processed Different		WV D	epartment or ental Protection
4. Letter size copy of the topography map showing the well location. I the undersigned, hereby certify this data is correct to the best of my knowledge and belief and shows all the information required by law and the regulations issued and prescribed by the Office of Oil and Gas.				
13.fe	Profession	al Surveyor	JANUARY 3, 2023	
Signature	Ti	tle	Date	

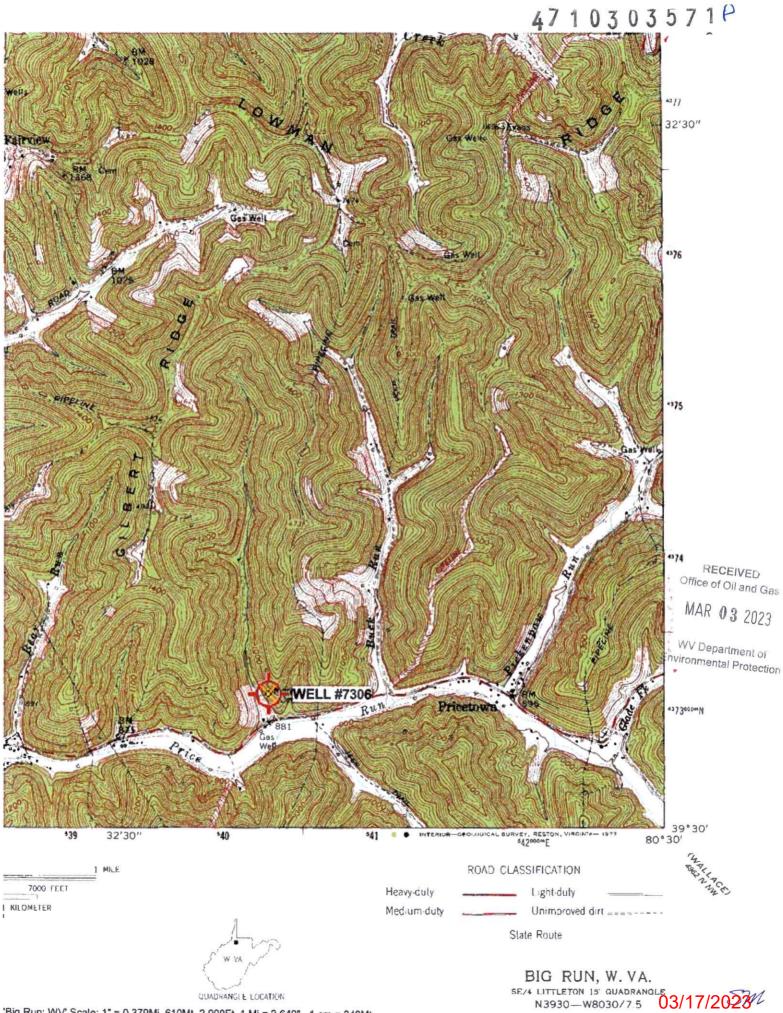

'Big Run; WV' Scale: 1" = 0.379Mi 610Mt 2.000Ft 1.Mi = 2.640" 1.cm = 240Mt