



4710303652

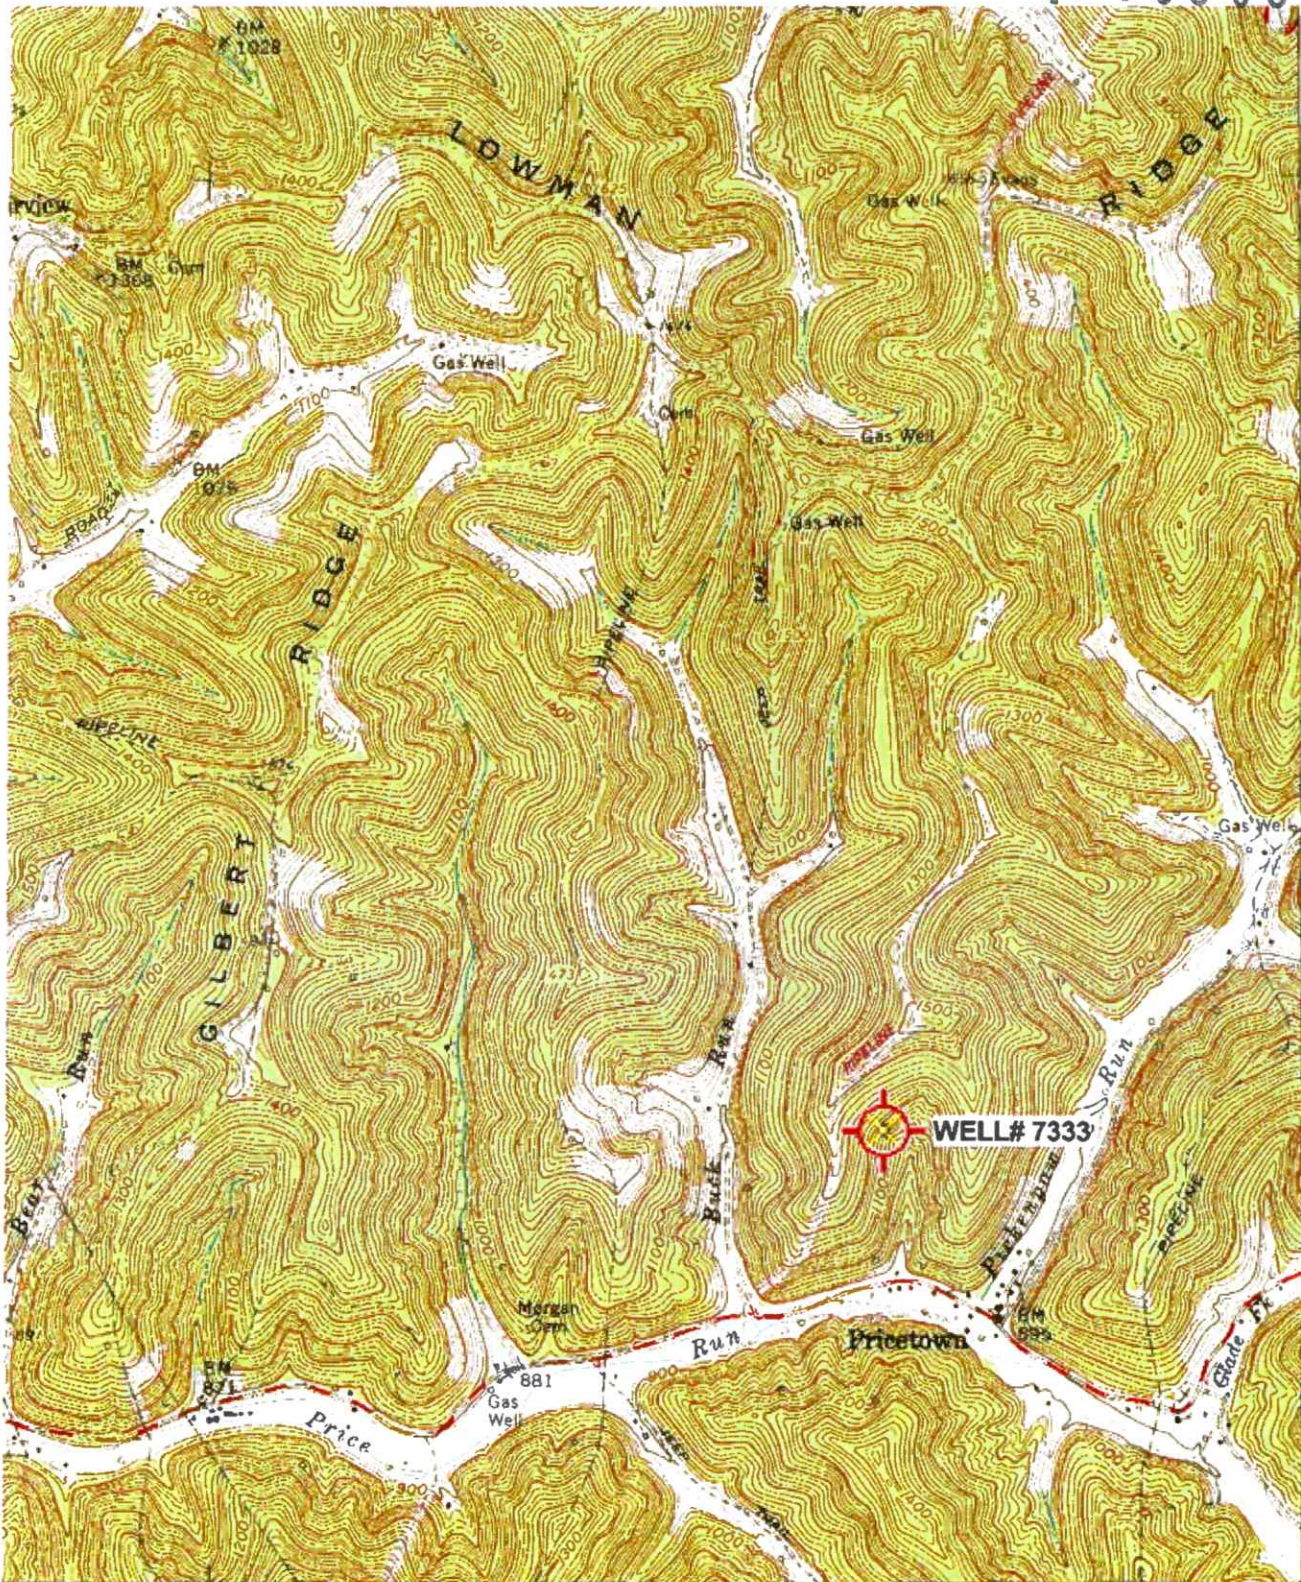

42°11'
32'30"
42°76'
42°75'
42°74'
42°30'
39°30'

839 32'30" 840 841 80°30'

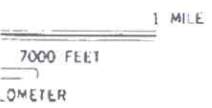

MAR 25 2024

ROAD CLASSIFICATION

Heavy-duty	Light-duty
Medium-duty	Unimproved dirt
	Slate Route




BIG RUN, W. VA.
SE 1/4 LITTLETON 15' QUADRANGLE
N3930—W8030/7.5

04/19/2024

Horizontal scale: 1" = 0.379 Mi (610 M); 2.000 Ft; 1 Mi = 2.640" 1 cm = 24.0 M

(WALLACE)
4562 N NW

4710303652

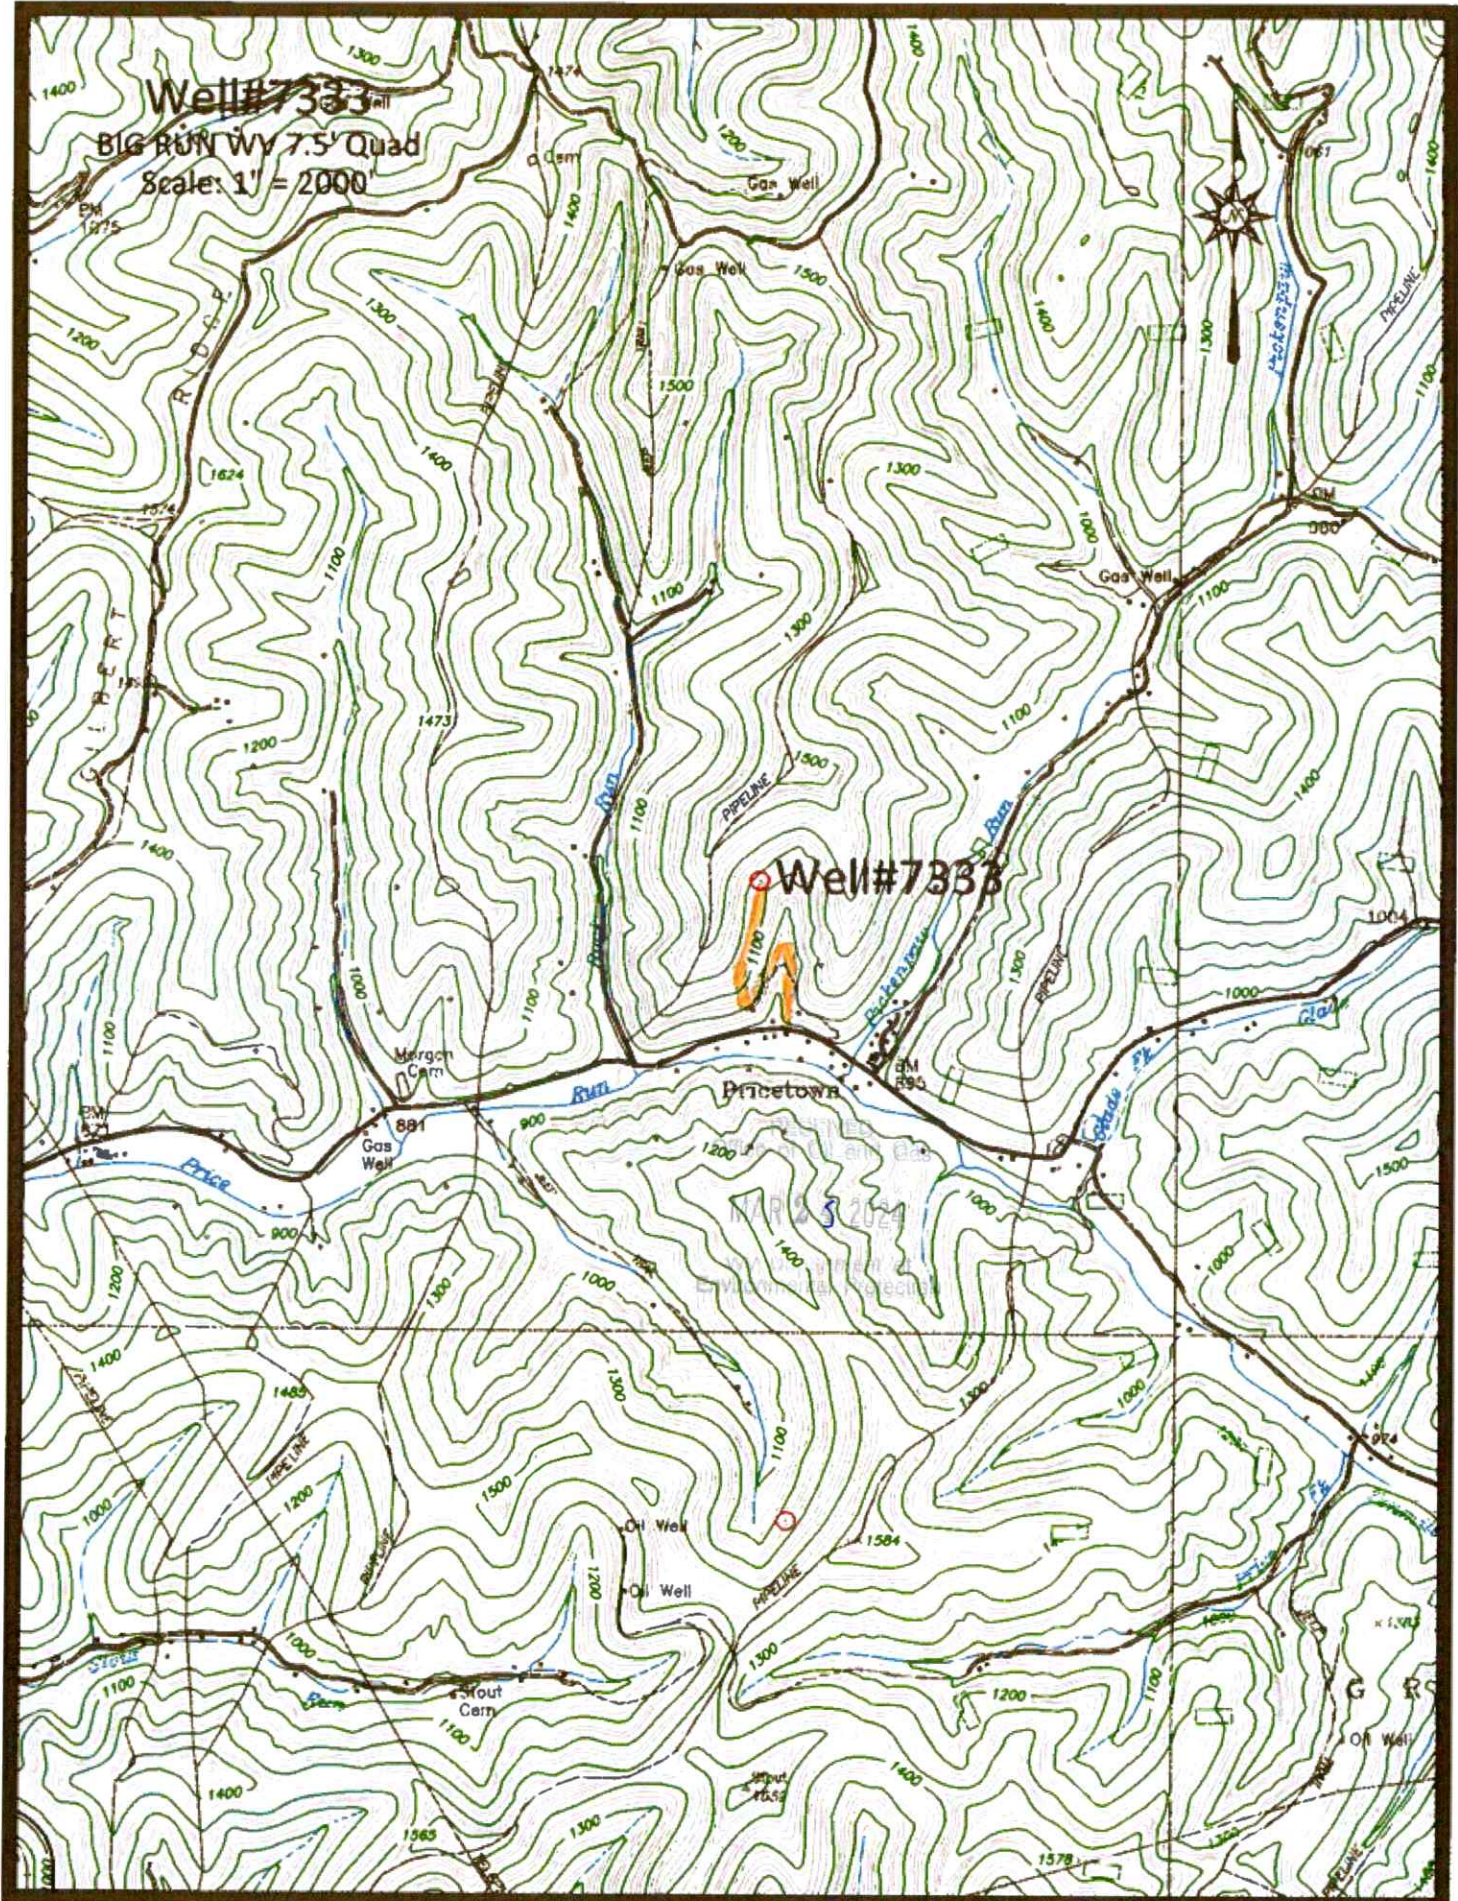

Well #7333
BIG RUN WY 7.5' Quad
Scale: 1" = 2000'

Well #7333

Access Road

04/19/2024

47 1 03 03 6 5 2

WW-7
8-30-06



West Virginia Department of Environmental Protection
Office of Oil and Gas
WELL LOCATION FORM: GPS

API: 47-103-72199 WELL NO.: 7333

FARM NAME: I D MORGAN 43

RESPONSIBLE PARTY NAME: WEST VIRGINIA LAND RESOURCES INC.

COUNTY: WETZEL DISTRICT: GRANT

QUADRANGLE: BIG RUN WV

SURFACE OWNER: WALTER KEITH ENSMINGER

ROYALTY OWNER: _____

UTM GPS NORTHING: 4,373,871 m

UTM GPS EASTING: 541,627 m GPS ELEVATION: 369 m


The Responsible Party named above has chosen to submit GPS coordinates in lieu of preparing a new well location plat for a plugging permit or assigned API number on the above well. The Office of Oil and Gas will not accept GPS coordinates that do not meet the following requirements:

- Datum: NAD 1983, Zone: 17 North, Coordinate Units: meters, Altitude: height above mean sea level (MSL) – meters.
- Accuracy to Datum – 3.05 meters
- Data Collection Method:
Survey grade GPS _____ : Post Processed Differential _____

Real-Time Differential _____
 Mapping Grade GPS X : Post Processed Differential X
 Real-Time Differential _____

- Letter size copy of the topography map showing the well location.**

I the undersigned, hereby certify this data is correct to the best of my knowledge and belief and shows all the information required by law and the regulations issued and prescribed by the Office of Oil and Gas.

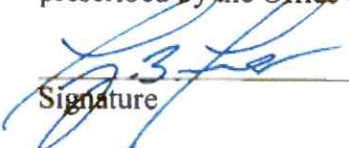
Signature

PS 2002

Title

MARCH 12, 2024

Date

RECEIVED
Office of Oil and Gas
MAR 25 2024
WV Department of
Environmental Protection

04/19/2024