



West Virginia, (being abandoned)

N.E. Maple mine  
S 63 W 16.6

Stone

Stone

N 11. E 9  
Hickory

S 61. W 21  
stone

N 20 W 31.0

S 62 W 167.

Rebecca Giblin

Stone  
S 43 $\frac{1}{2}$  W 24.

Beginning  
S 50 $\frac{1}{2}$  E 12.  
Stone

S 39 E 26.2

Stone

S 40 $\frac{1}{2}$  E 36.4

Stone

S 49 $\frac{1}{2}$  E 14

Stone

S.W. Snodgrass

S 38 E 38

Stone

SCALE: - 40 poles 1 inch  
Distance given in poles.

CERTIFICATE

I the undersigned  
and shows all the information  
belief, required by the  
of West Virginia

that this map is of  
the best of my knowledge  
an section of the mining

*R. B. Bradley*  
Surveyor

Acknowledged before me  
West Virginia

This is the true and correct


of West Virginia

*R. B. Bradley*

Dec 24 1911

30008

Plat showing the location of the ...  
of W.C. Cole heirs, ...  
containing 274 Acres, ...  
West Virginia, ...

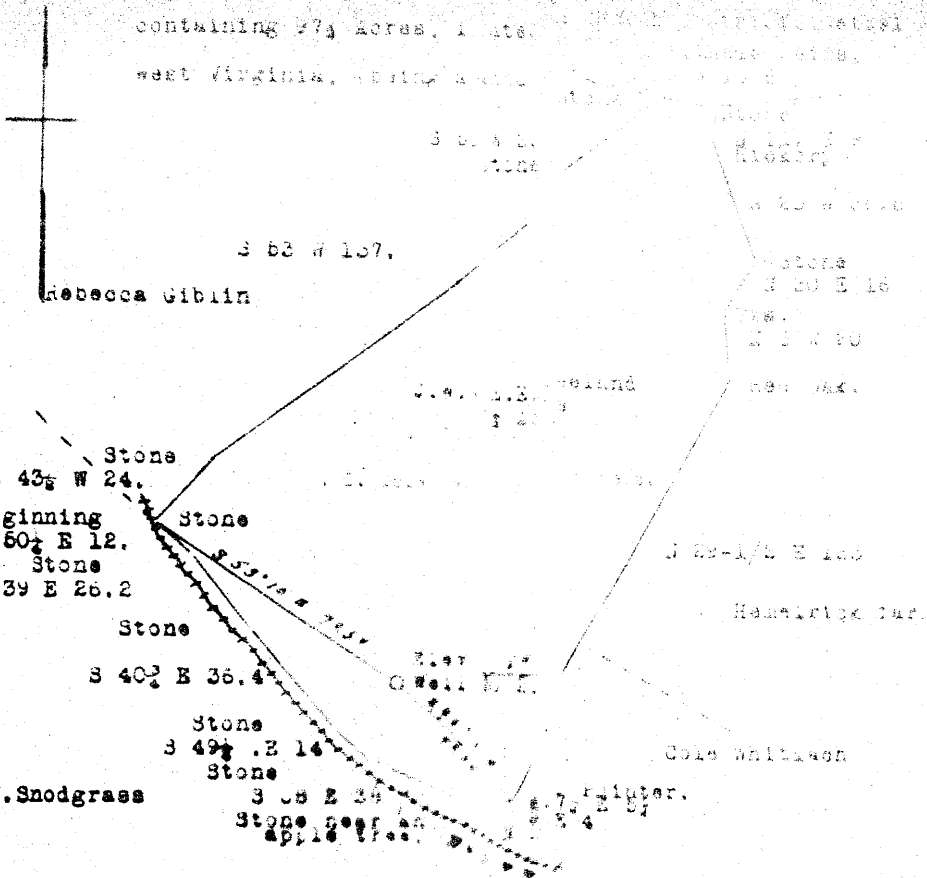

SCALE: - 40 poles = 1 inch  
Distance given in poles.

TESTIMONY OF SURVEYOR

I the undersigned ...  
and shows all the ...  
belief, required by the ...  
of West Virginia

... that this map is ...  
the best of my knowledge ...  
a section of the mining ...

*U. S. ...*  
County Surveyor of ...  
County, West Virginia

Acknowledged before me ...  
West Virginia

This ...

My commission expires ...  
*R. B. McComb*

*Dec 24 1861*

... of ...

Church District, Wetzel County, W. Va.

By The Pure Oil Co., Sistersville, W. Va.

Abandoned under permit Wet-8.

On  $9\frac{1}{2}$  acres, surface owned by J. W. and E. E. Freeland,  
Hundred, W. Va., and minerals by W. C. Coles Heirs,  
Hundred, W. Va.

Commenced drilling March 5, 1929.

Elevation, 1189' W.

1 $\frac{1}{2}$ " wood conductor, 14'; 10" casing, 281' 7";  $8\frac{1}{2}$ " 1327' 6";  
6 $\frac{3}{8}$ " 2085'.

Coal was encountered at 805-808 and 914-922'.

Abandonment reported to Dept. of Mines Oct. 21, 1929.

Well was not shot. No water. Dry hole.

Record to RCF from Mrs. Griffith Sept. 10, 1938.

	Top.	Bottom.	Thickness.
Mapletown (Sewickley) Coal	805	- 808	3
Pittsburgh Coal	914	- 922	8
Little Dunkard Sand	1305	- 1368	63
Big Dunkard Sand	1400	- 1504	104
Gas Sand	1562	- 1612	50
1st Salt Sand (gas, 1714-1723')	1709	- 1723	14
2nd Salt Sand	1825	- 1916	91
Marton Sand	2032	- 2085	53
Big Line	2085	- 2130	45
Big Injun Sand (gas, 2170-2180')	2130	- 2370	240
Gantz Sand	2836	- 2850	14
50-Ft. Sand	2887	- 2900	23
30-Ft. Sand (gas, 2924-2926'; test, 12/10ths water in 1")	2920	- 2950	30
Total depth			2961

Church District, Wetzel County, W. Va.

By The Pure Oil Co.

On 89 acres; lease No. 3011. Location report sent in 1-25-29.

Well started March 5, 1929; completed, March 21, 1929.

Well was not shot. (Map Loc. NW-S2-E11).

30/10 Mercury through 2" opening - 900,000 cu. ft. gas.  
shot in 8 1/2" casing.

1st min., 22 lbs.; 2nd, 40 lbs.; 3rd, 58 lbs.; 4th, 75 lbs.;  
5th, 90 lbs.; 6th, 106 lbs.; 7th, 121 lbs.; 8th, 134 lbs.;  
9th, 147 lbs.; 10th, 158 lbs.; 15 min., 204 lbs.; 20 min.,  
235 lbs.; 23 1/2 min., 250 lbs.; one hour, 325 lbs.

Conductor, 14"; 10" casing, 261' 7"; 8 1/2", 1327' 6"; 3" tubing,  
1717' 6".

3" tubing below packer, 7 joints, 11 1/2th, 133' 5". 3" mixed  
nipple above packer 11 1/2 & 8th, 9' 3". 3" line pipe above  
packer (new), 9th, 18 joints, 363' 3". 3" line pipe above  
packer (old), 8th, 57 joints, 1211' 7". Leaving 133' 5" -  
8" hole below packer. Cags at 1714". Perforation at 1721".  
Packed with 3" x 8" anchor packer. Neck on packer, 4 1/2".  
5 bbl. water on packer. Packer set April 4, 1929.

Drilled deeper (below 1723'); started Aug. 29, 1929; completed,  
September 23, 1929. Not worth producing - pulled; 12/10  
water through 1" opening.

6-5/8" casing, 2095'.

Records from E. Townley, Room 2308, 35 W. Wacker Drive,  
Chicago, Ill., March 13, 1931.

	Top.	Bottom.
Fairview (Waynesburg) Coal	550	
Mapletown (Sewickley) Coal	805	
Pittsburgh Coal	914	922
Little Dunkard Sand	1305	1368
Big Dunkard Sand	1400	1504
Gas Sand	1562	1612
1st Salt Sand (gas pay, 1714-1723'; not drilled through sand)	1709	
Total depth		1723
DRILLED DEEPER:		
1st Salt Sand (little gas, 1714-1723')	1709	1730
Started at	1723	
End Salt Sand	1825	1916
Maxton Sand	2032	2085
Big Line	2085	2130
Big Injun Sand (little gas, 2170-2180')	2130	2370
Gantz Sand	2836	2850
50-Ft. Sand	2877	2900
30-Ft. Sand (little gas, 2924-2926')	2920	2950
Gordon Stray Sand	2959	
Total depth		2961