Longitude

1.93s 1.36w

Latitude

Topo Location

7.5' Loc. _____ 15' Loc. _____ (calc.)

Company Hope Natural Gas Co

Farm JB NINERMAN # 4130


15' Quad ______ (sec.)

7.5' Quad Glover Gap

District GRANT

WELL LOCATION PLAT

County 103 Permit 30018

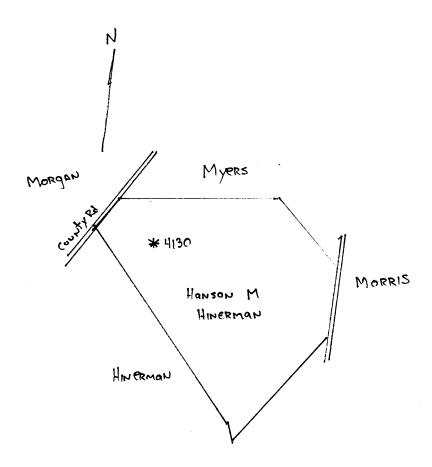

Grant District, Wetsel County, W. Va.

By Hope Natural Gas Co., 145 W. Main St., Clarksburg, W. Va.

On 96 acres, surface owned by Hanson H. Hinerman Heirs, Coburn,
W. Va., and mineral rights by Little Kanawha Syndicate.

Drilled prior to June 1, 1929.

Elevation, 1166.5' Alt.

10" casing, 580'; 6-5/8", 2077'.

Coal was encountered at 754-758 and 846-853'.

Abandonment reported to Dept. of Mines April 28, 1930.

WET-18-A

	Top.	Bottom,
Native coal (Sewickley)	754	- 758
Pittsburgh Coal	846	- 853
Little Dunkard Sand	1248	- 1272
Big Dunkard Sand (Sim casing run at 1356 and pulled out at time drilling was completed)	1333	- 1385
Gas Sand	1493	- 1560
1st Salt Sand (gas show, 1665')	1620	- 1695
2nd Salt Sand	1800	- 1865
Maxton Sand	1928	- 2038
Big Lime	50 ph	- 2088
Big Injun Sand (gas, 7/10 W., at 2127')	2088	- 2308
50-Ft. Sand (gas, 10/10 W., at 27861)	2780	- 2792
30-7t. Sand	2814	- 2840
Gordon Stray Sand	2870	- 2909
Gordon Sand (4/10 W., at 2968+, gas)	2935	- 2988
4th Sand (gas, 3/10 W., at 3035')	3011	- 3039

(Record below 1385' in pencil, by J.O.; size of openings not given for gas tests)