


Latitude

Longitude

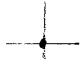

 1.115

 1.76w

Topo Location

7.5' Loc. _____ 15' Loc. _____
 _____ (calc.) _____

Company Manufact Lt+Ht

Farm James & Sarah Elson # 3292


15' Quad _____
(sec.)

7.5' Quad Porters Falls

District Green

WELL LOCATION PLAT

County 103 Permit 30026

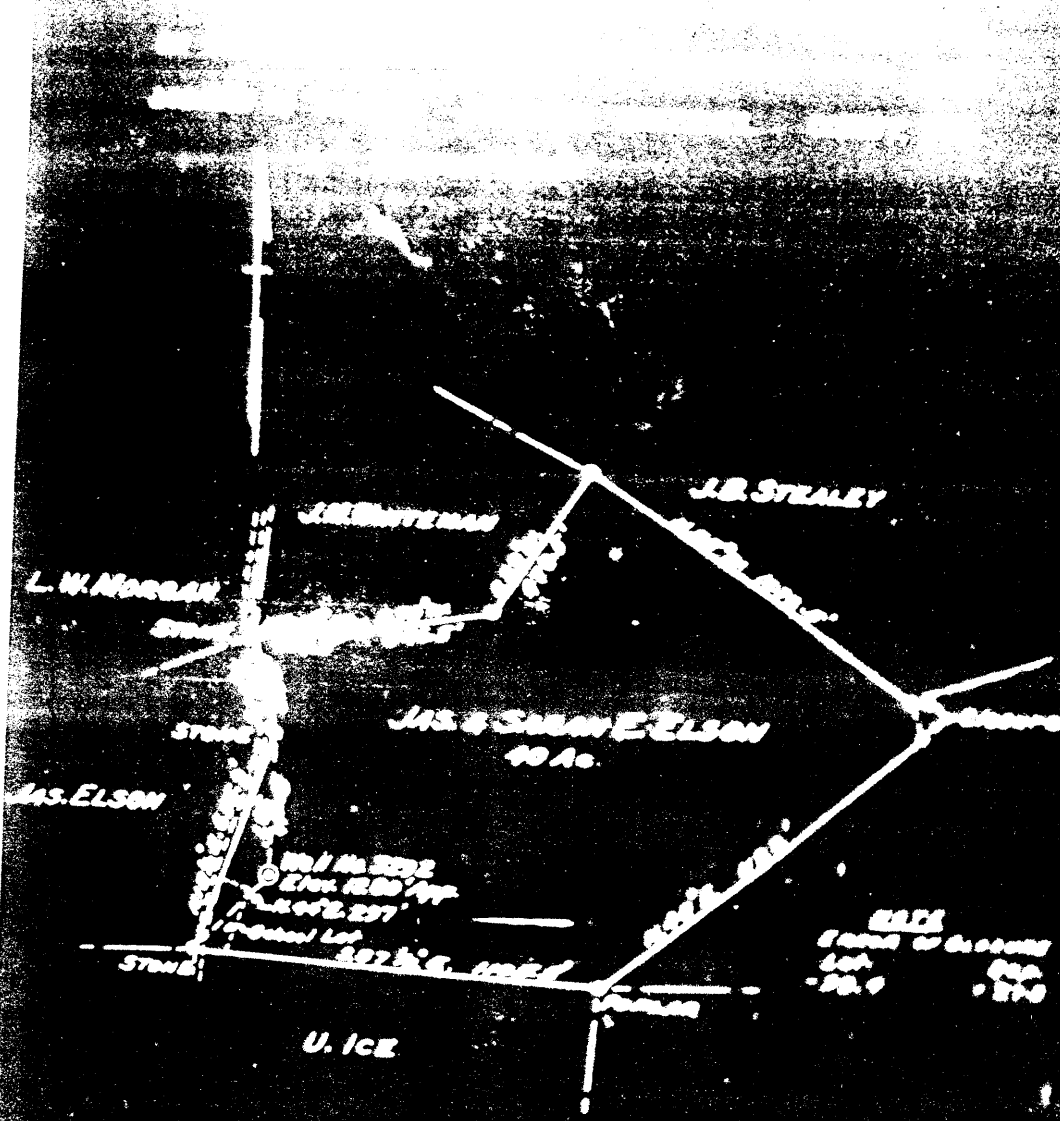

THE FOLLOWING IS A SUMMARY OF THE SURVEY DATA:

1. The survey was conducted on [illegible] day of [illegible] 19[illegible].

2. The survey was conducted by [illegible].

3. The survey was conducted in accordance with the provisions of the [illegible] Act.

4. The survey was conducted in accordance with the provisions of the [illegible] Act.

5. The survey was conducted in accordance with the provisions of the [illegible] Act.

Green District, Petrol County, W. Va.

By the Manufacturers Light & Heat Co.

Abandoned under permit 1926-26.

2 1/2 acres, in Bendler, W. Va., field.

Rig commenced Aug. 10, 1926; completed, Aug. 15, 1926.

Drilling commenced Aug. 22, 1926; completed, Oct. 19, 1926.

Cost per foot, \$1.70. Contractor, A. J. Karl, Bisteraville, W. Va.

Drillers' names: Neely Wicker, Harry Irvin, Walter Conley, Ed. Bond.

Old 52' steel rig, Heddleston & Napp.

Conductor, 16'; 10" casing, 329'; 8 1/2", 1515'; 6 1/2", 2197'; all left in.

Shot Oct. 24, 1926, with 15 qts.; 1st day's production, 2 bbls.

1-bbl. well. (pencil notation).

Photostatic copy of well log to Dept. of Mines (not dated).

Report to RPT from Mrs. Griffith Sept. 10, 1938.

	Top.	Bottom.	Thickness.
Clay, silt, and lime	0	790	790
Coal	790	796	6
Coal	1076	1077	1
Pittsburgh coal	1064	1065	1
Sand	1085	1120	35
Red rock	1130	1135	5
Red rock	1170	1175	5
Red rock	1255	1270	15
Red rock	1360	1370	10
Red rock	1470	1480	10
Dunkard Sand	1485	1570	85
Sand	1580	1600	20
Sand	1680	1735	55
Sand	1925	1990	65
Morton Sand (gas, 1070-2075; test, 6/10 mercury in 4" org. burned in line and utilized)	2075	2075	20
Little lime	2155	2180	25
Big lime	2181	2241	60
Big Injun Sand (show gas, 2246-2252'; water, 2256-2262'; show of oil, 2286'; oil, gas, and water, 2349- 2358'; 1/2 bbls. per day)	2241	2360	119
Total depth		2360	