


30036

Green dist

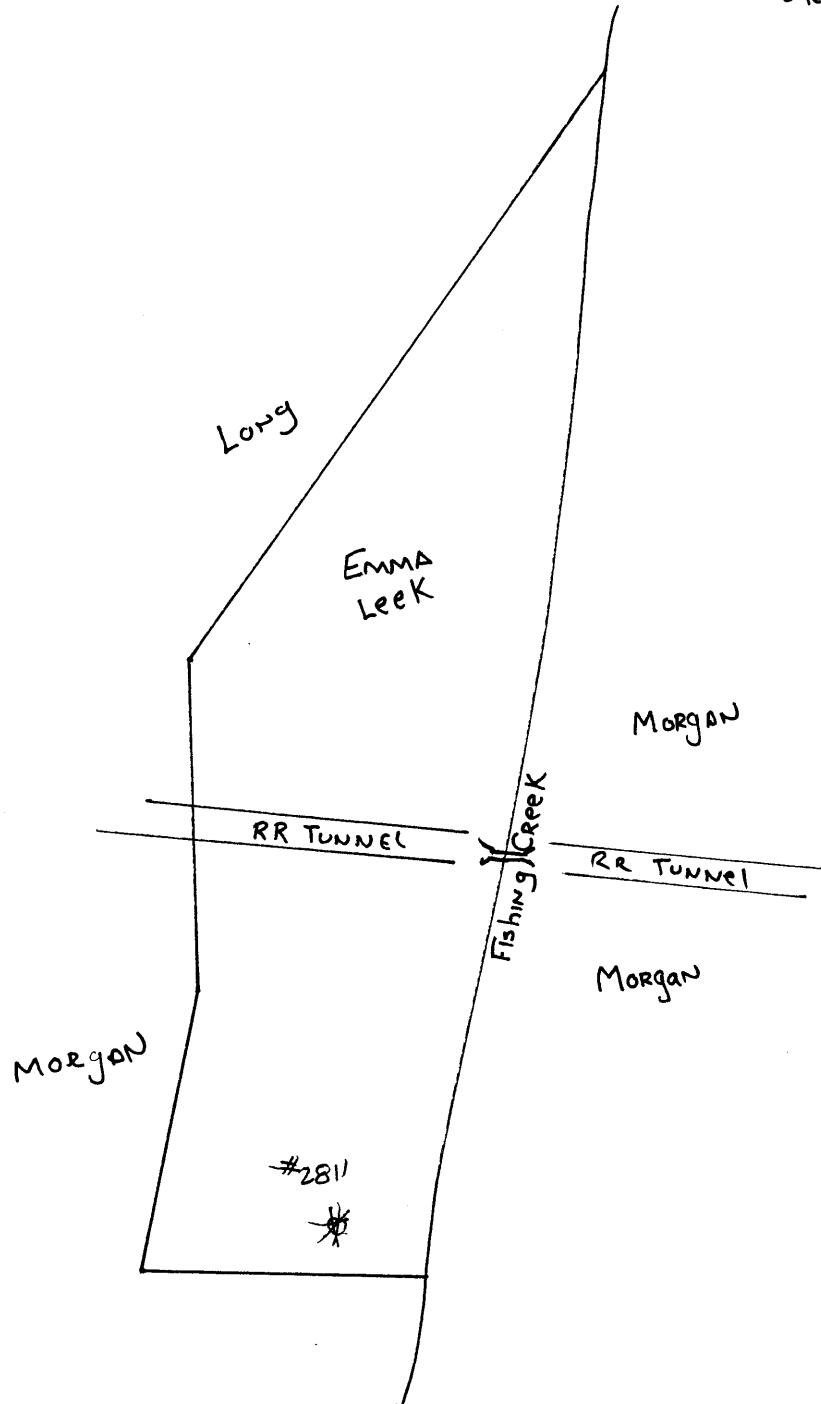

EMMA AND ELISHA LECK NO. 2511 WELL. No. 235 O.P.-Wetzel.

Green District, Wetzel County, W. Va.

**By The Manufacturers Light & Heat Co., 500 Union Trust Bldg.,
Pittsburgh, Pa.**

**On 44 acres, surface owned by Emma and Elisha Leck, Box 52,
Porters Falls, W. Va.; and mineral rights by ML&H Co., Dgh., Pa.**

Drilled prior to July 1, 1929.

Elevation, 705'.

Coal was encountered at 455-464'.

Abandonment reported to Dept. of Mines Jan. 26, 1931.

**This well was purchased by The Manufacturers Light & Heat Company
in December, 1922, and we were unable to obtain a log of it.**

(NO RECORD)

NET-36A