

39° 32' 30"

**Latitude**

80° 30' 00"

Longitude  
1.825  
.17w

**Topo Location**

7.5' Loc. \_\_\_\_\_ 15' Loc. \_\_\_\_\_  
\_\_\_\_\_ (calc.) \_\_\_\_\_

**Company** South Penn Oil Co

**Farm** Fairfield - Peterson # 28

**15' Quad** \_\_\_\_\_  
(sec.)


**7.5' Quad** Big Run

**District** Grant

**WELL LOCATION PLAT**

**County** 103 **Permit** 30039

30039  
Grant dist

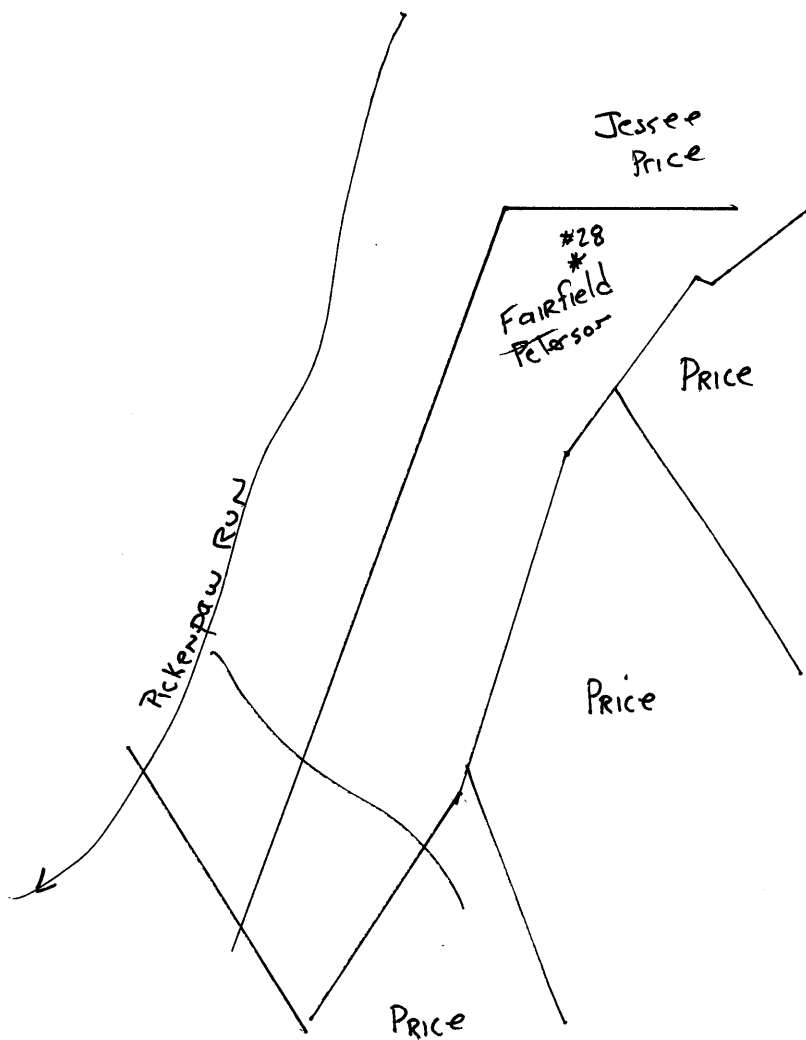

Grant District, Wetzel County, W. Va.  
 By South Penn Oil Co., P. O. Drawer 1255, Pittsburgh, Pa.  
 On 4564 acres, surface owned by J. L. Price, Smithfield, W. Va.,  
 and mineral rights by Nempco Corporation, 605 Wheeling  
 Banking & Trust Bldg., Wheeling, W. Va.

Elevation, 1305'.  
 16' conductor; 10" casing, 377'; 8 1/4", 1700'; 6-5/8", 2400';  
 5-3/16", 2772'.

Coal was encountered at 1155-1162'.

Abandonment reported to Dept. of Mines Jan. 16, 1931.

NOTE (by J.G.): Either this location is wrong or the elevation is off.  
 Well was shot.

Salt water at 1995, 2100, and 2145'.

Producing hole.

	Top.	Bottom.
Conductor	0	16
Pittsburgh Coal	1155	1162
Sand	1480	1500
Little Dunkard Sand	1550	1565
Big Dunkard Sand	1640	1645
Gas Sand (or gas?)	1800	1835
Gas Sand (or gas?)	1915	1950
First Salt Sand (water, 1995')	1960	2020
Second Salt Sand (water, 2100 and 2145)	2045	2180
Little Lime	2375	2385
Big Lime	2390	2455
Big Injun Sand (oil, 2463'; water, 2535)	2455	2590
Gantz? Sand	2700	2730
Berea Sand	2925	2935
50-Ft. Sand	3065	3085
30-Ft. Sand	3155	3180
Stray Sand	3215	3248
Gordon Sand (oil, 3252-3255')	3250	3265
Fourth Sand	3284	3300
Total depth		3675

WET-39