


Latitude

Longitude

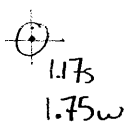


Topo Location

7.5' Loc. _____ 15' Loc. _____
 _____ (calc.) _____

Company Valley Oil & Gas Co
 Farm Uriah Ice #1
 15' Quad _____
 (sec.) _____
 7.5' Quad Porters Falls
 District GREEN

WELL LOCATION PLAT

County 103 Permit 30043

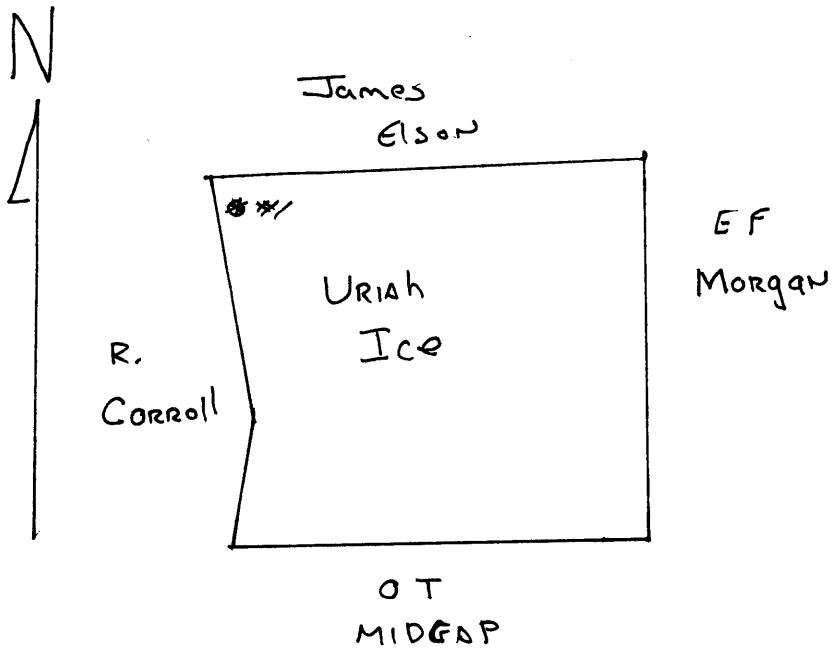

Green District, Wetzel County, W. Va.

By Valley Oil & Gas Co., New Martinsville, W. Va. (O. T. Miscoop, Mgr.)

On 26 1/2 acres, surface and minerals owned by Uriah Ice,

New Martinsville, W. Va.

Abandoned under permit #2-43.

Elevation, 1285' D.

10" casing, 234'; 8", 1890'; 6", 2222'.

Coal was encountered at 1073-1074'. No liners used.

Abandonment reported to Dept. of Mines March 23, 1931.

NOTE: This well was drilled in 1928.

The above record was furnished us to plug the well by, by the
Lonestree Oil Co., of Marietta, Ohio, whom we bought the
well of to pull and plug. We have no complete record of this
well.

Well was shot at 2354-2363'.

Record to RCF from Mrs. Griffith Sept. 10, 1935.

	Top.	Bottom.	Thickness.
Pittsburgh Coal, black	1073	- 1074	1
Big lime	2200	- 2260	60
Keener Sand (gas)	2260	-	
(water, 2273')			
Big Injun Sand pay, 2354-2363'			
Total depth			2378