


30048

Center dist

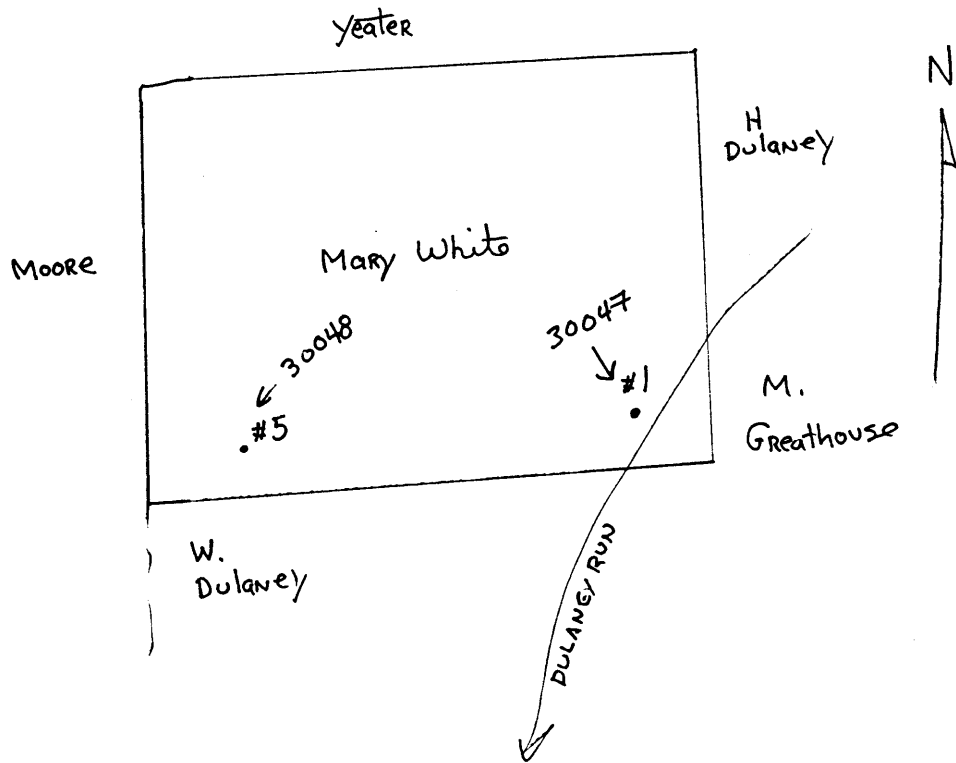

Center District, Wetzel County, W. Va.

By South Penn Oil Co., Box 1255, Pittsburgh, Pa.

On 8¹/₄ acres, surface owned by Mrs. Ross Dulaney, Pine Grove, W. Va.,
and mineral rights by Emma B. Huffman, Cairo, W. Va.

Elevation, 1265' L.

16' conductor; 10" casing, 550'; *H.P. 48 A* 8¹/₄" 1675'; 6-5/8" 2100';
5-3/16" 2590'.

Coal was encountered at 710 and 1160'.

Abandonment reported to Dept. of Mines May 7, 1931.

Well was shot (depth not known).

Producing hole.

	Top.	Bottom.
Conductor	0	16
Native coal	710	
Pittsburgh Coal	1160	
Dunkard Sand	1650	1700
Salt Sand	1925	2200
Pencil Cave	2310	2320
Big Lime	2320	2380
Big Injun Sand	2380	2610
50-Ft. Sand	2990	3020
Stray Sand (oil and gas, 3198')	3189	3218
Gordon Sand	3223	
Total depth		3238