


39° 32' 30"

Latitude

80° 35' 00"

Longitude

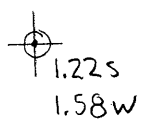

Topo Location

7.5' Loc. _____ 15' Loc. _____
 _____ (calc.) _____

Company South Penn Oil Co

Farm JM Anderson #1

15' Quad _____
(sec.)

7.5' Quad Big Run


District GRANT

WELL LOCATION PLAT

County 103 Permit 30050

30050

Grant

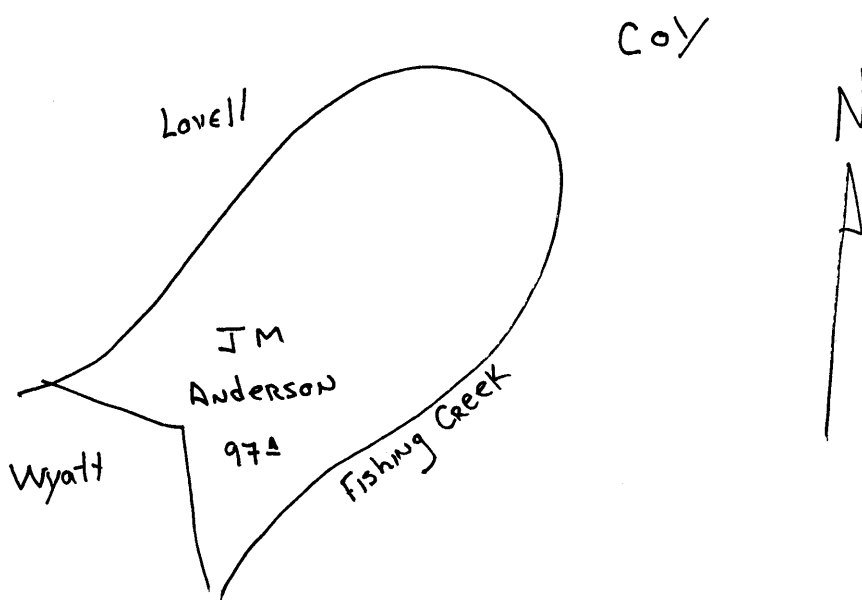

J. M. ANDERSON NO. 1 WELL.

No. 264 O.F.-Wetzel.

Wet - ~~133~~ 50-A

Same as No. 3 O.F.-Wetzel.

Grant District, Wetzel County, W. Va.

By South Penn Oil Co., Box 1255, Pittsburgh, Pa.

On 97 acres, surface owned by R. B. Anderson, Jacksonburg, W. Va.,

and mineral rights by R. D. Henthorn, Jacksonburg, W. Va.

Elevation, 316' L.

10" casing, 265'; 8 $\frac{1}{2}$ " , 1125'; 6-5/8" , 1855'.

Coal was encountered at 580'.

Abandonment reported to Dept. of Mines June 8, 1931.

Well was shot twice (depth unknown).

Oil well.

	Top.	Bottom.	Thickness.
Pittsburgh Coal	580		
Dunkard Sand	1125		
Salt Sand	1380	1440	60
Pencil Cave	1805	1825	
Big Lime	1825	1870	
Big Injun Sand	1870	2085	
Gordon Sand (oil at 2675 and 2680')	2652		
Total depth		2695	

Gaut.....District, Wetzel County, W. Va.
By U. S. Oil Co.

1.6+ mi, S.E. of Jacksonburg, on Fishing creek-

	Top.	Bottom.
Pittsburgh Coal	580	585
Dunkard Sand	1125	1175
Salt Sand	1380	1430
Little Lime	1785	1805
Pencil Cave	1805	1825
Big Lime	1825	1870
Big Injun Sand (gas, 1980')	1870	2085
Red rock	2510	2550
Gordon Sand (oil, 2675 and 2680')	2652	2680
Total depth		2695