

39° 37' 30"

Latitude

103° 42' 08"

Longitude

+ 1.135
.53w

Topo Location

7.5' Loc. _____ 15' Loc. _____
_____ (calc.) _____

Company Manufact Lt & Ht

Farm H. D. GARNER #1963

15' Quad _____
(sec.)


7.5' Quad Glover Gap

District Church

WELL LOCATION PLAT

County 103 Permit 30051

30051
church dist

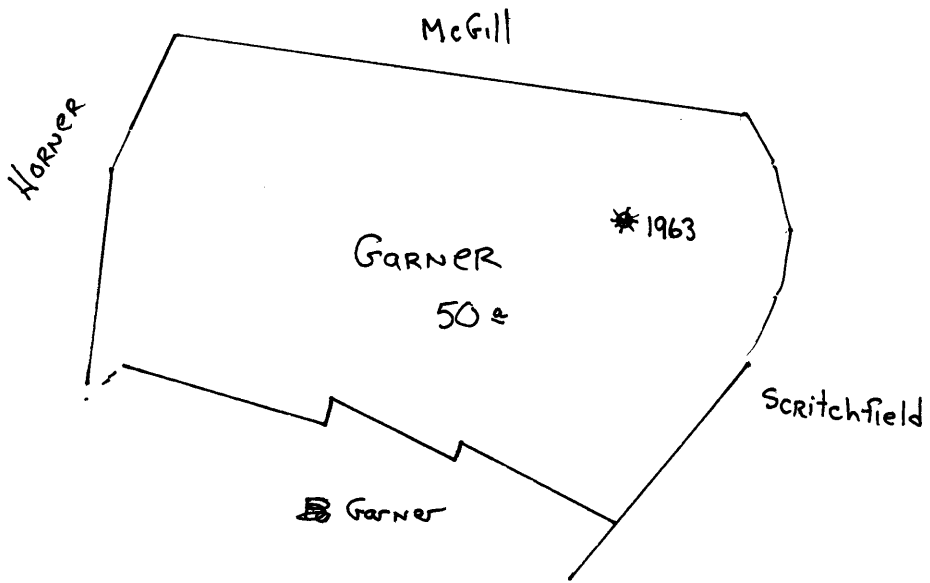

Church District, Wetzel County, W. Va.

By The Manufacturers Light & Heat Co., 800 Union Trust Bldg.,
Pittsburgh, Pa.

Abandoned under permit Wet-51.

On 50 acres, surface owned by Henry D. Garner et al., Barnshaw,
W. Va., and minerals by The Manufacturers Light & Heat Co.,
Pittsburgh, Pa.

Drilled prior to June 1, 1929 (date permits required).

Elevation, 1280' B.

13" conductor, 16'; 8 $\frac{1}{2}$ " casing, 1480'; 6 $\frac{5}{8}$ ", 2240'; 4" tubing, 2227'.
Packer, 4 x 6 $\frac{5}{8}$, set at 2225'.

Coal was encountered at 605-607, 924-929, and 1020-1027'.

Abandonment reported to Dept. of Mines June 10, 1931.

Gas well. Record to RCF from Mrs. Griffith Sept. 10, 1938.

	Top.	Bottom.	Thickness.
Clay, slate, and lime	0	295	295
Coal	605	607	2
Mapletown (Sewickley) Coal	924	929	5
Pittsburgh Coal	1020	1027	7
Sand	1200	1218	18
Sand	1435	1470	35
Sand	1505	1520	5
Dunkard Sand	1525	1580	55
1st Salt Sand (1 bailer water per hour at 1820')	1800	1890	90
2nd Salt Sand	1990	2065	75
Marion Sand (gas at 2179 and 2195'; test, 4/10ths water in 2")	2154	2222	68
Big Lime	2222	2310	88
Big Injun Sand (little gas at 2316')	2310	2485	175
Squaw Sand	2490	2500	10
50-Ft. Sand	2995	3018	23
30-Ft. Sand (shells)	3045	3072	27
Gordon Stray Sand (little shelly)	3072	3108	31
Gordon Sand (little gas at 3128')	3125	3188	63
Fourth Sand (gas at 3227'; test, 4/10ths Mercury in 2")	3205	3238	33
Bayard Sand	3440	3452	12
Slate and lime	3452	3619	167
Total depth		3619	