

Latitude

+
0.87s
1.47w

Longitude

Topo Location

7.5' Loc. _____ 15' Loc. _____
_____ (calc.) _____

Company South Penn Oil Co

Farm M P Dye #9

15' Quad _____
(sec.)

7.5' Quad Folsom


District GRANT

WELL LOCATION PLAT

County 103 Permit 30059

30059

Grant

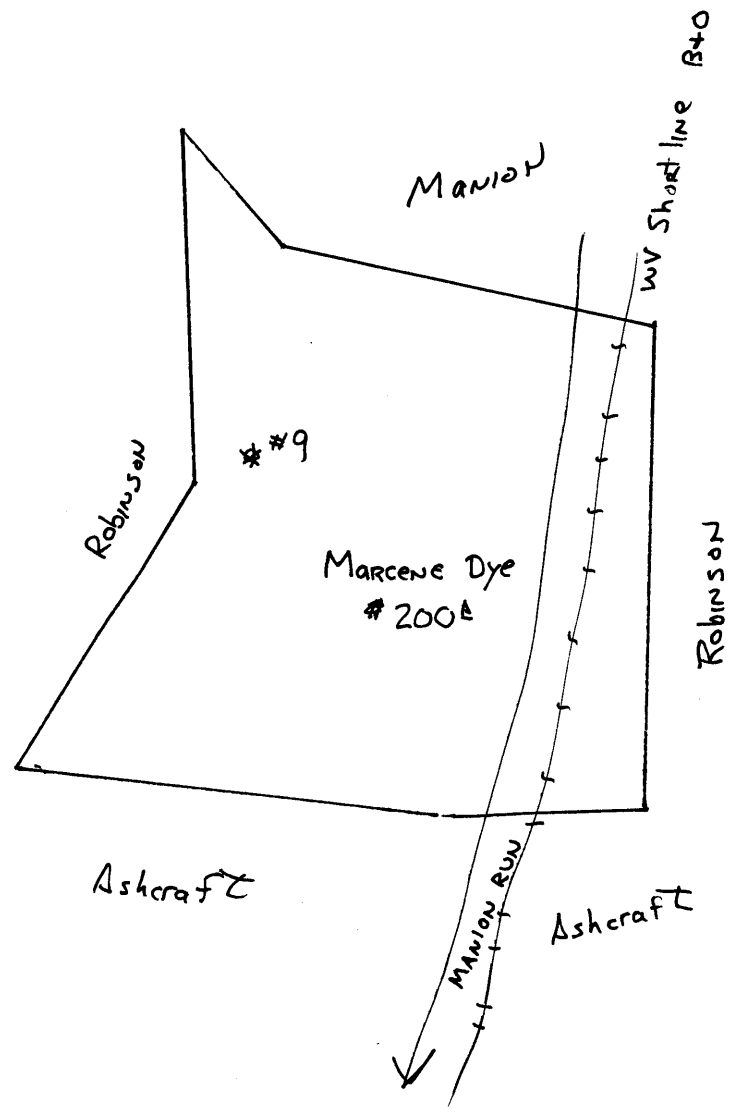

Grant District, Wetzel County, W. Va.
 By South Penn Oil Co., Box 1255, Pittsburgh, Pa.
 On 200 acres, surface and mineral rights owned by M. P. Dye,
 Williamstown, W. Va.

Elevation, 1405' L.

16' conductor; 10" casing, 298'; 8", 1687'; 6-5/8", 2435';
 5-3/16", 3096'.

Coal was encountered at 1213-1220'.

Abandonment reported to Dept. of Mines July 2, 1931.

Well was shot twice in Gordon Sand.

Water at 1725'.

Producing hole.

	Top.	Bottom.
Pittsburgh Coal	1213	- 1220
Big Dunkard Sand	1665	- 1680
Gas Sand (water, 1725')	1718	- 1760
Salt Sand	1930	- 2020
Salt Sand	2160	- 2240
Little Lime	2425	- 2431
Pencil Cave	2431	- 2434
Big Lime	2434	- 2497
Big Injun Sand	2497	- 2583
50-Ft. Sand	3087	- 3092
30-Ft. Sand	3165	- 3190
Gordon Stray Sand (gas, 3250-3252'; gas, 3260-3272')	3215	- 3282
Gordon Sand (oil, 3308')	3296	- 3316
Total depth		3328

WET-59-A