

Latitude

+
.615
1.21w

Longitude

Topo Location

7.5' Loc. _____ 15' Loc. _____
_____ (calc.) _____

Company SURE OIL & GAS

Farm LF GAIN #3


15' Quad _____
(sec.)

7.5' Quad Folsom

District GRANT

WELL LOCATION PLAT

County 103 Permit 30061

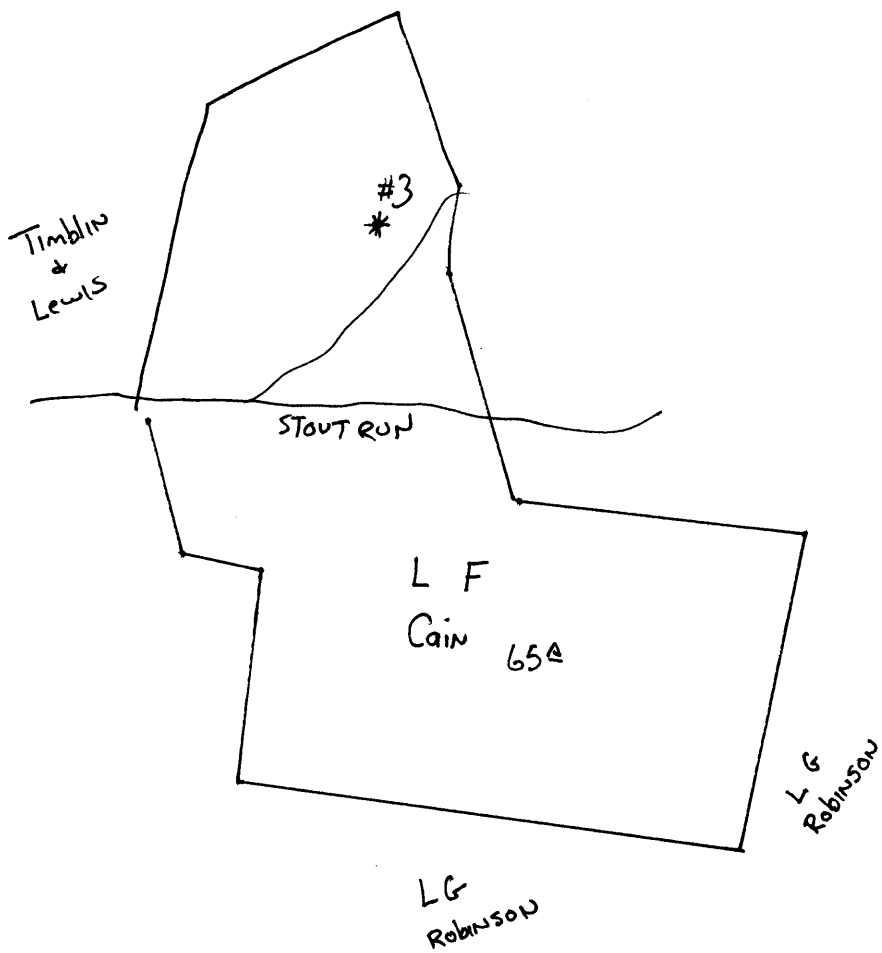

Grant District, Wetzel County, W. Va.

By Sure Oil & Gas Co., 511 Wooster St., Marietta, Ohio.

On 65 acres, surface and minerals owned by L. F. Cain (et al.),
last known address, New Concord, Ohio.

Elevation, 1040' B.

13" conductor, 20'; 6-5/8" casing, 2200'; 5-3/16", 2371'.

Coal was encountered at 890-896'.

240 ft. 4 1/2" liner set on bottom; do not expect to pull this.

Abandonment reported to Dept. of Mines Aug. 22, 1931.

Well was shot at 2980 and 3040'.

No water in oil sands.

Producing hole.

WET-61-A

	Top.	Bottom.	Thickness.
Pittsburgh Coal	890	- 896	6
Dunkard Sand	1294	- 1319	25
Salt Sand (little water)	1654	- 1704	50
Big Lime	2200	- 2270	70
Big Injun Sand	2270	- 2390	120
50-Ft. Sand	2798	- 2848	50
Gordon Stray Sand (oil and gas)	2978	- 2998	20
Gordon Sand (oil and gas)	3036	- 3044	8