


Pass, R175 Co Rept 30066

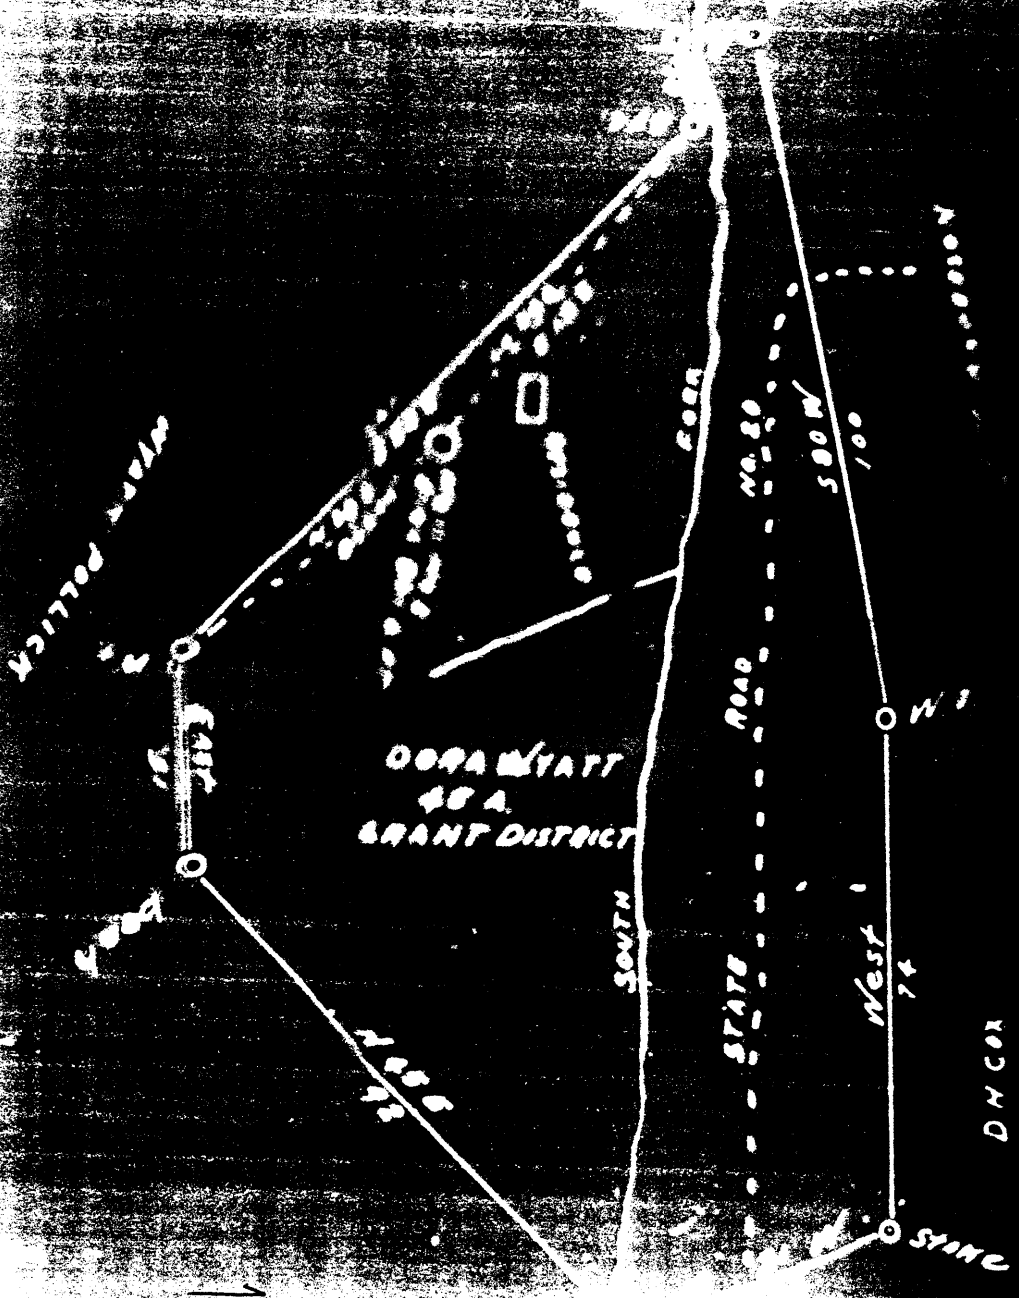

W 87 - 66 - A

Grant District, Netzel County, W. Va.
By Standard Pipe & Supply Co., Marietta, Ohio. (H.H. Beron).
On 45 acres (corrected), on South Fork of Big Fishing Creek;
surface and minerals owned by Dora Wyatt, Jacksonburg, W. Va.
Drilled in 1910.

Elevation.....

16" conductor, 16"; 6" casing, 2097'.

Coal was encountered at 609'.

Abandonment reported to Dept. of Mines Oct. 19, 1931.

Record to ROT from Mrs. Griffith Sept. 10, 1938.

	Top.	Bottom.	
Pittsburgh Coal		609	(top?)
Big Linc		1875	(top?)
Big Injun Sand	1926	1941	
Gordon Stray Sand	2702	2717	
Gordon Sand	2717	2739	
Total depth		2740	