

39° 37' 30"

80° 35' 00"

Latitude

Longitude

2.57s
.87w


Topo Location

7.5' Loc. _____ 15' Loc. _____
(calc.) _____

Company Hope Natural Gas
Farm LT Higgins # 6123
15' Quad _____
(sec.)
7.5' Quad Big Run
District GRANT

WELL LOCATION PLAT

County 103 **Permit** 30078

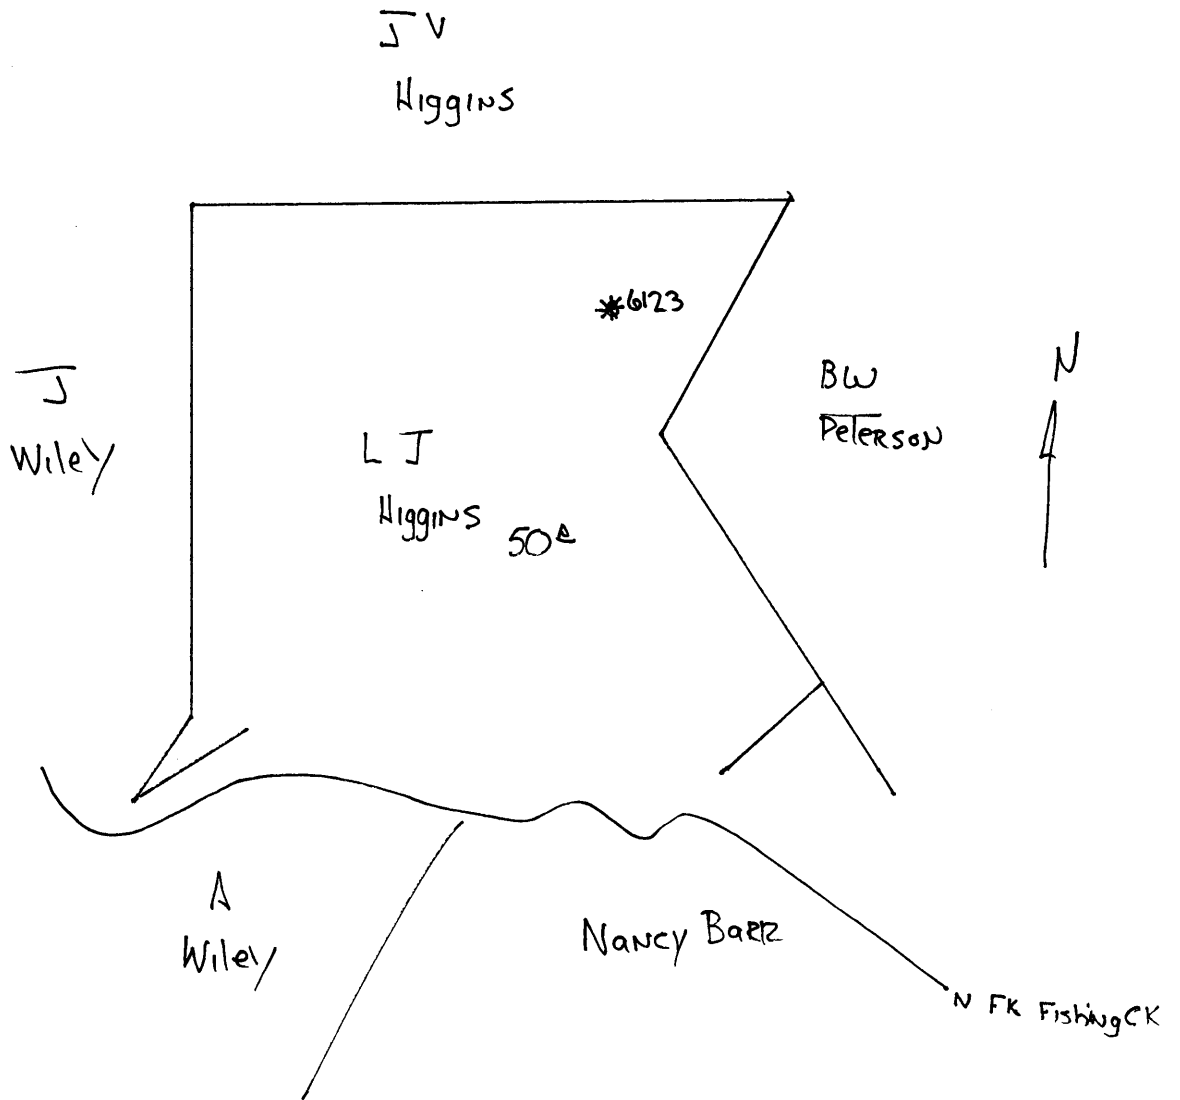

~~LIZZY CREEK~~ NO. 6123 WELL.

(L. J. Higgins Heirs)

No. 680 O.P.-Wetsel.
(AB. PERMIT WET-78).

Grant District, Wetsel County, W. Va.

By Hope Natural Gas Co., 445 W. Main St., Clarksburg, W. Va.

Abandoned under permit Wet-78.

On 57 acres, surface owned by L. J. Higgins Heirs, Littleton,
W. Va.; owner of minerals, unknown.

Elevation, 998' L.

10" casing, 142'; 8" casing, 1244'; 6" casing, 1909'; 5" casing, 2729'.

Coal was encountered at 216-220 and 695-700'.

Abandonment reported to Dept. of Mines March 2, 1932.

Well was shot at 2763-2768'.

Fresh water not recorded; salt water at 1450-1520'.

Gas well. Now exhausted to extent of not being commercially
productive.

Record to RCF from Mrs. Griffith Sept. 10, 1938.

	Top.	Bottom.	Thickness.
Native coal	216	- 220	4
Pittsburgh Coal	695	- 700	5
Little Dunkard Sand	1095	- 1115	20
Big Dunkard Sand	1229	- 1260	31
Gas Sand	1305	- 1350	45
First Salt Sand (water, 1450-1520')	1445	- 1500	55
Maxton Sand	1818	- 1826	8
Little Mine	1840	- 1857	17
Pencil Cave	1857	- 1866	9
Big Mine	1866	- 1932	66
Big Injun Sand	1932	- 2165	233
Gordon Stray Sand	2722	- 2733	11
Gordon Sand (gas, 2764-2768')	2735	- 2773	38
Total depth		2896	