80°45′00″

Latitude

.275 1.73w

Topo Location

7.5' Loc.\_\_\_\_\_\_ 15' Loc.\_\_\_\_\_ (calc.)

Company Manufact H+H

Farm Evan: + Annie Morgen # 1878


15' Quad \_\_\_\_\_\_\_(sec.)

7.5' Quad Forers Falls

District Green

WELL LOCATION PLAT

County 103 Permit 30088

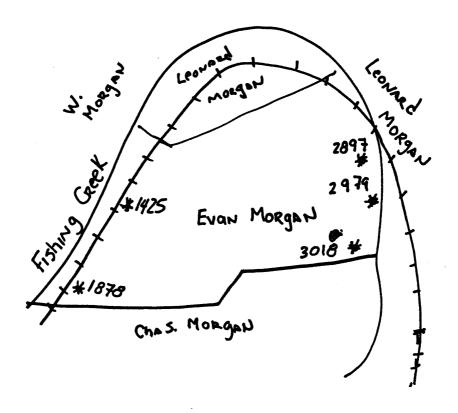

Now F.B. Jones

## EVAN AND ANNIE MORGAN NO. 1878 WELL.

060-640

No. 301 O.F .- Wetzel.

Green District, Wetzel County, W. Va.

By The Manufacturers Light & Heat Co., 800 Union Trust Bldg., Pittsburgh, Pa.

On 121 acres, surface owned by Fvan and Annie Morgan, Porters Falls. W. Va., and mineral rights by ML&HCo., Pgh., Pa.

Drilled prior to June 1, 1929.

Wlevation, 1010' B.

10" casing, 23': 81", 1334': 6-5/8", 1957'.

Coal was encountered at 793-796 and 830-831'.

Abandonment reported to Dept. of Mines Aug. 23, 1932.

Well was shot Jan. 22, 1916, with 20 qts.; top shell, 2110', bottom, 2118'; good results.

Well was shot May 15, 1926, with 20 qts.; top 2116, bottom 2121'. Shot placed 115' in Big Injun Sand.

Producing hole.

	Top.	bottom.
Native coal	793	- 796
Pittaburgh Coal	830	- 531
Little Dunkard Sand	1195	- 1290
Big Dunkard Sand	1320	- 1375
Gas Sand	1432	- 1495
1st Salt Sami	1630	- 1675
2nd Salt Sam	1730	- 1745
Maxton Sand (little gas, 1882')	1852	- 1890
Pencil Cave	1890	- 1895
Big Lime	1918	- 2001
Big Injun Sand (oil and water, 2111-	• ,	
2116'; Keener gas and oil, 2016'	) 20(	01 -
Total depth		5155

WET-SS-A