



30116


Loc. No. 1001

Located in Shrub

in Tract

West Virginia, Huntington H. T. Quadrangle

April 17th 24 Date 1000' Elevation 3' + 800' Scale 1" = 100'

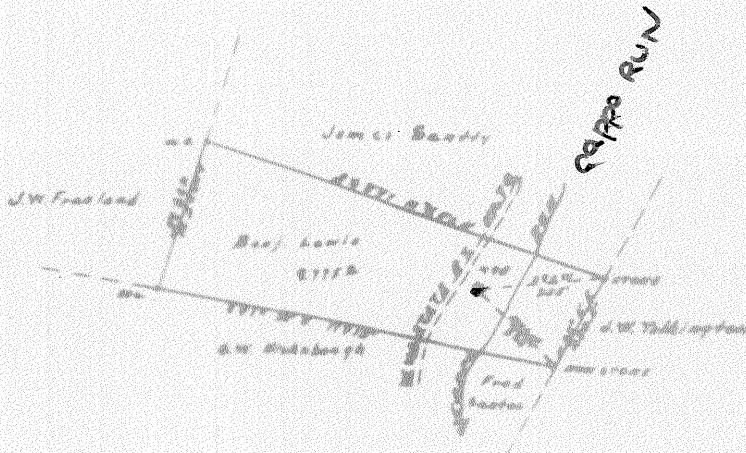

#1-495

I, the undersigned, hereby certify that this map is correct and shows all the information to the best of my knowledge and belief, required by the oil and gas section of the Mining Laws of West Virginia.

D. P. Ritten Engineer.

State of West Virginia

3.3



PLUGGING AND FILLING WELLS  
 DEPARTMENT OF MINES  
 WEST VIRGINIA DEPARTMENT OF MINES  
 OIL AND GAS DIVISION

W. A. B. Williams  
 COAL OPERATOR OR OWNER

NAME OF WELL OPERATOR

DR. ADDRESS, P.O.

CITY AND STATE

COMPLETE ADDRESS

COAL OPERATOR OR OWNER

WELL NO. 195

1934

WELL AND LOCATION

ADDRESS

PLUG

Date

COAL OPERATOR OR OWNER

Well No. 195

Count

ADDRESS

Ben Lewis

Fe

AFFIDAVIT TO BE MADE IN TRIPLICATE, ONE COPY TO BE MAILED BY REGISTERED MAIL TO THE DEPARTMENT, ONE COPY TO BE DELIVERED BY THE COAL OPERATOR AND THE THIRD COPY (AND EXTRA COPIES IF ADVISED) TO BE MAILED TO EACH COAL OPERATOR ABOVE NAMED AT THEIR RESPECTIVE ADDRESSES.

AFFIDAVIT

STATE OF WEST VIRGINIA,

COUNTY OF Wayne

David W. Kerr

and Samuel B. Masters

being first duly sworn according to law depose and say that they are experienced in the work of plugging

and filling oil and gas wells and were employed by Carnegie Natural Gas Company, well operator and participated in the work of plugging and filling the above well, that said work was commenced on the

with day of JUNE, 1934, and that the well was plugged and filled the following manner:

Manner in which said well was plugged: Total depth 3075'. Filled with clay to 1005'. Cemented from 1005' to 1765'. Filled with clay from 1765' to 180'. Split 6-5/8" casing at 1260' and pulled casing out. Filled with clay from 180' to 1175'. 8 1/2" solid wood plug set at 1175'. Filled with clay from 1175' to 1075'. 4 1/2" casing split at 1075' pulling out 1075'. Filled with clay from 1075' to 775'.

Manner in which coal was plugged:

Filled with cement from 775' to 710' this being 33' below the Pittsburg Coal and 28' above the Pittsburg Coal. Filled with clay from 710' to 674'. Filled with cement from 674' to 600' this being 40' below the Hapetown Coal and 30' above the Hapetown Coal. Filled with clay from 600' to top of surface.

Description of monument  
 INSCRIPTION

Site 21 X 11-6" X 11-2"  
 Carnegie Natural Gas Company, Ben Lewis  
 Well Number 195 July 1st, 1934.

THE ABOVE MENTIONED MUST BE IN DETAIL AND IN ACCORDANCE WITH THE PROVISIONS OF SECTION 10, ARTICLE 4, CHAPTER 26 OF THE CODE

and that the work of plugging and filling said well was completed on the 31st day of JUNE

1934

And further deposes with me

David W. Kerr  
Samuel B. Masters