2.825 062w

Topo Location

7.5' Loc._____ 15' Loc.____ (calc.)

Company Orndorff, McGaclenetal

Farm Charles Pyles #


15' Quad _______(sec.)

7.5' Quad Littleton

District CENTER

WELL LOCATION PLAT

County 103 Permit 30124

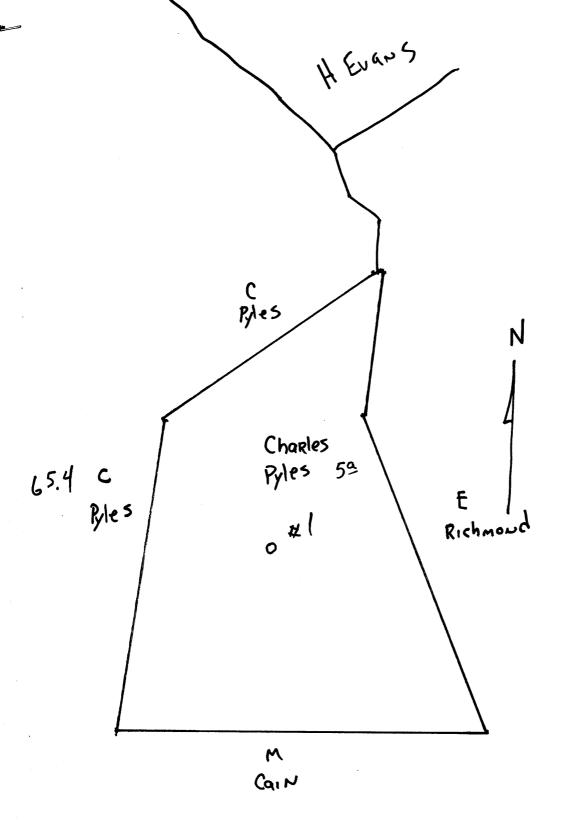

Center District, Wetsel County, W. Va.

By Orndorff, McCracken et al., Cameron, W. Va.

On 5 acres, surface owned by Malissa E. Pyles, Moundsville, W. Va.,

and mineral rights by William Stone, Uniontown, Pa.

Drilled in 1923.

Elevation.....

81" casing, 1500'; 6-5/8", 2108'. No liner used.

Coal was encountered at 625-628 and 1112-1117'.

Abandonment reported to Dept. of Mines Aug. 15, 1934.

Well was shot at 3177'. Salt water at 2055'.

Producing hole,

and the second of the second o	Top. Bottom. Thickness.	
Native coal	625 - 628 3	
Pittsburgh Coal	1112 - 1117 5	
First Salt Sand (water, 2055')	1990 - 2143 153	
Big Injun Sand (gas, 2325-2330')	2312 - 2552 240	
50-Ft. Sand (light showing of gas, 3139') Gordon Sand (light oil production,	3137 - 3151 14	
3177*) Total depth	3173 - 3180 7 3231	